


LATERAL 341, SOUTHWEST INTERCEPTOR SEWER
PROJECT NO. 468-82437 (742429)
BUILT BY NOWAK CONSTRUCTION CO.
BOOKED 11/20/95 AS PER PLAN

SCALE: 1" = 100'

mfp

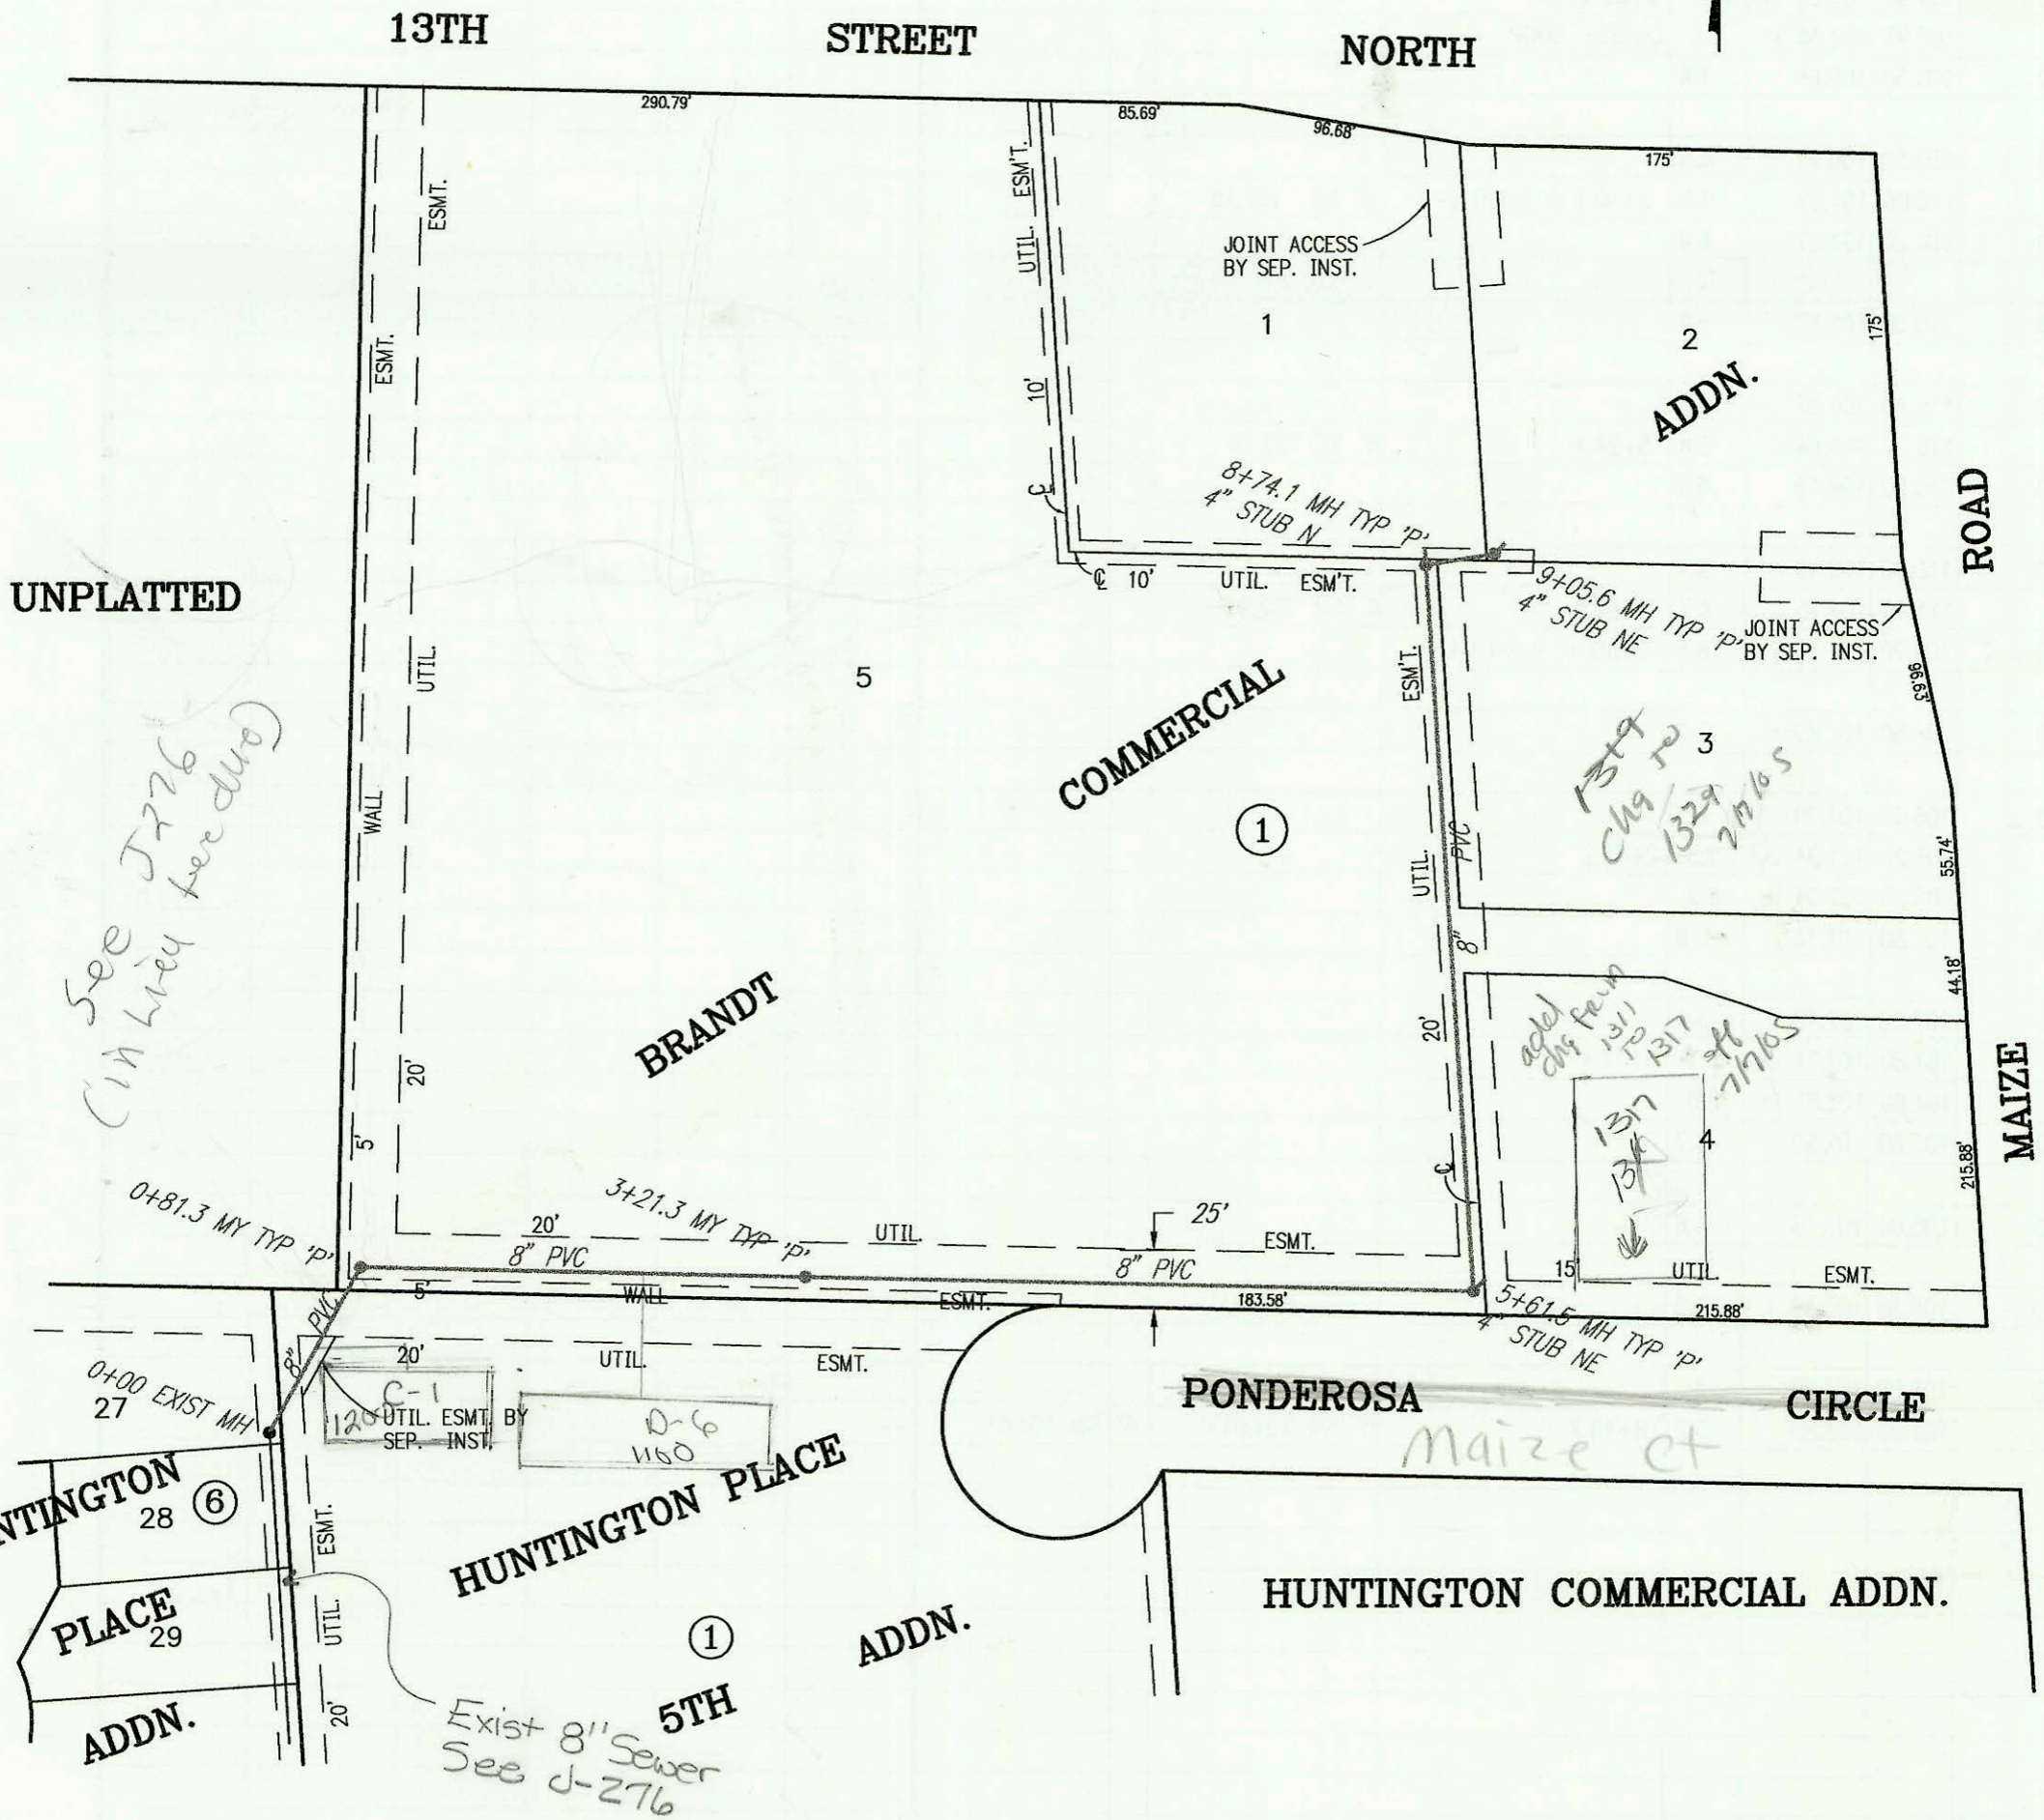

PRIVATE SANITARY SEWER TO SERVE TALLGRASS INN ADDN.
PRIV. PROJ. NO. 217 PPW (607853)
BUILT BY UTILITY CONTRACTORS, INC.
BOOKED 11-29-95 AS PER PLAN

SCALE: 1" = 150'

