


LATERAL 2, MAIN 17,
SOUTHWEST INTERCEPTOR SEWER
PROJECT NO. 468-82300 (742395)
BUILT BY UTILITY CONTRACTORS
BOOKED 1/9/96 PER PLAN

SCALE: 1" = 100'

pull Storm Book D 282 to check for Storm Lateral

Note
check storm sewer books as some lots have storm line on them and extra easements 5-24-96 BR

7834
2 houses on septic need fee in 21st r ease to cross 5' wall ease

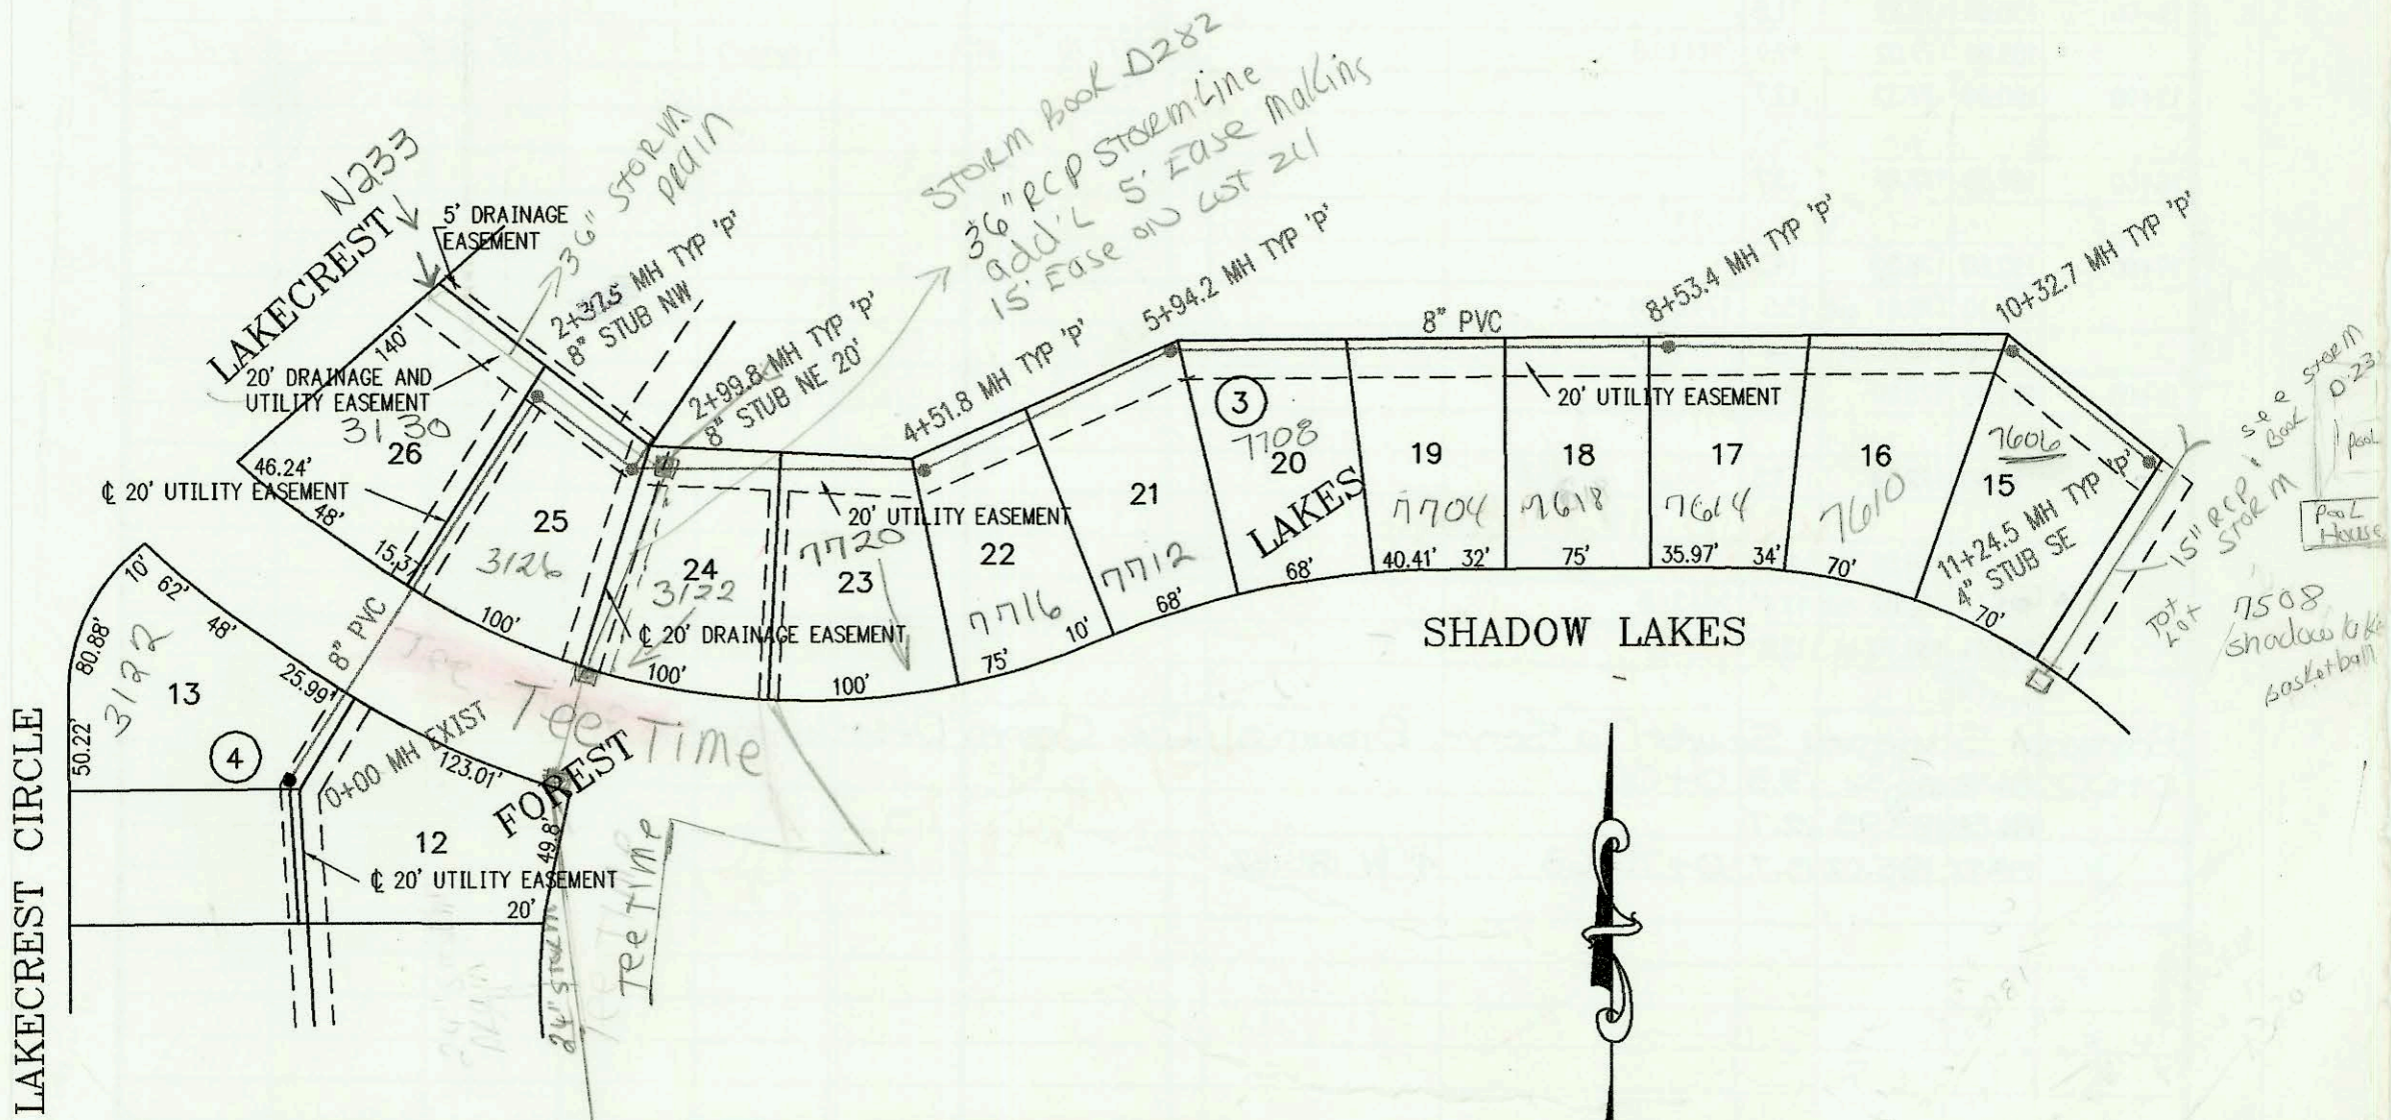

LATERAL 3, MAIN 17, SOUTHWEST INTERCEPTOR SEWER
PROJECT NO. 468-82301 (742403)
BUILT BY UTILITY CONTRACTORS INC.
BOOKED 1/9/96 PER PLAN

SCALE: 1" = 100'

see Storm Book D 282 for 15' RCP Storm M Pool House
Top Lot 1508 shadow lake basket ball

