


LATERAL 33, MAIN 12, SOUTHWEST INTERCEPTOR SEWER
 PROJECT NO. 468-82158 (742353)
 BUILT BY DONDLING AND SONS CONSTRUCTION CO.
 BOOKED 1/9/96 PER PLAN

SCALE: 1" = 100'

LATERAL 51, MAIN 9, SANITARY SEWER NO. 23
 PROJECT NO. 468-82501 (742411)
 BUILT BY W. B. CARTER CONSTRUCTION CO.
 BOOKED 1/9/96 PER PLAN

SCALE: 1" = 100'

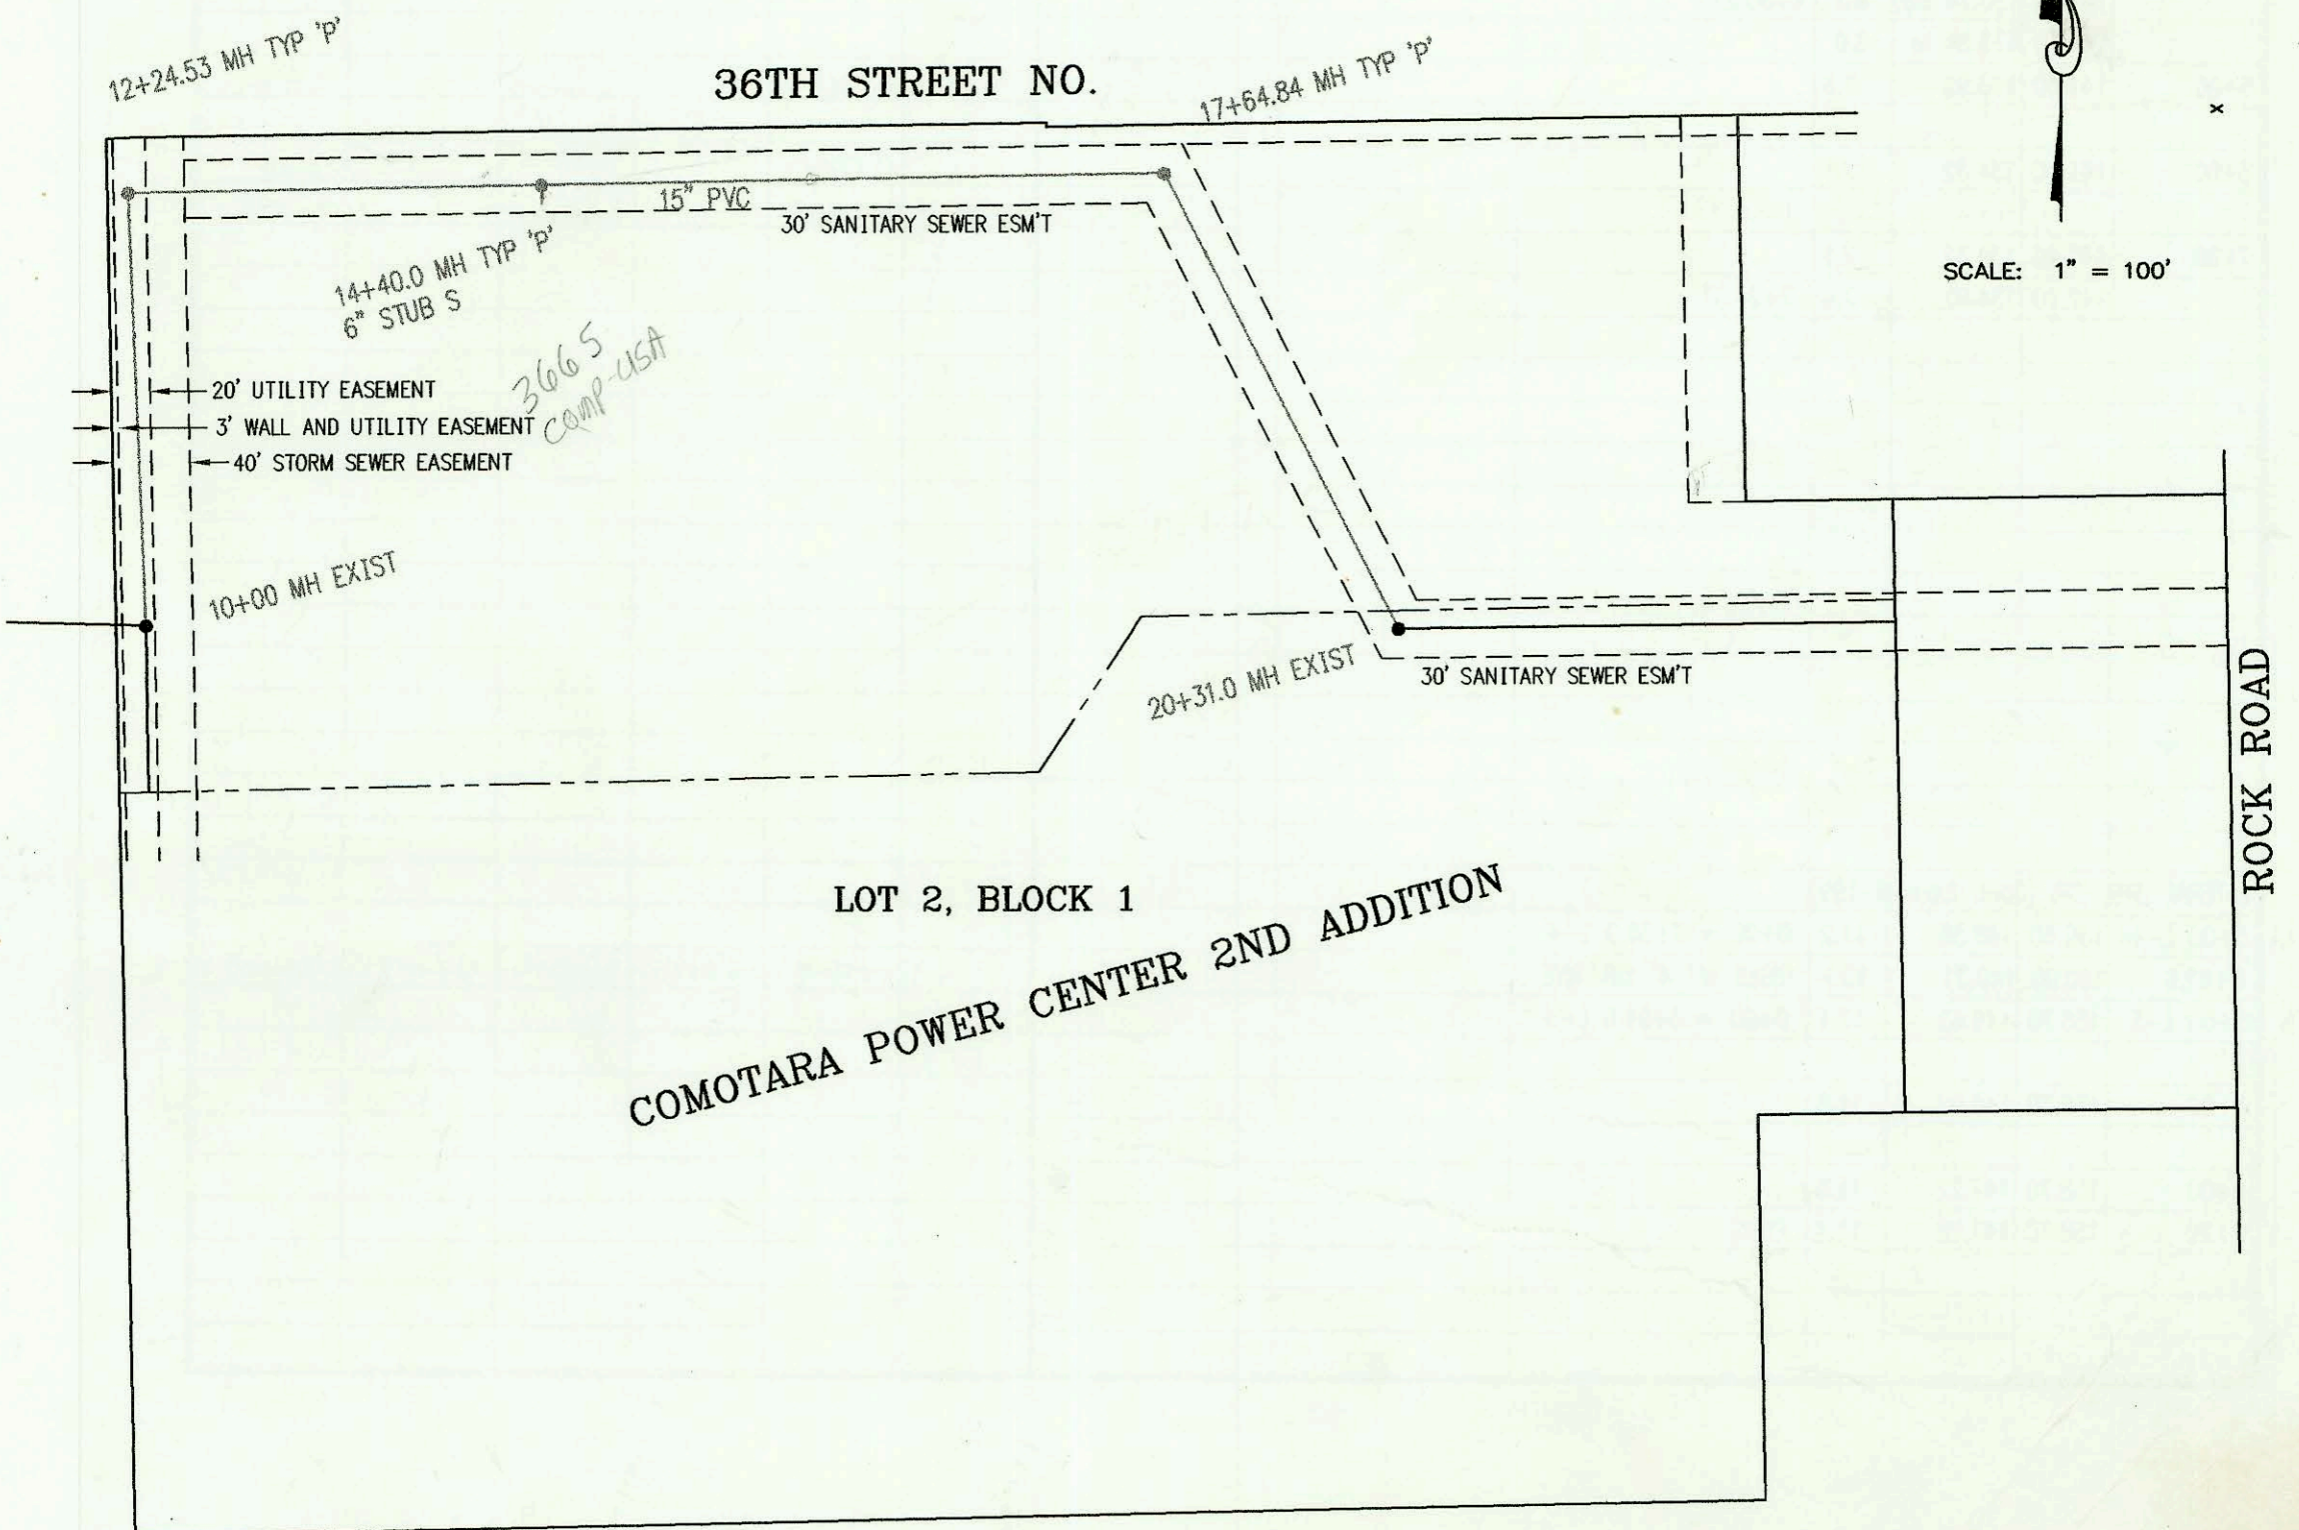

CONSTRUCTION RECORD						SERVICE RECORD						
STATION	ELEVATION		DEPTH	MANHOLE	4-INCH "Y" BRANCHES		No. of Permit		House Number		DATE OF PERMITS	
	GROUND	GRADE			North West	South East	North West	South East	North West	South East	North West	South East
LATERAL 33, MAIN 12, SOTHWEST INTERCEPTOR SEWER												
LINE 1	0+00	159.40	144.22	15.2	0+00 EXIST							
						4" sch 40 0+12	4" sch 40 0+06 4" S 151.4	97-29087		11316 Westport		2-25-97
							4" sch 40 0+15 4" S 151.4	97-26107		11320 Westport		5-21-97
		160.20	146.66	13.5	0+85.0							
	1+00	159.60	146.89	12.7								
	2+00	160.20	148.48	11.7				97-		1811 N Dennis Park		5-21-97
		161.20	149.34	11.9	2+54.0							
	3+00	160.90	149.62	11.3				97-29087		1812 N GRAY		2-25-97
	4+00	160.50	150.02	10.5				97-96667		11562 Westport		6-16-97
	5+00	161.30	150.42	10.9				96-31057		11506 Westport		7-6-96
		161.90	150.44	11.5	5+28.0 = 0+00 L-2			97-163407	96-27127	11507 Westport	11510 Westport	9-20-97 3-1-96
	6+00	161.80	150.73	11.1								
	7+00	161.60	151.13	10.5				98-37657	96-21187	11511 Westport	11514 Westport	3-2-98 2-12-96
		161.50	151.50	10.0	7+94.0	4" NW 151.84	4" SW 151.84	97-61457	96-21177	11515 Westport	11516 Westport	7-31-99 2-12-96
LINE 2	0+00 L-2	161.90	150.54	11.4	0+00 = 5+28.0 L-1			97-86137	96-9297	11519 Westport	11518 Westport	5-21-97 1-25-96
		162.40	152.70	9.7	0+66.0	4" NW 153.04	4" NE 153.04	97-181307	99-61467	11503 Westport	1815 GRAY	10-2-97 3-31-99
LINE 3	0+00 L-3	158.24	145.84 out	12.4	0+00 EXIST					1819 GRAY	1818 GRAY	4-19-99
		158.24	148.19 in	10.1						1818 GRAY	1818 GRAY	10-2-97
		160.10	148.52 out	11.6	0+82.1							
		160.10	148.62 in	11.5								
	1+00	159.90	148.69	11.2					3601-02333			7-20-01
		160.40	148.96 out	11.4	1+66.8			98-40307		1722 Shefford		1-9-97
		160.40	149.06 in	11.3								
	2+00	160.00	149.20	10.8				97-217887		11308 Westport		11-17-97
		160.70	149.40	11.3	2+51.4	4" N 149.74						
LATERAL 51, MAIN 9, S. S. NO. 23												
	10+00	188.60	174.70 out	13.9	10+00 EXIST							
		188.60	174.80 in	13.8								
	11+00	189.00	175.26	13.7								
	12+00	188.50	175.73	12.8								
		188.00	175.85 out	12.1	12+24.53							
		188.00	175.95 in	12.1								
	13+00	187.80	176.33	11.5								
	14+00	188.60	176.82	11.8								
		189.90	177.02	12.9	14+40.0							
	15+00	190.00	177.32	12.7				97-88297		3665 Rock Ed		6-2-97
	16+00	191.50	177.82	13.7								
	17+00	192.60	178.32	14.3								
		194.10	178.61 out	15.5	17+64.84							
		194.10	178.71 in	15.4								
	18+00	191.90	178.89	13.0								
	19+00	190.90	179.39	11.5								
	20+00	191.20	179.89	11.3								
		192.11	180.02 out	12.1	20+31.0							
		192.11	180.10 in	12.0								
Private Sanitary Sewer To Serve Braum's Ice Cream Development												
	0+00	196.58	183.32 out	13.3	0+00							
		196.58	183.93 in	12.7								
		198.72	185.02	13.7	0+75.68	4" W 185.32		96-34917		3041 W Rock Ed		3-18-96