



LATERAL 37, MAIN 12, SOUTHWEST INTERCEPTOR SEWER
 PROJECT NO. 468-82487 (742536)
 BUILT BY NOWAK CONSTRUCTION CO.
 BOOKED 4/12/96 PER PLAN

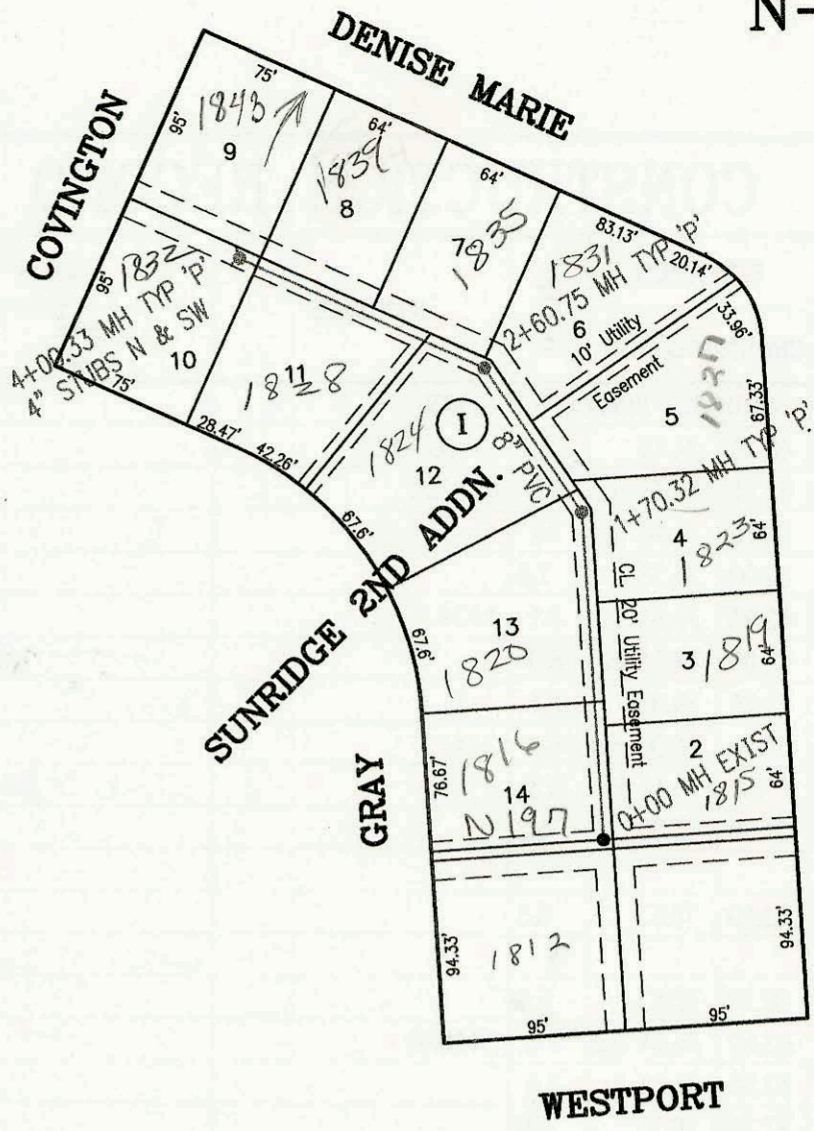

SCALE: 1" = 100'

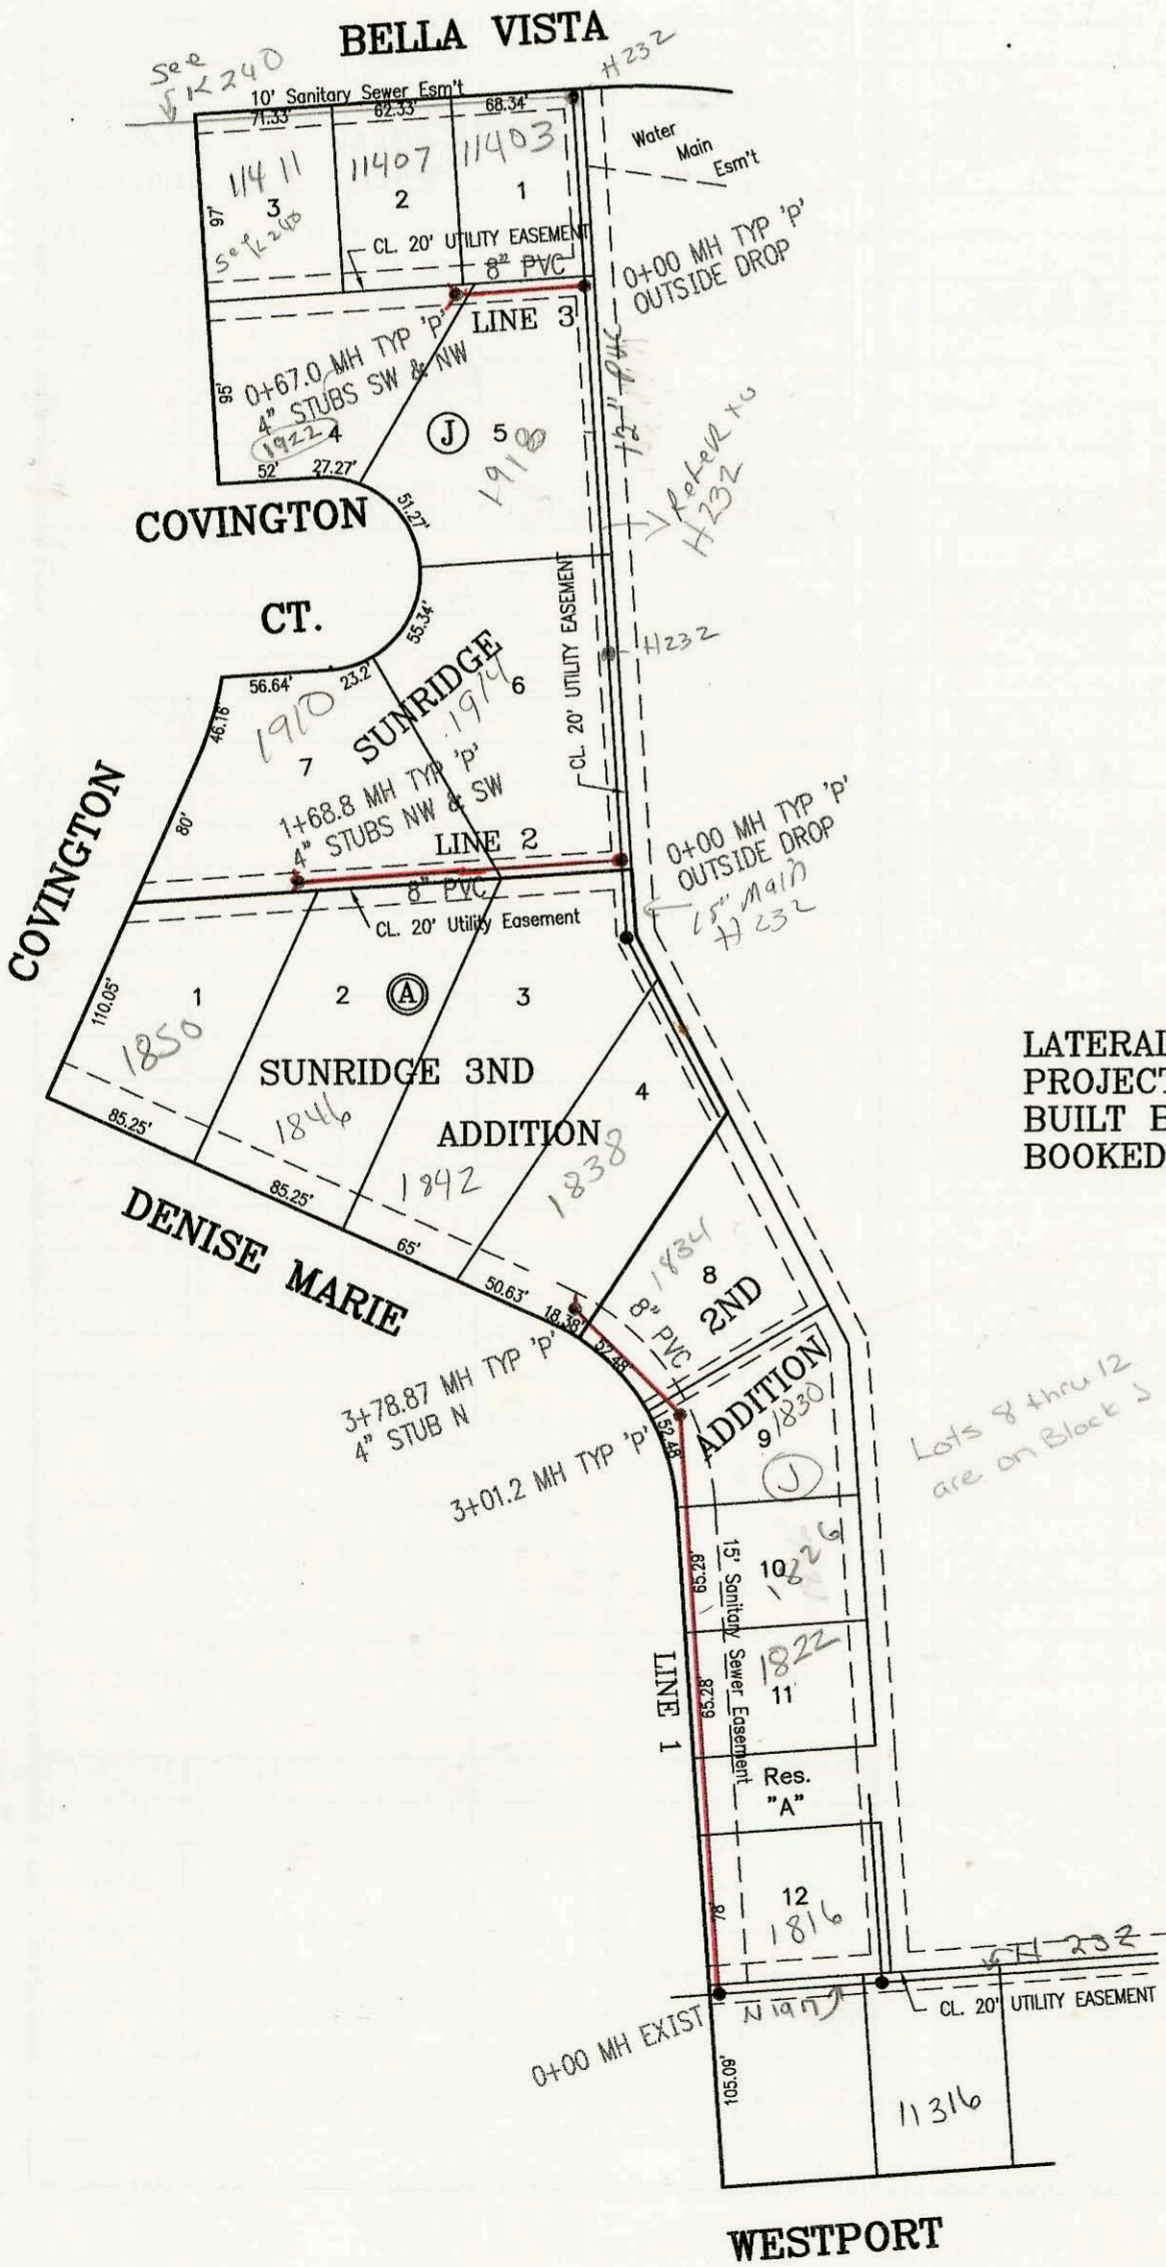

CONSTRUCTION RECORD						SERVICE RECORD						
STATION	ELEVATION		DEPTH	MANHOLE	4-INCH "Y" BRANCHES		No. of Permit		House Number		DATE OF PERMITS	
	GROUND	GRADE			North West	South East	North West	South East	North West	South East	North West	South East
LATERAL 37, MAIN 12, SOUTHWEST INTERCEPTOR SEWER												
0+00	161.20	149.44	11.8	0+00 EXIST			98-384-7	97-	1816 GRAY	1815 DENISE MARIE	1-8-98	11-7-97
1+00	161.10	149.84	11.3		1+24.7 4" sch 40		96-546-7	97-1864-7	1820 GRAY	1819 DENISE MARIE	4-17-96	7-8-97
	161.70	150.12 out	11.6	1+70.32				97-1425-7	1823 DENISE MARIE	1822 DENISE MARIE		8-8-97
	161.70	150.22 in	11.5					97-	1827 DENISE MARIE			5-24-97
2+00	161.10	150.34	10.8		2+39.8 4" sch 40		96-701-7		1854 GRAY		4-30-96	
	161.80	150.58 out	11.2	2+60.75	2+54.8 4" sch 40		96-552-7		1855 DENISE MARIE		4-17-96	
	161.80	150.68 in	11.1				97-1634-7		1835 DENISE MARIE		9-17-97	
3+00	161.50	150.84	10.7				97-1634-7		1834 DENISE MARIE		9-17-97	
	161.40	151.24	10.2	4+00.33	4" N 151.58	4" SW 151.58	97-1637-7	98-3617-7	1843 DENISE MARIE	1828 GRAY	9-7-97	3-3-98
LATERAL 38, MAIN 12, SOUTHWEST INTERCEPTOR SEWER												
LINE 1 0+00 L-1	160.20	146.76	13.4	0+00 EXIST				96-1240-7		1816 DENISE MARIE		7-31-96
1+00	159.80	147.79	12.0							1822 DENISE MARIE		5-21-96
2+00	160.00	148.81	11.2		1+57.0 4" sch 40		96-7660-7		1826 DENISE MARIE		5-21-97	
					2+00.0 4" sch 40		97-861-7		1830 DENISE MARIE			
3+00										1830 DENISE MARIE		5-1-96
	160.40	149.86 out	10.5	3+01.2				96-6249-7		1834 DENISE MARIE		3-31-97
	160.40	149.96 in	10.4					97-4887-7				
	160.60	150.27	10.3	3+78.87	4" N 150.61		98-9939-7		1858 DENISE MARIE		5-21-98	
LINE 2 0+00 L-2	159.40	143.17 out	16.2	0+00 OUTSIDE DROP	0+16.0 4" sch 40		96-16598-7		1914 COUNSTON		10-4-96	
	159.40	148.50 in	10.9					97-7268-7		1842 DENISE MARIE		4-19-99
1+00	159.60	149.69	9.9					98-27465-7		1846 DENISE MARIE		11-9-98
	160.50	150.50	10.0	1+68.68	4" NW 150.84 4" SW 150.84		96-15467-7	98-22907-7	1910 COUNSTON	1850 DENISE MARIE	9-16-96	11-25-98
LINE 3 0+00 L-3	159.50	143.92 out	15.6	0+00 OUTSIDE DROP								
	159.50	149.00 in	10.5				97-701-7	96-15475-7	11403 BALLABISTA	1918 COUNSTON	1-15-97	9-16-96
	159.90	149.90	10.0	0+67.0	4" NW 150.24	4" SW 150.24 4" sch 40			96-15465-7	1924 COUNSTON		9-16-96