


LATERAL 119, WESTLINK SEWER
PROJECT NO. 468-82510 (742486)
BUILT BY W. B. CARTER CONSTRUCTION CO.
BOOKED 7/3/96 PER PLAN

SCALE: 1" = 100'

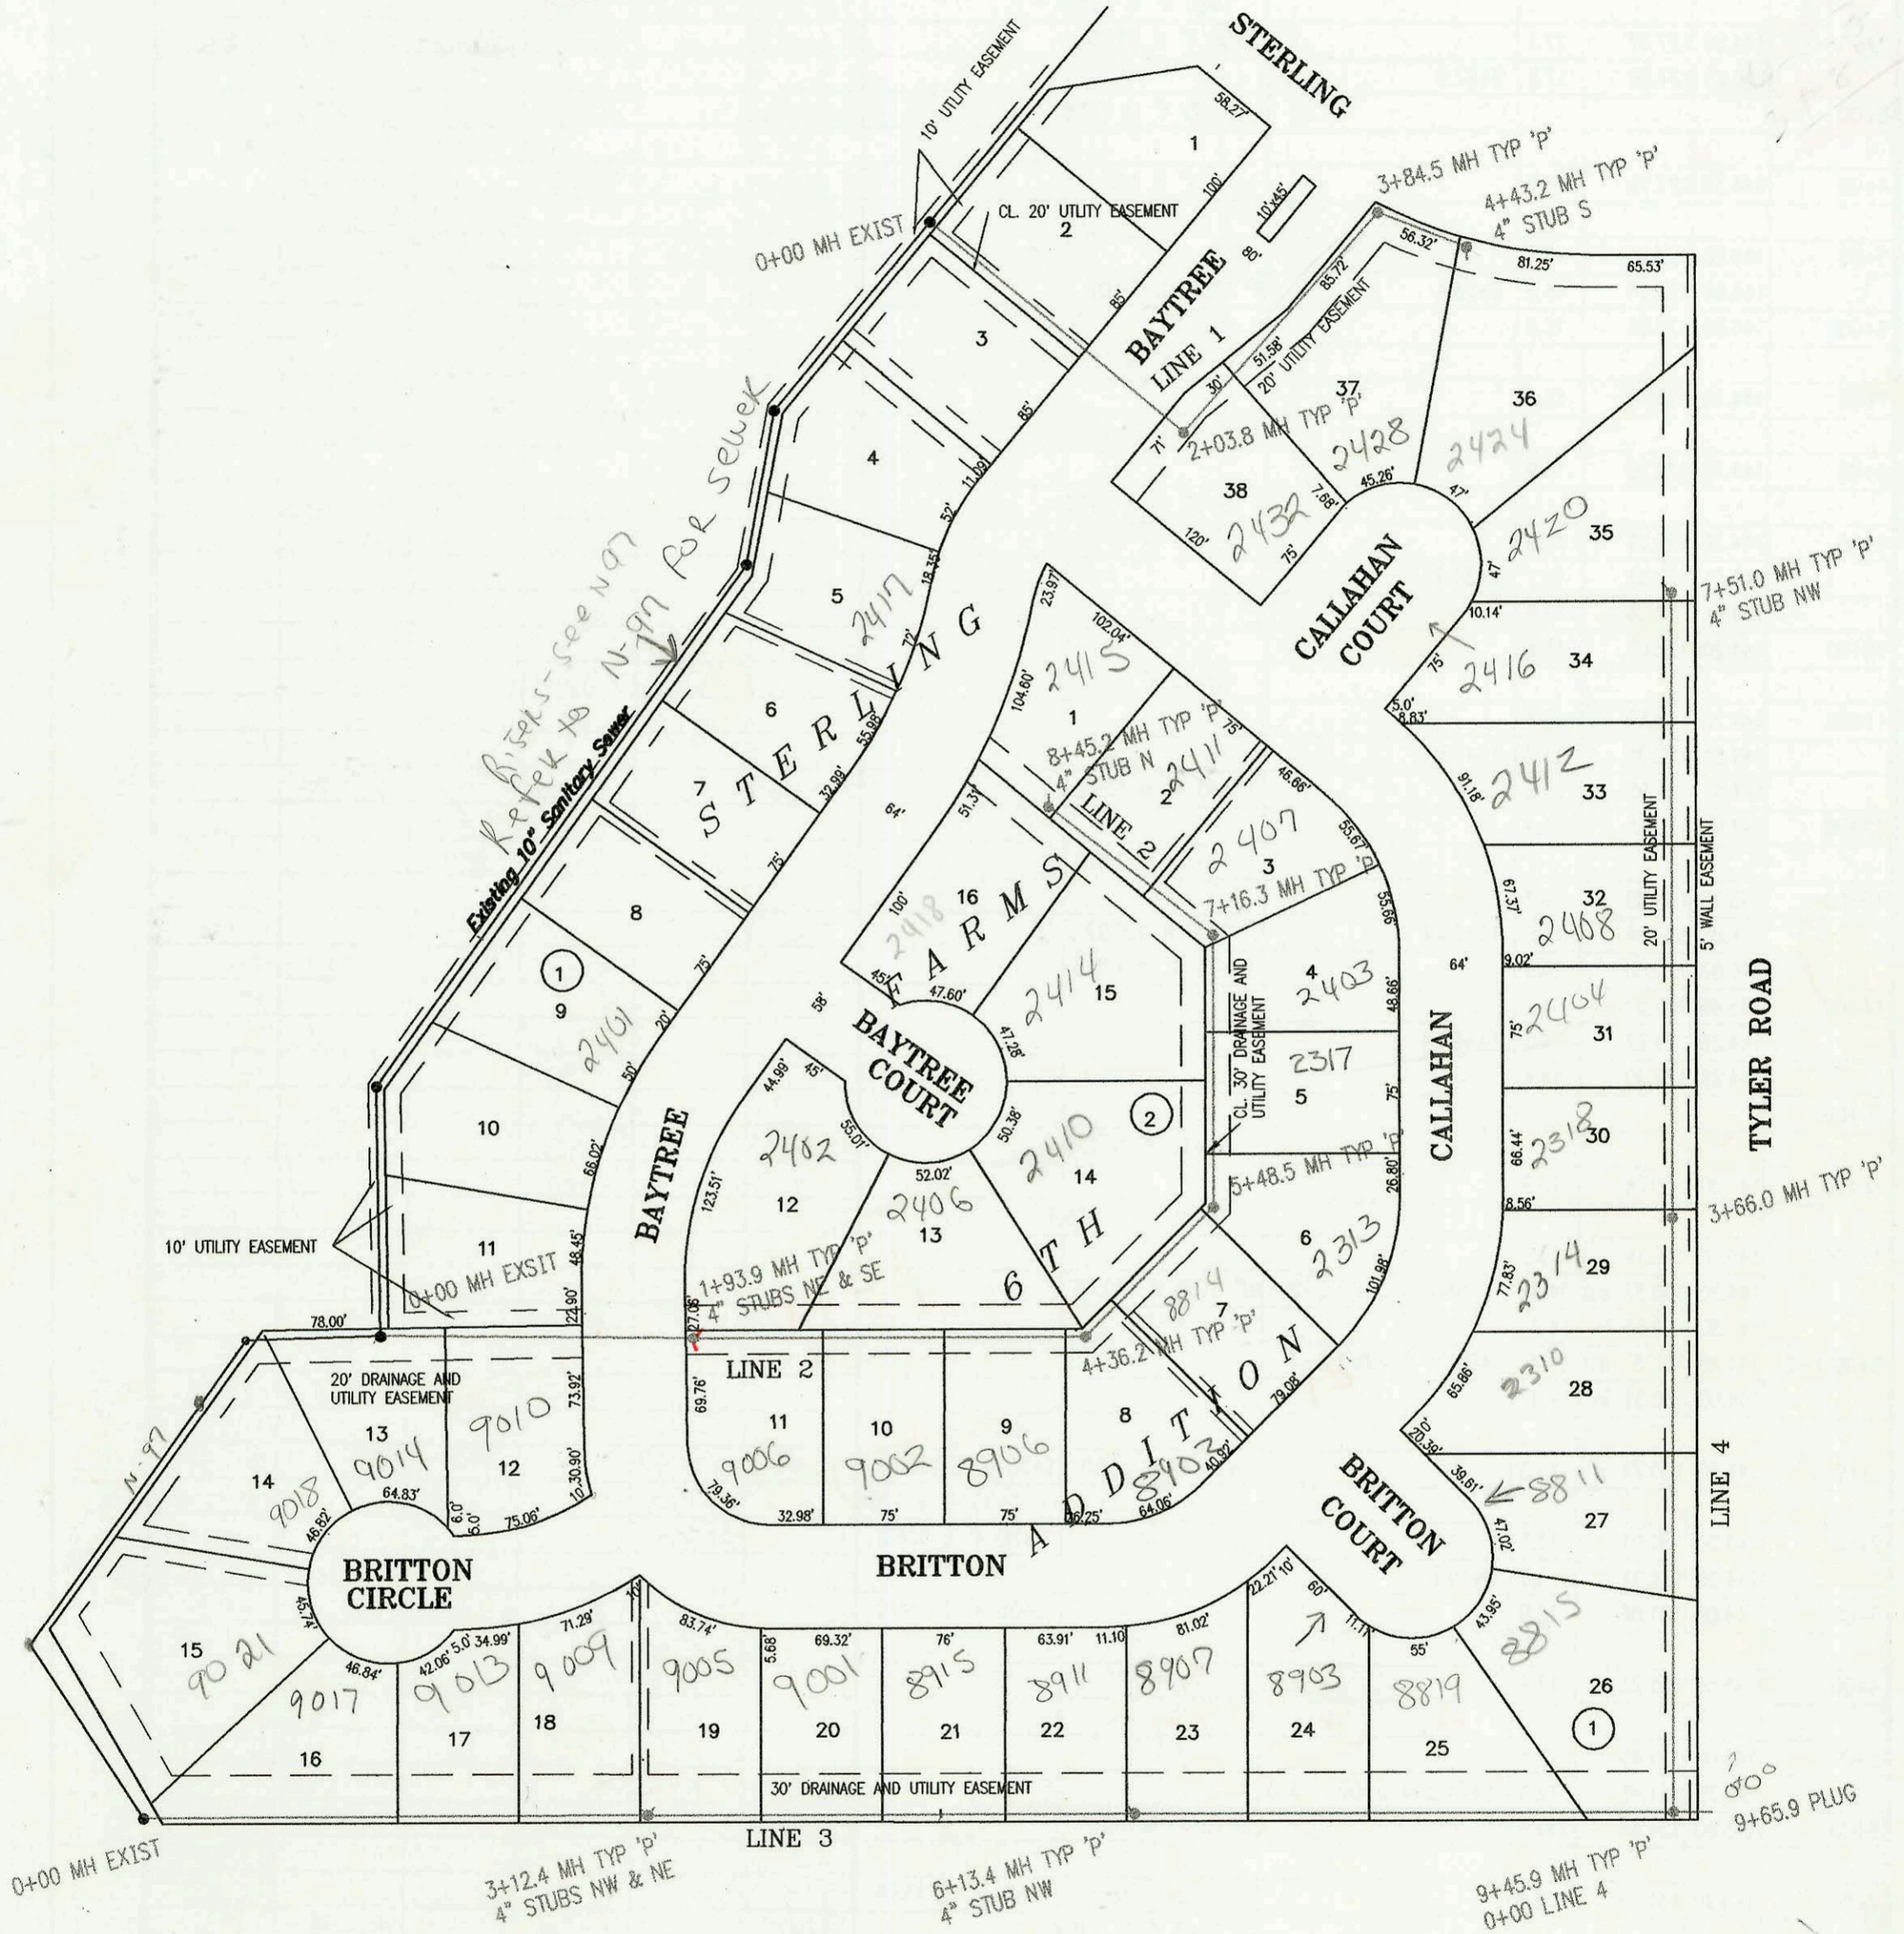

CONSTRUCTION RECORD						SERVICE RECORD						
STATION	ELEVATION		DEPTH	MANHOLE	4-INCH "Y" BRANCHES		No. of Permit		House Number		DATE OF PERMITS	
	GROUND	GRADE			North West	South East	North West	South East	North West	South East	North West	South East
LINE 1	LATERAL 119, WESTLINK SEWER											
	0+00 L-1	163.80	152.59	11.2	0+00 EXIST							
	1+00	165.20	153.53	11.7								
	2+00	165.80	154.50 out	11.3	2+03.8	4" sch 40 2411-8		96-12659-7	2432 Callahan Ct		8-1-96	
		165.80	154.60 in	11.2								
	3+00	165.60	154.98	10.6		3+06.5 sch 40		97-9753-7	2478 Callahan Ct		6-16-97	
	165.40	155.32 out	10.1	3+84.5								
	165.40	155.42 in	10.0									
	165.36	155.48	9.9									
	165.40	155.66	9.7	4+43.2		4" S 155.99 sch 40	96-12666-7	2424 Callahan Ct		7-31-96		
LINE 2	0+00 L-2	163.80	151.22	12.6	0+00 EXIST	4" sch 40 MH 5018		99-0151-7	2404 Britton		12-23-99	
	1+00	164.70	151.62	13.1		4" sch 40 MH 5018	96-1029-7	96-1029-7	2400 Britton		6-27-96	
		165.40	152.00 out	13.4	1+93.9	4" NE 154.00 sch 40	4" SE 154.00	96-1397-7	98-582-7	2402 Britton	8-22-96	7-12-98
		165.40	152.10 in	13.3								
	2+00	165.00	152.12	12.9								
	3+00	164.40	152.52	11.9		4" sch 40 3+23.2		96-12668-7	2406 Britton		8-2-96	
		163.70	152.92	10.8								
		163.65	153.06 out	10.6	4+36.2							
		163.65	153.16 in	10.5								
	5+00	164.40	153.42	11.0								
		163.65	153.61 out	10.0	5+48.5	5+56.6 sch 40		96-1935-7	97-1921-7	2410 N Britton	11-18-96	5-12-97
		163.65	153.71 in	9.9								
6+00	164.50	153.92	10.6									
	163.70	154.32	9.4									
	163.65	154.39 out	9.3	7+16.3		7+23.3 sch 40	97-90-7	2414 Britton		12-26-96		
	163.65	154.49 in	9.2									
8+00	164.40	154.82	9.6									
	163.65	155.00	8.6	8+45.2	4" N 155.33		97-4500-7	2415 Callahan		3-9-97		
LINE 3	0+00 L-3	162.60	150.28	12.3	0+00 EXIST	4" sch 40 1+75.7		2000- 00614	2401 Britton		3-8-00	
	1+00	163.00	150.68	12.3								
	2+00	163.10	151.08	12.0								
	3+00	164.20	151.48	12.7		SADDLE TAP 4" sch 40 2+64.0		2000- 00567	2409 Britton		3-2-00	
		164.60	151.53 out	13.1	3+12.4	4" NW 153.53	4" NE 153.53	98-357-7	2405 Britton		2-25-98	
	4+00	163.20	151.98	11.2								
	5+00	164.50	152.38	12.1		4" sch 40 4+92.4		2000- 00757	2415 Britton		3-23-00	
		164.00	152.78	11.2								
		163.90	152.83	11.1	6+13.4	TAP 6+21.4 4" NW 153.83 sch 40		98-3060-7	2407 Britton		2-25-98	
	7+00	163.90	153.18	10.7								
		164.40	153.58	10.8								
		163.30	153.98	9.3								
	166.00	154.16	11.8	9+45.9	8" N 154.26							
9+65.9	165.40	154.24	11.2	PLUG								
LINE 4	0+00 L-4	166.00	154.26	11.7	0+00 = 9+45.9 L-3		97-1684-7	2415 Britton Ct		9-12-97		
	1+00	165.00	154.66	10.3		1+46.0 sch 40	97-9229-7	2414 W Britton Ct		6-5-97		
	2+00	165.30	155.06	10.2			98-2084-7	2410 Callahan		12-17-98		
	3+00	165.30	155.46	9.8			98-217-7	2414 Callahan		1-7-98		
		166.60	155.72	10.9	3+66.0		99-6888-7	2418 Callahan		4-16-98		
	4+00	165.70	155.86	9.8								
	5+00	165.80	156.26	9.5		5+39.0 sch 40	98-1316-7	2404 Callahan		7-13-98		
		165.20	156.66	8.5		4" sch 40 6+14.0	96-2024-7	2408 Callahan		12-1-96		
	6+00	165.20	156.66	8.5			96-12665-7	2412 Callahan		9-31-96		
	7+00	165.60	157.06	8.5			97-1246-7	2419 Callahan		7-21-97		
	165.75	157.26	8.5	7+51.0	4" sch 40 4" NW 157.59		96-1176-7	2400 Callahan Ct		7-19-96		