



15" SANITARY SEWER MAIN TO SERVE BEL AIRE
PRIVATE PROJECT NO. 591 PPS (607861)
BUILT BY NOWAK CONSTRUCTION CO.
BOOKED 08/20/96 FROM AS BUILTS



SCALE: 1" = 150'

PARK
VISTA
ADDN.

UNPLATTED

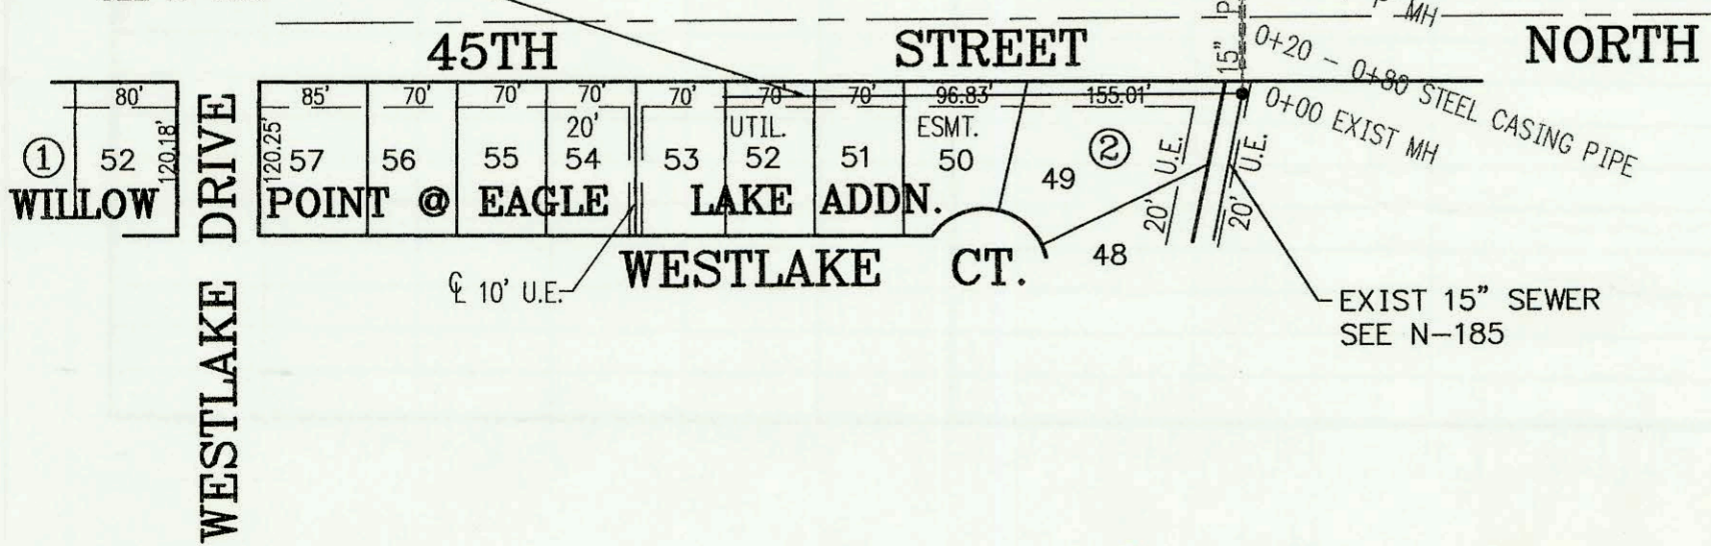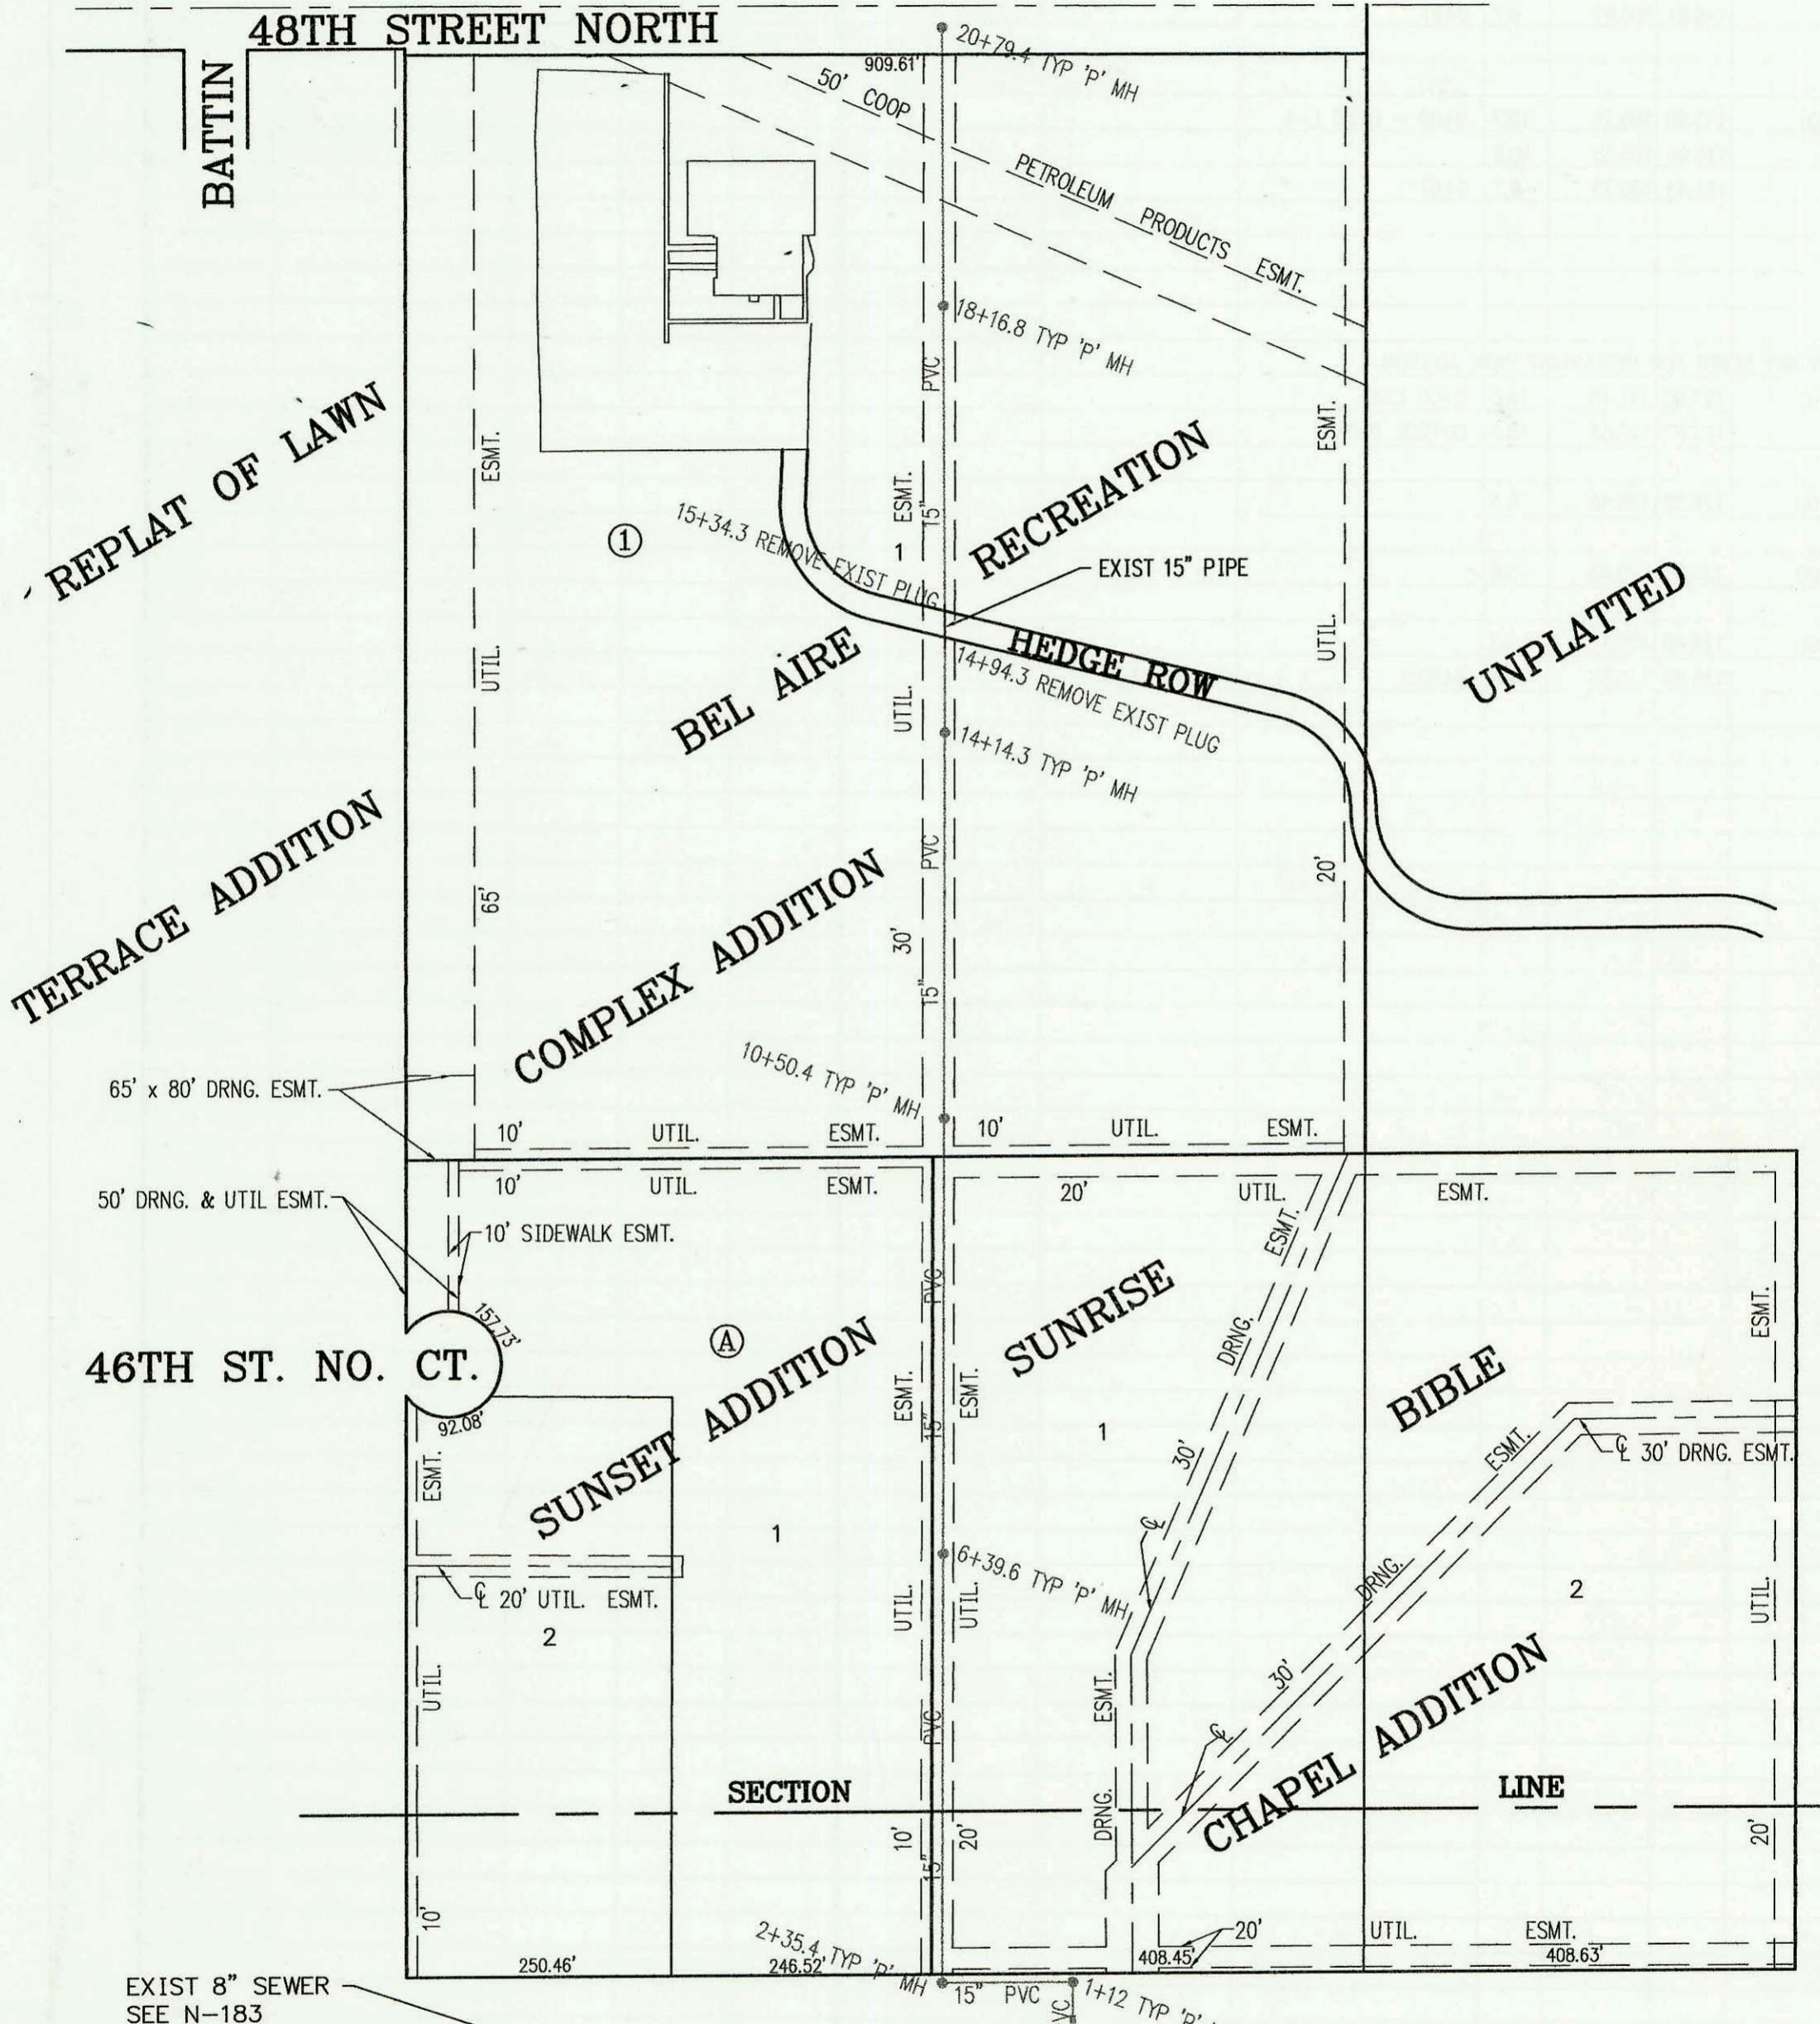

CONSTRUCTION RECORD						SERVICE RECORD						
STATION	ELEVATION		DEPTH	MANHOLE	4-INCH "Y" BRANCHES		No. of Permit		House Number		DATE OF PERMITS	
	GROUND	GRADE			North West	South East	North West	South East	North West	South East	North West	South East
15" SANITARY SEWER MAIN TO SERVE BEL AIRE												
0+00	219.51	205.59	OUT 13.9	0+00								
	219.51	205.66	IN 13.8									
1+00	221.40	207.43	14.0	Sunrise church add- tied back to 6"								
	220.99	207.64	OUT 13.4	1+12			3348		BLD SWA - 2TWINCO, SCH 40 PVC, 16x4 WYE, 2 1/2" 500/550 E45th		10-12-98	
	220.99	207.69	IN 13.3									
2+00	226.90	210.91	16.0									
	227.06	211.46	OUT 15.6	2+34.5								
	227.06	211.56	IN 15.5									
3+00	227.70	211.77	15.9									
4+00	229.20	212.08	17.1									
5+00	229.90	212.40	17.5									
6+00	231.00	212.71	18.3									
	231.79	212.84	OUT 18.9	6+39.6								
	231.79	212.89	IN 18.9									
7+00	231.20	213.12	18.1									
8+00	231.70	213.51	18.2									
9+00	231.80	213.90	17.9									
10+00	233.00	214.28	18.7									
	233.13	214.48	OUT 18.7	10+50.4								
	233.13	214.54	IN 18.6									
11+00	232.80	214.72	18.1									
12+00	232.80	215.07	17.7									
13+00	232.90	215.42	17.5									
14+00	232.40	215.78	16.6									
	232.61	215.83	OUT 16.8	14+14.3								
	232.61	215.94	IN 16.7									
14+94.3	232.60	216.19	16.4									
15+00	232.60	216.21	16.4									
15+34.3	232.80	216.32	16.5									
16+00	232.80	216.52	16.3									
17+00	232.10	216.83	15.3									
18+00	232.00	217.15	14.9									
	231.40	217.20	OUT 14.2	18+16.8								
	231.40	217.40	IN 14.0									
19+00	233.50	217.75	15.8									
20+00	234.70	218.17	16.5									
	235.47	218.51	17.0	20+79.4								