


SCALE: 1" = 100'

LATERAL 73, SANITARY SEWER NO. 23
PROJECT NO. 468-82132 (742775)
BUILT BY NOWAK CONSTRUCTION CO.
BOOKED 10/29/96 PER PLAN

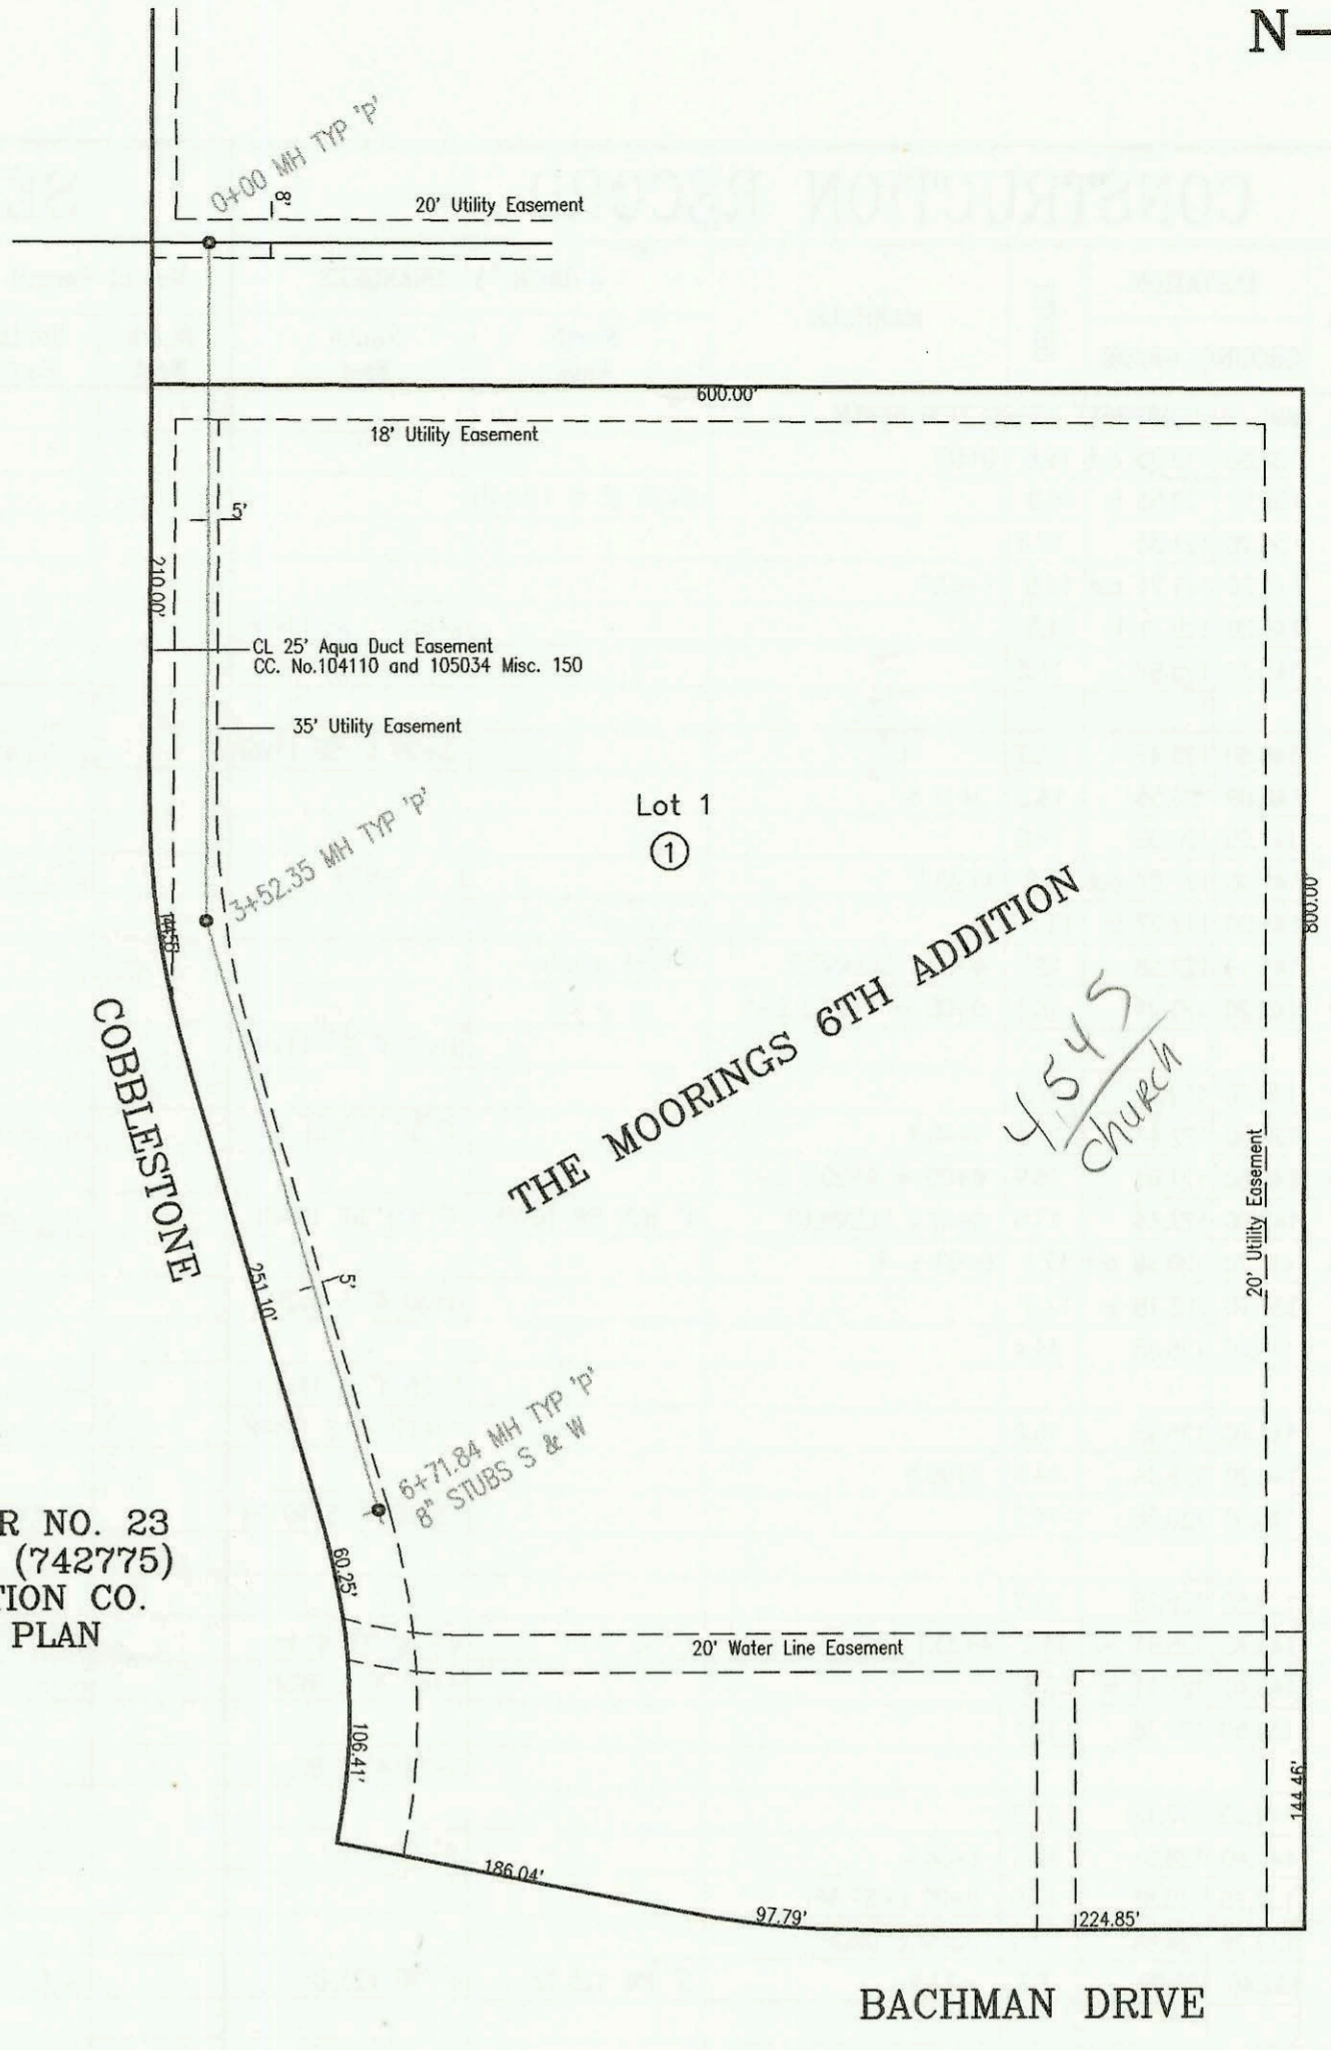

SANITARY SEWER EXTENSION TO SERVE BOGUE ADDITION
PRIVATE PROJECT NO. 645PPS (607861)
BUILT BY INTERSTATE MECHANICAL INC.
BOOKED 10/28/96 FROM AS BUILTS

SCALE: 1" = 100'

