



LATERAL 120, WESTLINK SEWER
PROJECT NO. 468-82546 (742783)
BUILT BY W. B. CARTER CONSTRUCTION CO.
BOOKED 12/2/96 PER PLAN

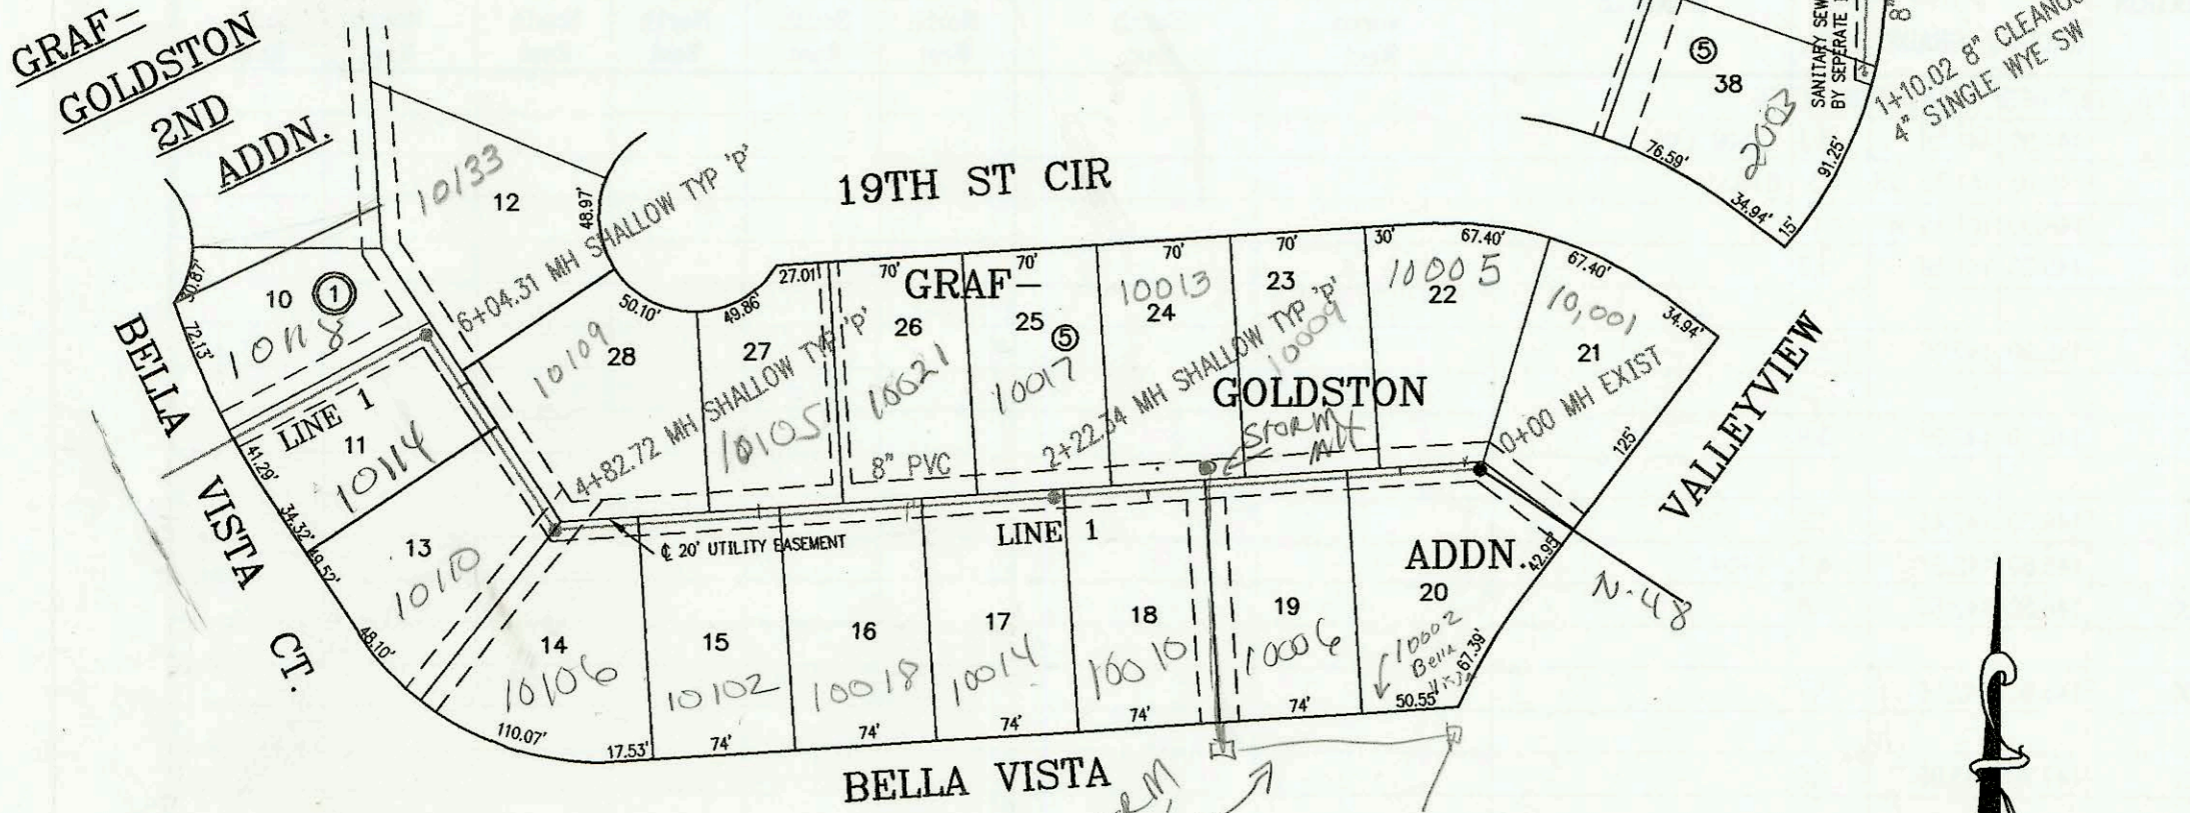


SCALE: 1" = 100'

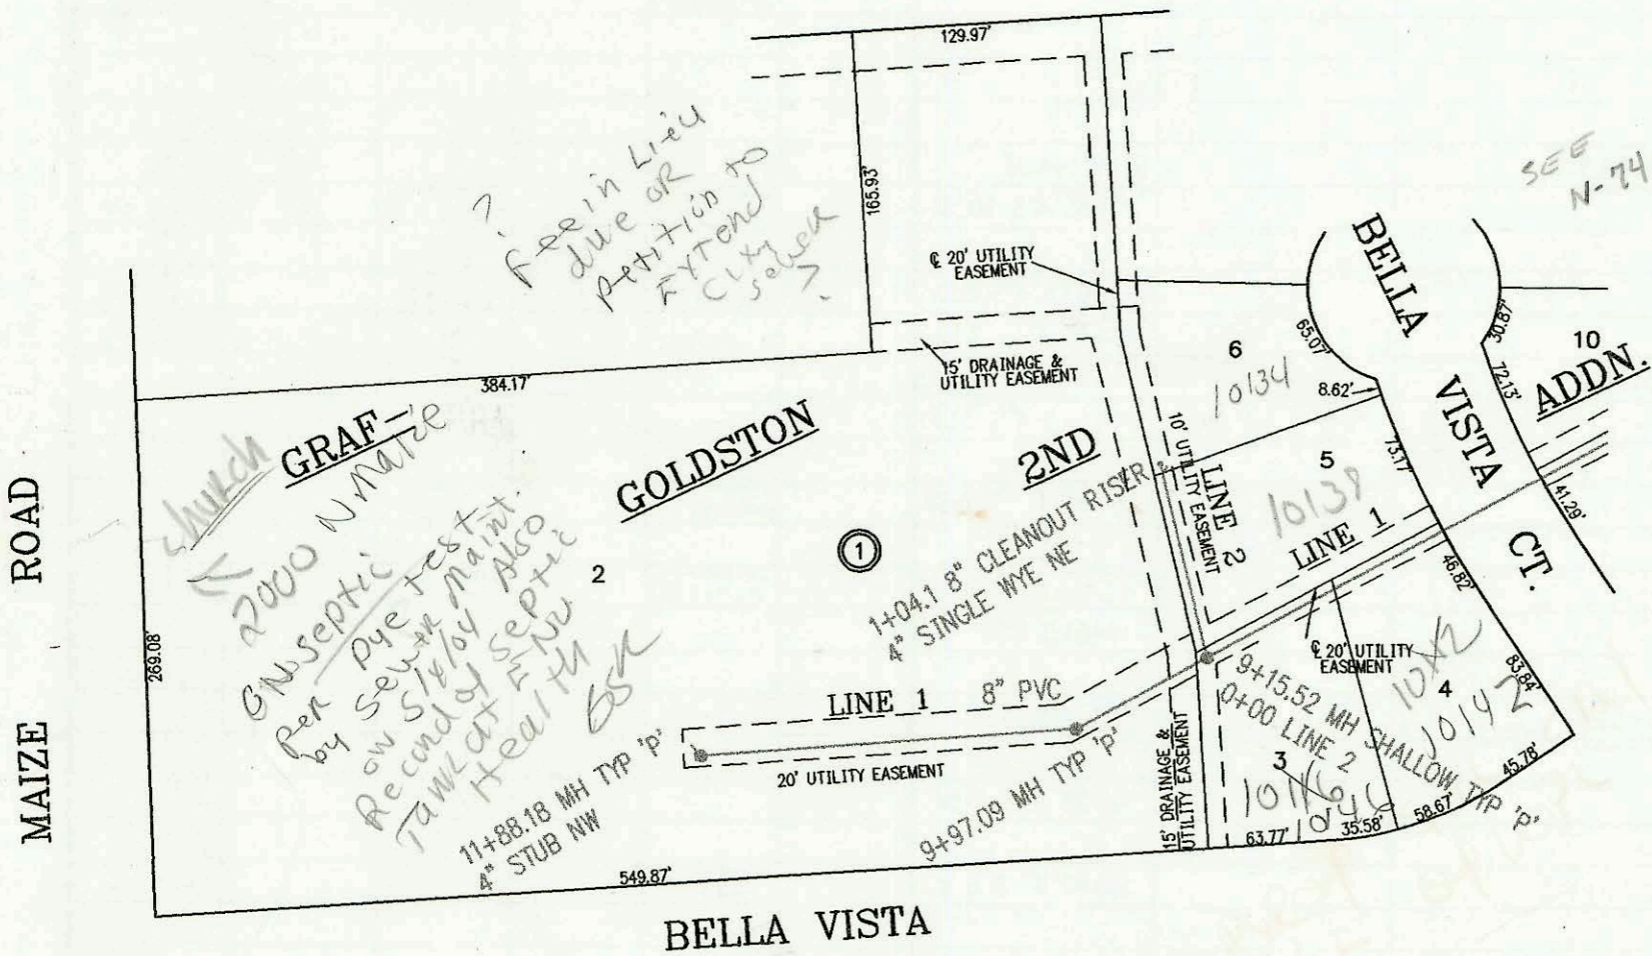

SCALE: 1" = 100'

LATERAL 70, MAIN 22, WAR INDUSTRIES SEWER
PROJECT NO. 468-82634 (742916)
BUILT BY W. B. CARTER CONSTRUCTION CO.
BOOKED 1/13/97 PER PLAN

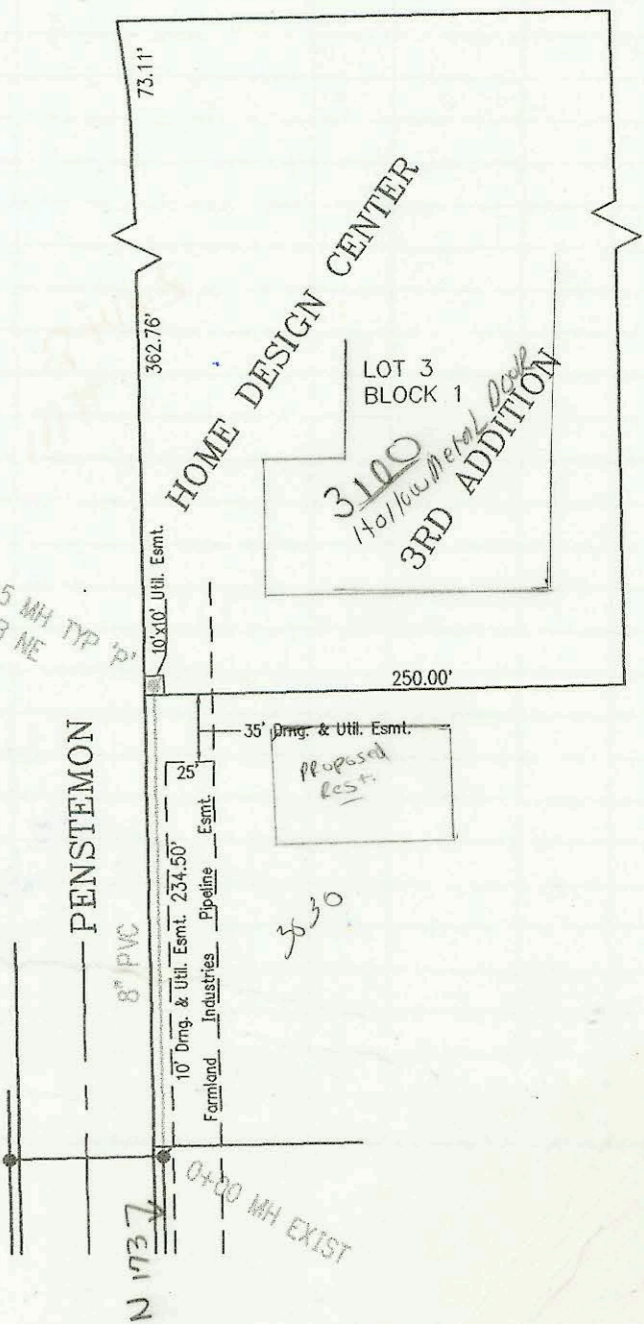

CONSTRUCTION RECORD						SERVICE RECORD						
STATION	ELEVATION		DEPTH	MANHOLE	4-INCH "Y" BRANCHES		No. of Permit		House Number		DATE OF PERMITS	
	GROUND	GRADE			North West	South East	North West	South East	North West	South East	North West	South East
LATERAL 120, WESTLINK SEWER												
0+00 L-1	157.03	149.67	7.4	0+00 EXIST	4" SCH 40 0+13		2000- 02209	99-01011	10005 W 19th St 10007 W 19th	10002 Bella Vista	10-10-00	10-25-99
1+00	156.50	149.97	6.5				98-5467				4-298	
2+00	156.50	150.27	6.2		4" SCH 40 1+67.34	1+72.3	2000- 01901	99-57287	10013 W 19th 10017 W 19th	10010 Bella Vista	3-25-00	3-30-99
	156.40	150.34	6.1	2+22.34			98-5421-7	99- 00147	10021 W 19th 10018 W 19th	10014 Bella Vista	3-25-99	8-23-99
3+00	157.00	150.57	6.4		4" SCH 40 3+77.34 TAP	4" SCH 40 2+98	2000- 00872	2000- 00212	10013 W 19th 10018 W 19th	10013 Bella Vista	4-10-00	124-2000 5597
4+00	157.50	150.87	6.6					99-70917				
	157.10	151.12 out	6.0	4+82.72				99-2921-7		10100 Bella Vista		2-10-94
	157.10	151.22 in	5.9									
5+00	156.50	151.27	5.2				1999-0371	99-55737	10104 W 19th	10110 Bella Vista	8-6-99	3-19-99
6+00					4" SCH 40 5+93.31	4" SCH 40 5+95.3	2000- 0529	2000- 0130	10111 Bella Vista 10112 Bella Vista	10133 W 19th	2-26-03	5-26-00
	157.90	151.60 out	6.3	6+04.31			2000- 02960				11-7-02	
	157.90	151.70 in	6.2									
7+00	161.20	151.53	9.7									
8+00	161.30	152.06	9.2					99-89887		10114 ² Bella Vista		4-24-99
9+00	158.10	152.58	5.5									
	157.45	152.63	4.8	9+15.52								
10+00												
11+00	163.60	155.29	8.3									
	166.10	155.56	10.5	11+88.19	4" NW 155.89							
0+00 L-2	157.90	152.97	4.9	0+00 = 9+15.52 L-1				1999-00402		10135 Bella Vista		8-10-99
1+00												
	158.10	153.27	4.8	1+04.1 CLEANOUT RISER, SINGLE WYE NE				99-16547		10134 Bella Vista		1-21-99
0+00 L-3	158.40	148.60	9.8	0+00 EXIST								
1+00												
	157.80	150.73	7.1	1+10.02 CLEANOUT RISER, SINGLE WYE SW								
LATERAL 70, MAIN 22 WAR INDUSTRIES SEWER												
0+00	224.01	211.00	13.0	0+00 EXIST								
1+00	223.60	212.02	11.6									
2+00	223.40	213.04	10.4					99-15483-7		3030 Penstemon		9-7-07
	223.00	213.50	9.5	2+44.5		6" NE 215.00		96-1777-7		3100 Penstemon		10-28-96