


13TH STREET NORTH



SANITARY SEWER LIFT STATION & FORCE MAIN  
 FOR LAT 1 & LAT 2, MAIN 18, SWI SEWER  
 PROJECT NO. 468-82561 (742593)  
 BUILT BY NOWAK CONSTRUCTION CO.  
 1/7/97 PER PLAN

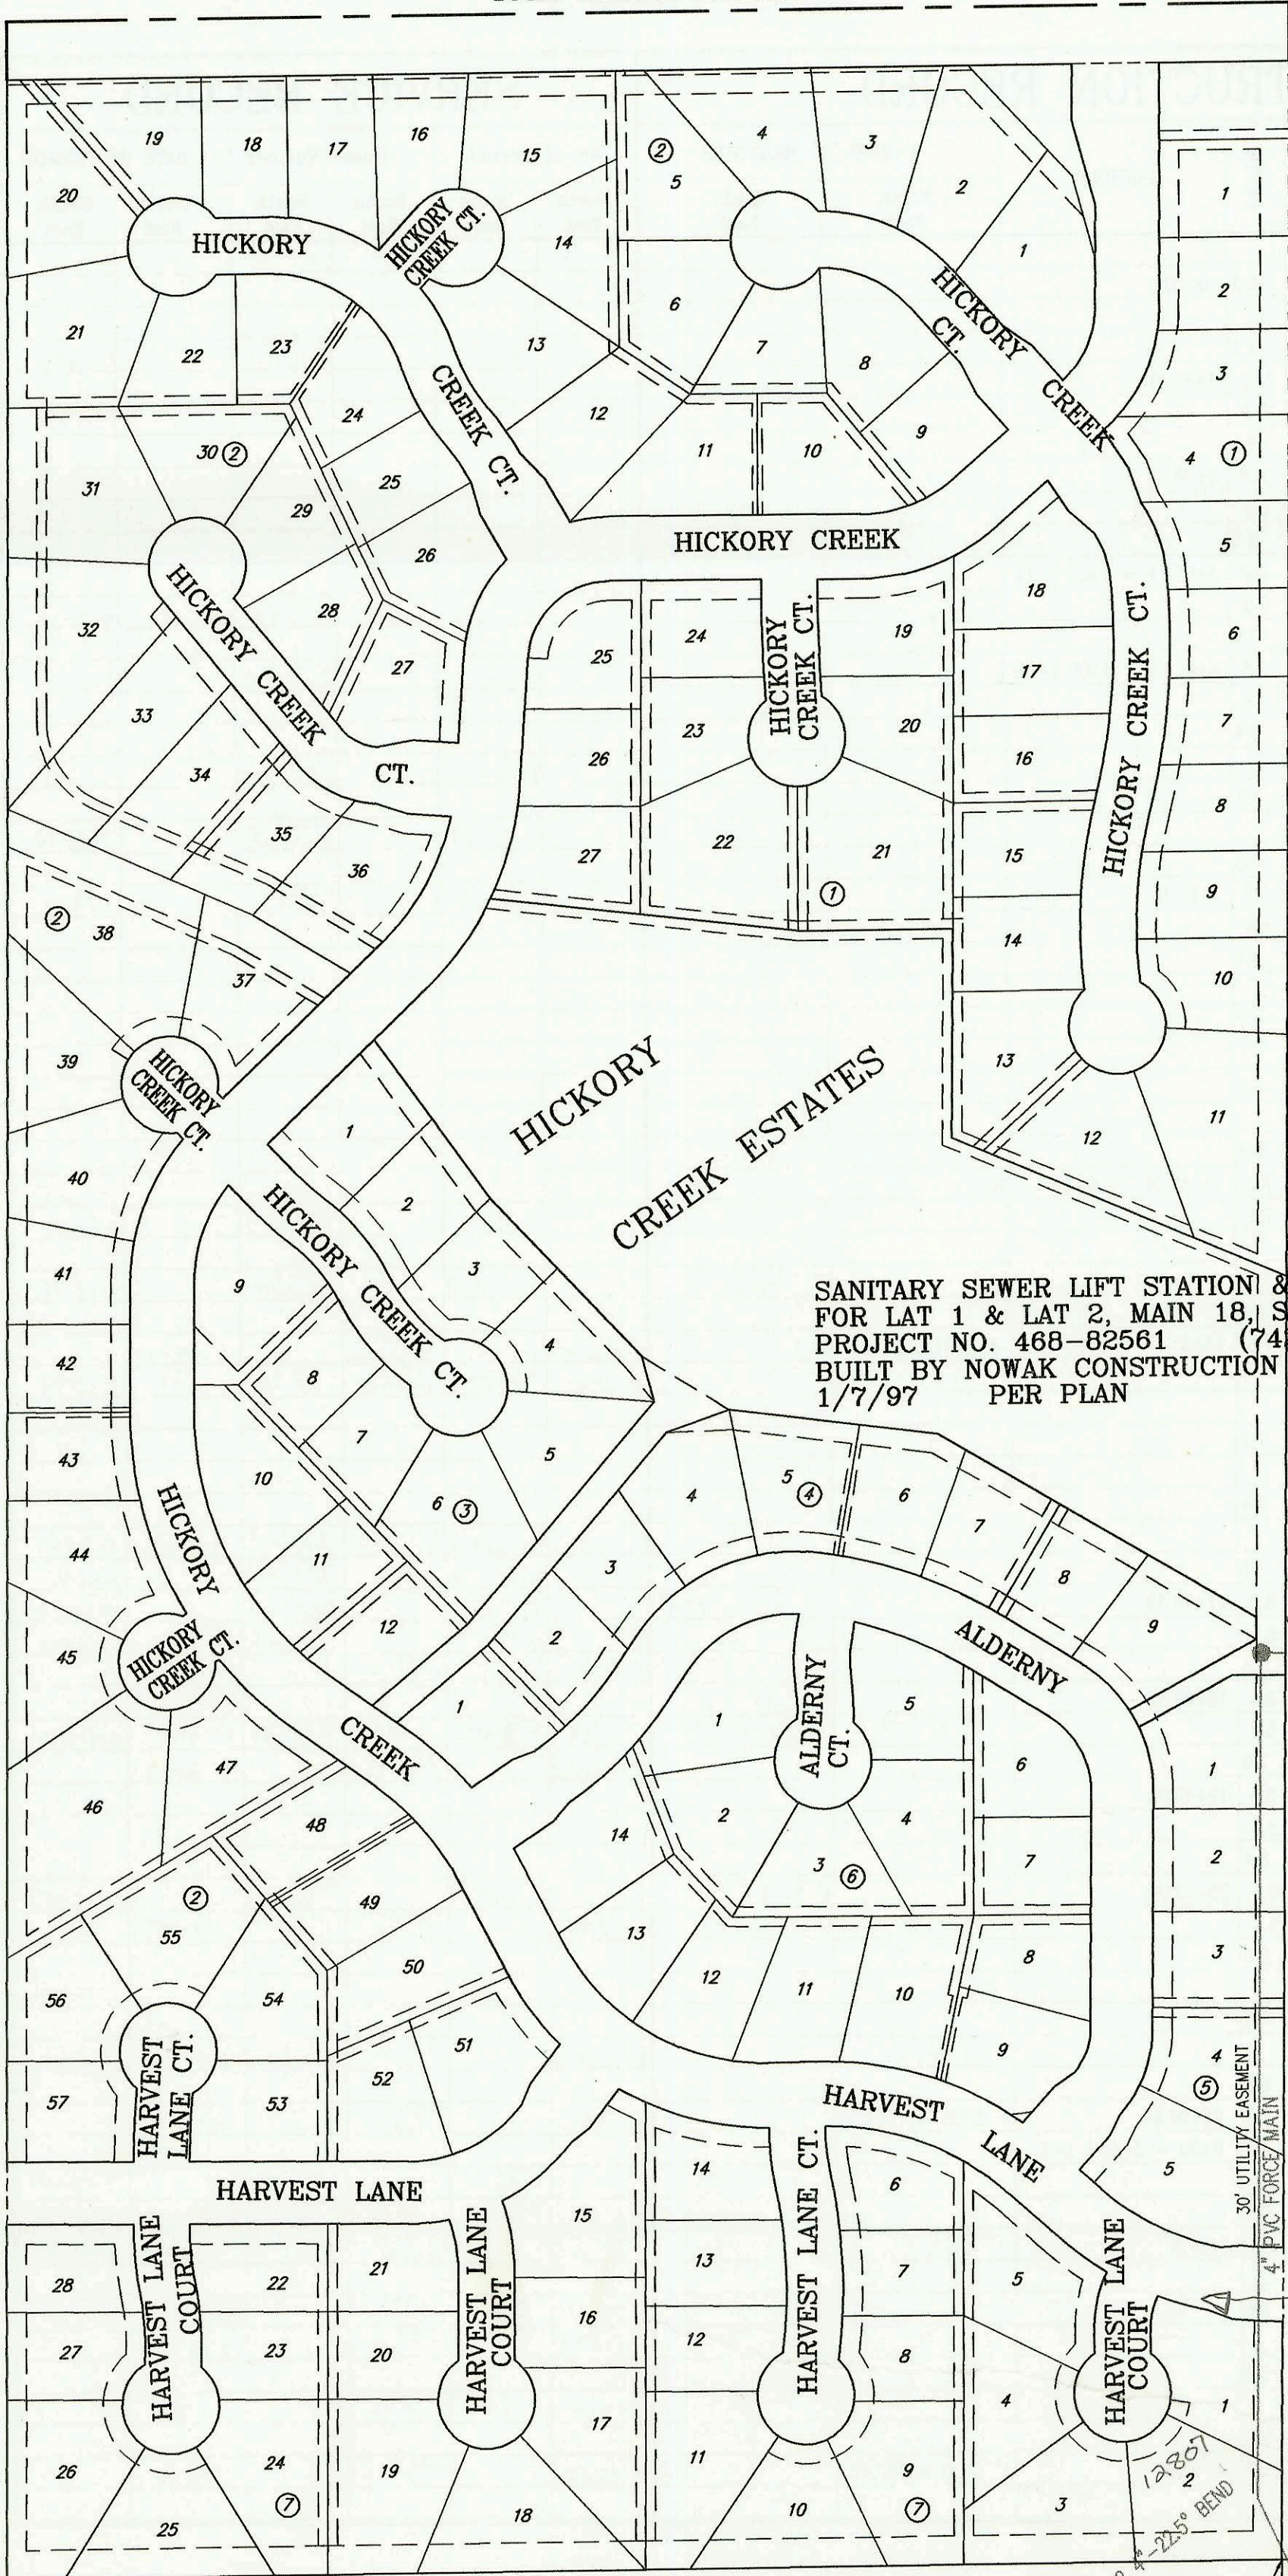

SCALE: 1" = 150'

8'-57.0" 5' DIA WET WELL MANHOLE  
 8" STUB E, 25 LF

*Cannot look to force main*

*See P118 for swr lines for this section*

12807  
 2  
 225° BEND  
 04-922  
 N.W. Corner, SE 1/4,  
 Sec. 13, T-27-S, R-2-W.

30' UTILITY EASEMENT  
 4" PVC FORCE MAIN

10' Utility Easement  
 6000 MH EXIST

