

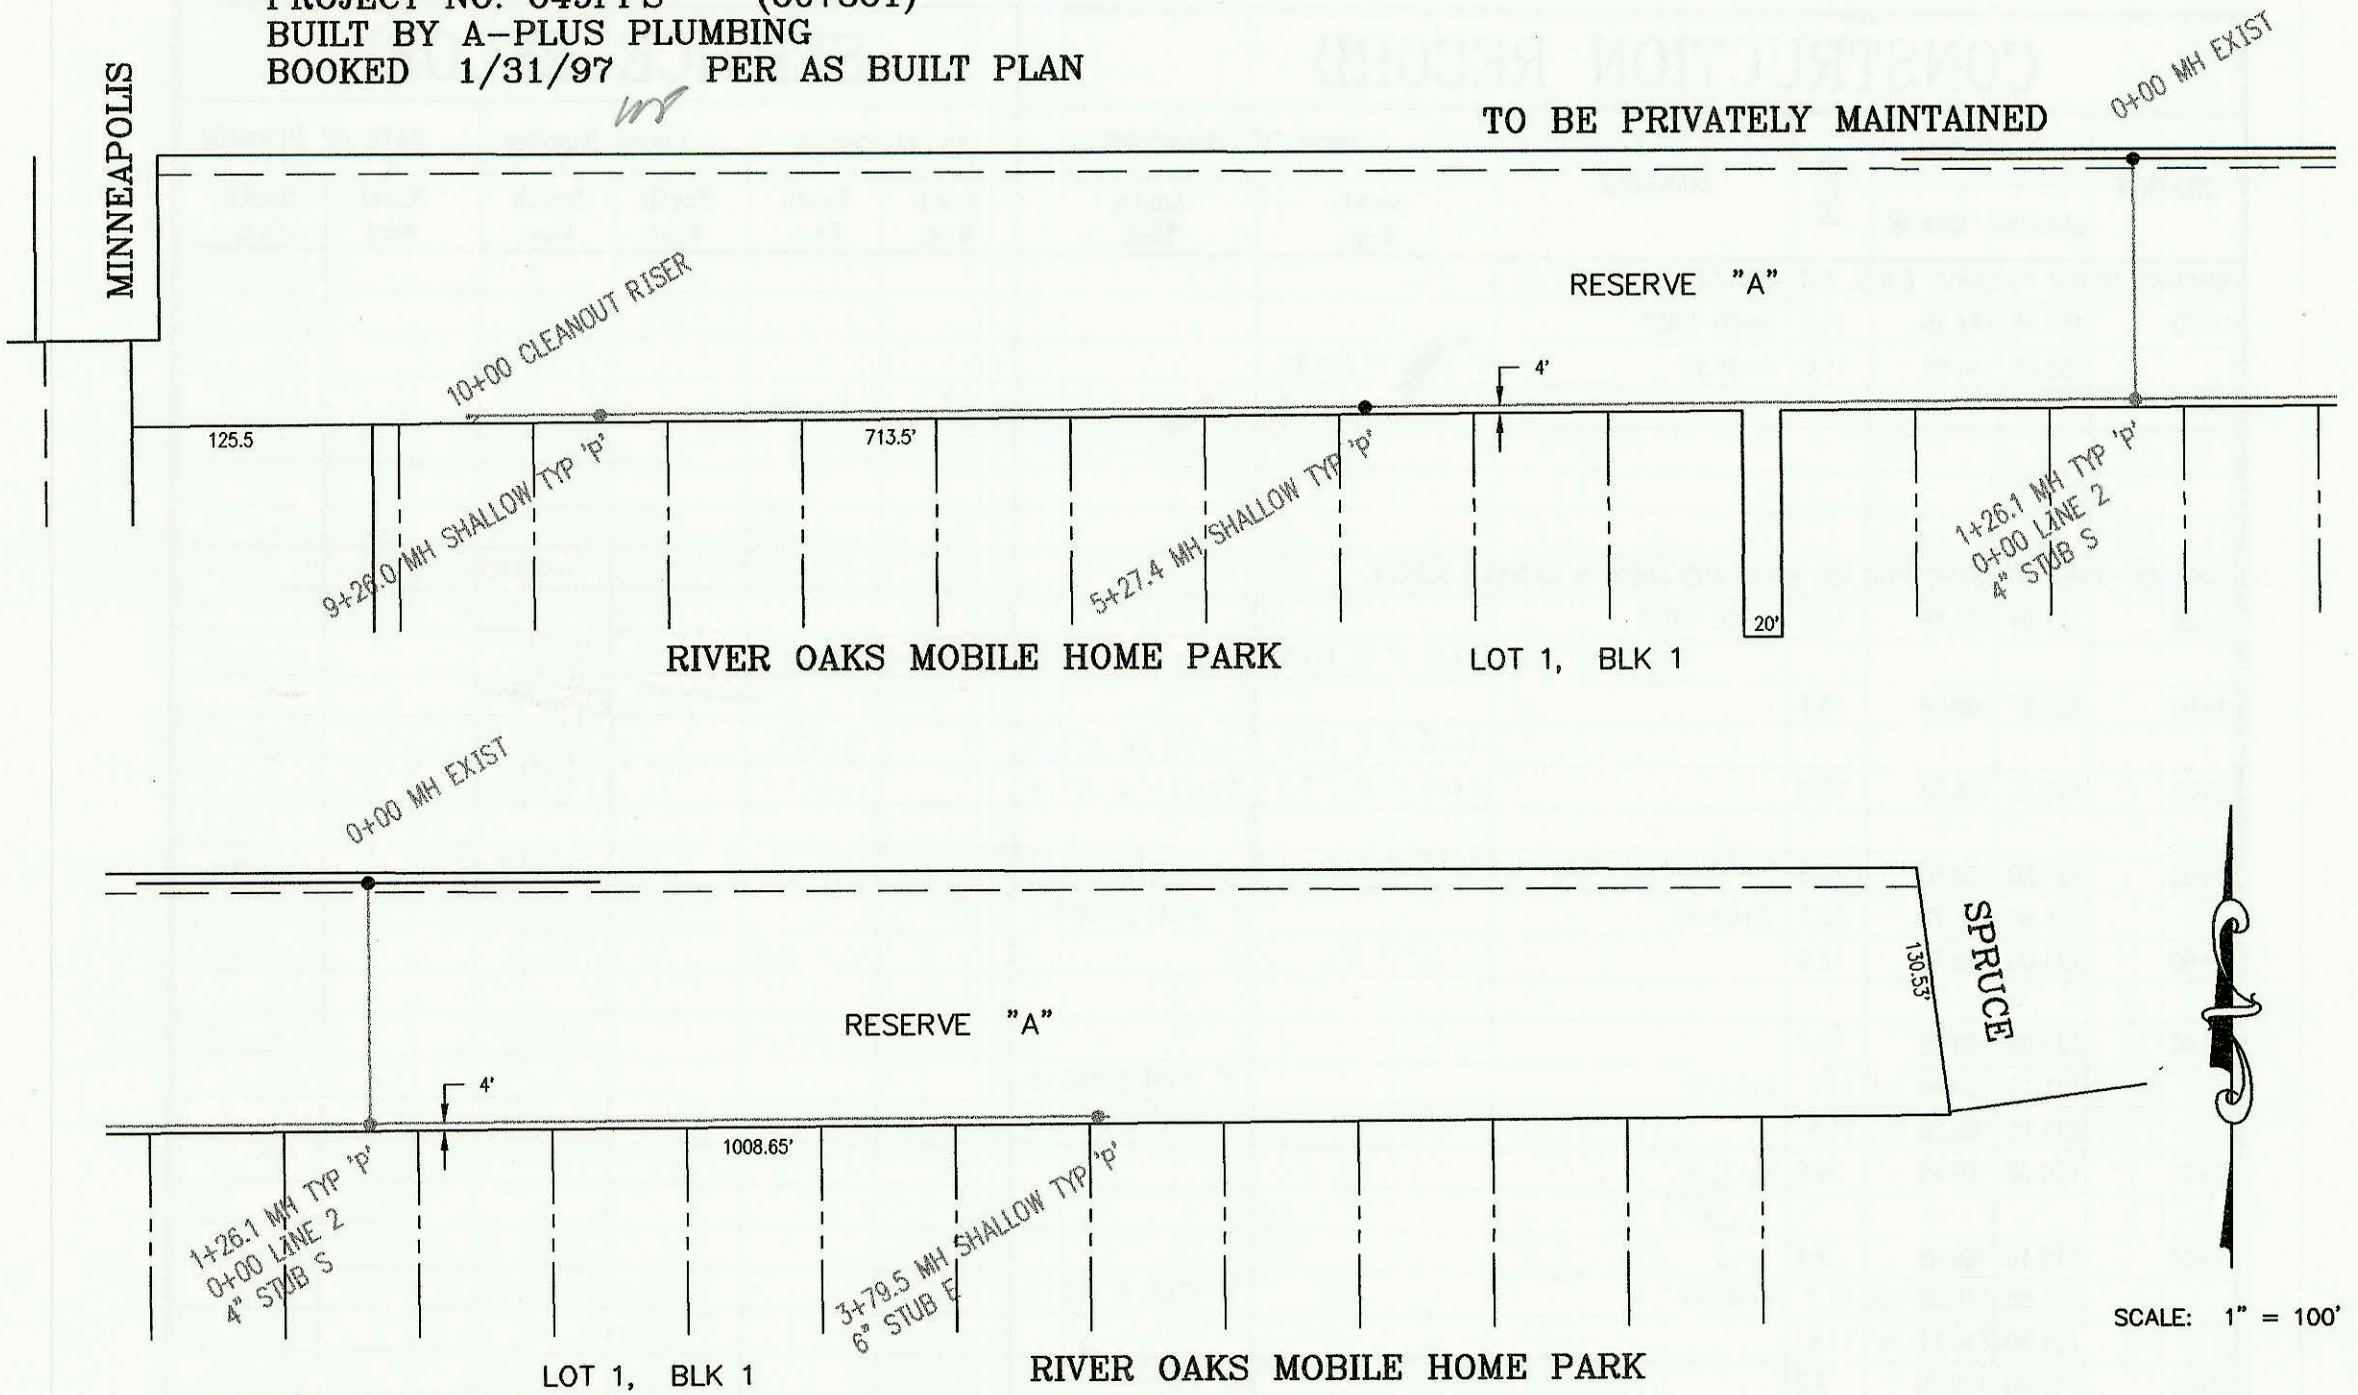


PRIVATE SANITARY SEWER FOR LOT 1, BLK 1, RIVER OAKS MOBILE HOME PARK (PASE 2)  
 PROJECT NO. 649PPS (607861)  
 BUILT BY A-PLUS PLUMBING  
 BOOKED 1/31/97 PER AS BUILT PLAN

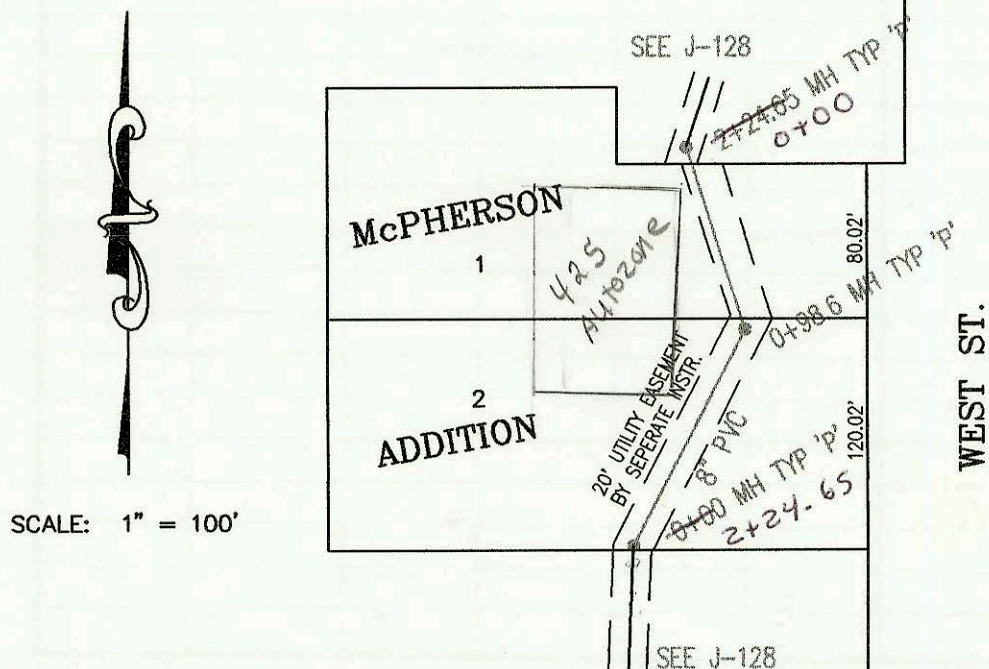

SANITARY SEWER IMPROVEMENTS TO SERVE  
 CIRCUIT CITY ADDITION  
 PROJECT NO. 619PPS (607861)  
 BUILT BY McCOULLOUGH EXCAVATION CO.  
 BOOKED 1/31/97 PER AS BUILT PLAN

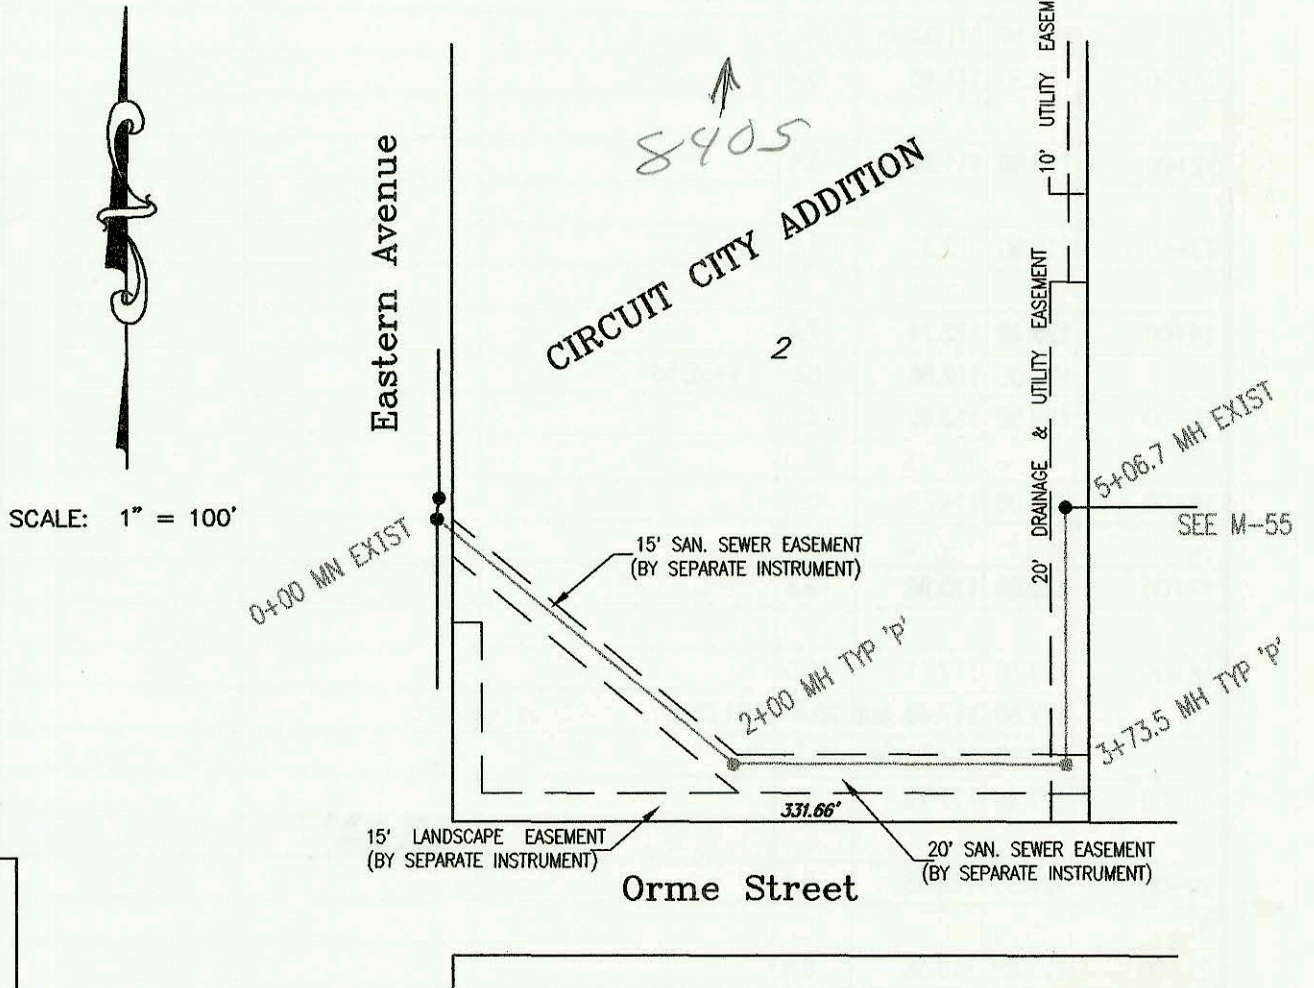

SANITARY SEWER IMPROVEMENTS TO SERVE  
 LOT 1 & 2 McPHERSON ADDITION  
 PROJECT NO. 637PPS (607861)  
 BUILT BY UTILITY CONTRACTORS INC.  
 BOOKED 1/31/97 PER AS BUILT PLAN

