


LATERAL 353, SOUTHWEST INTERCEPTOR SEWER
PROJECT NO. 468-82489 (742833)
BUILT BY UTILITY CONSTRUCTION CO.
BOOKED 4/16/97 PER PLAN

SCALE: 1" = 100'

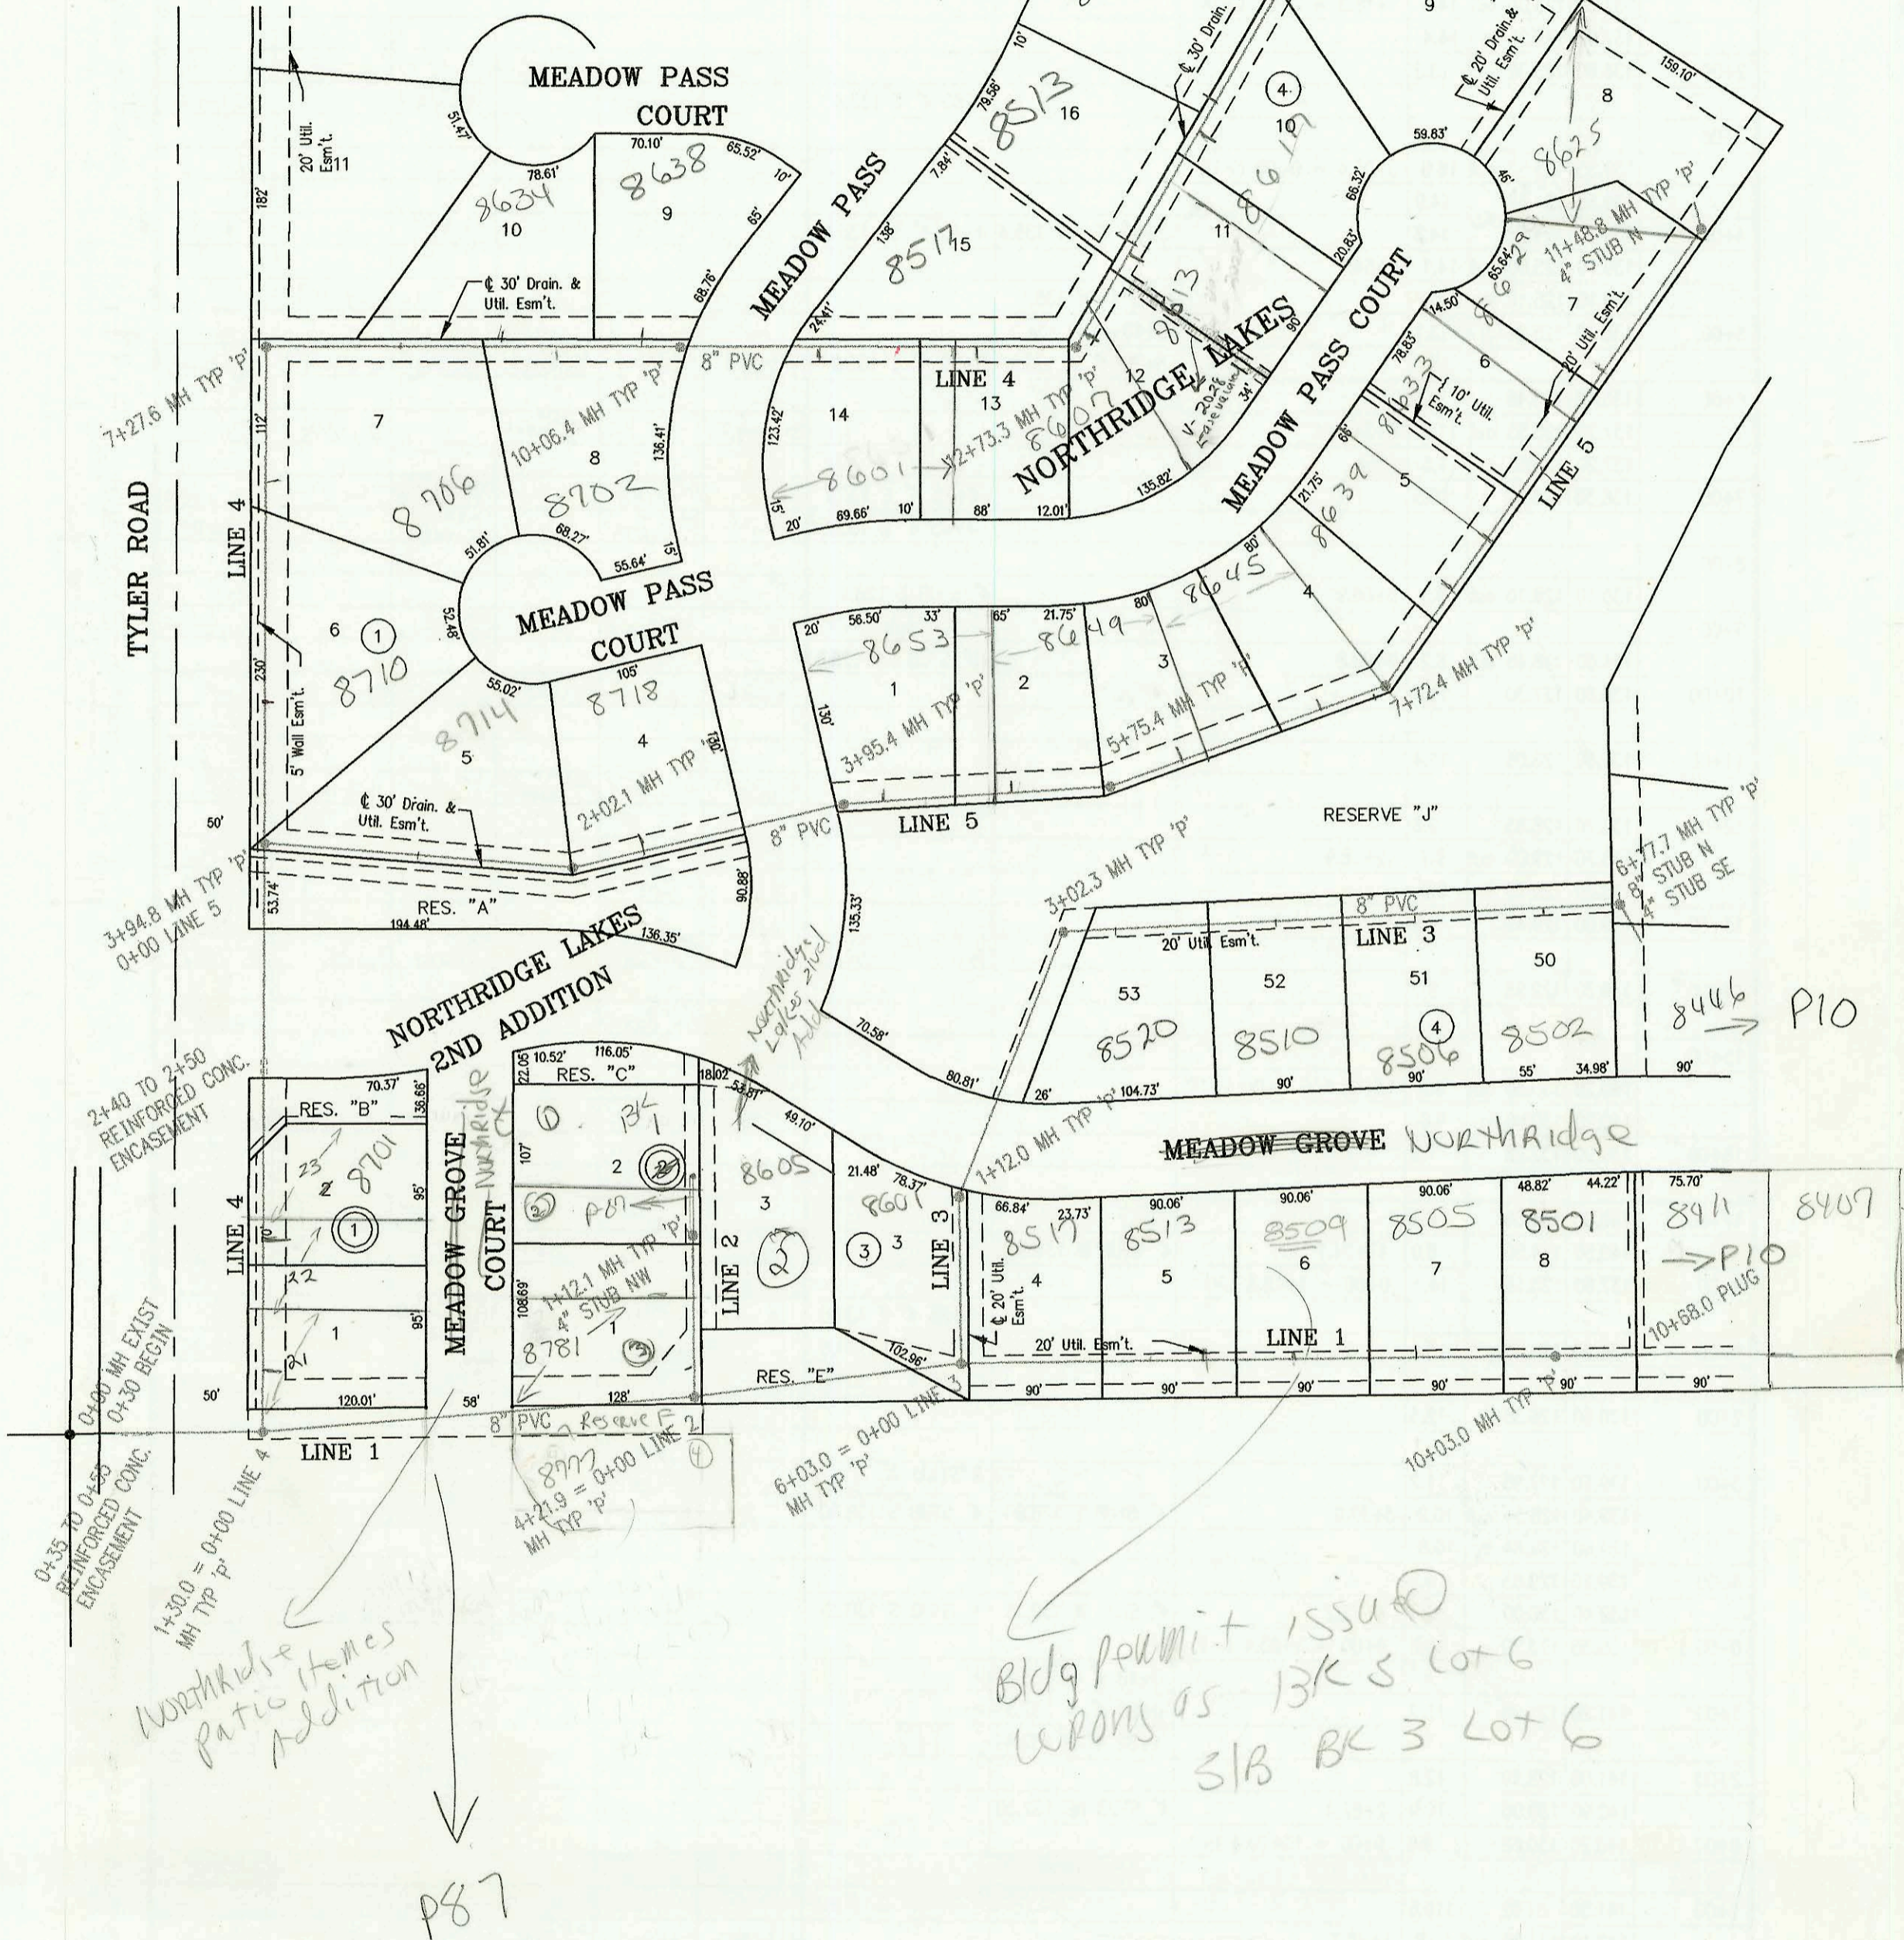

CONSTRUCTION RECORD						SERVICE RECORD						
STATION	ELEVATION		DEPTH	MANHOLE	4-INCH "Y" BRANCHES		No. of Permit		House Number		DATE OF PERMITS	
	GROUND	GRADE			North West	South East	North West	South East	North West	South East	North West	South East
LATERAL 353, SOUTHWEST INTERCEPTOR SEWER												
LINE 1	0+00 L-1	167.60	155.86 in	11.7	0+00 EXIST							
	0+30	166.30	155.98	10.3								
	1+00	165.50	156.28	9.2								
		166.20	156.38	9.8	1+30.0 MH TYP 'P'							
	2+00	165.60	156.59	9.0								
	3+00	166.00	156.89	9.1								
	4+00	166.70	157.19	9.5								
		167.40	157.26	10.1	4+21.9 = 0+00 L-2							
	5+00	167.80	157.49	10.3								
	6+00											
		170.40	157.80	12.6	6+03.0 = 0+00 L-3							
	7+00	170.80	159.45	11.4		6+40 4" N 7V4H	99-55497		8517 Northridge	See below	3-24-99	
						7+30 4" N 7V4H			8513 Northridge			
	8+00	172.50	161.15	11.4		8+25 4" N 7V4H	97-164107		8509 Northridge		9-22-97	
	9+00	174.70	162.85	11.9		9+10 4" N 8V4H	1999-00202		8505 Northridge		7-15-99	
						9+90 4" N 8V4H	2002-00543		8504 Northridge		2-27-02	
	10+00											
		177.40	164.60	12.8	10+03							
	10+68.0	177.00	165.70	11.3	PLUG							
LINE 2	0+00 L-2	167.40	157.36	10.0	0+00 = 4+21.9 L-1							
						0+20 4" W 8V21H	2002-0399	200-0007	8781 Northridge	8605 Northridge	11-25-02	1-8-01
	1+00	169.00	157.76	11.2								
		169.80	157.81	12.0	1+12.1	4" NW 7V5H						
LINE 3	0+00 L-3	170.40	157.90	12.5	0+00 = 6+03.0 L-1							
						0+55 4" W 7V4H	99-14797		8601 Northridge		12-16-97	
	1+00	170.00	158.00	12.0								
		170.10	158.24	11.9	1+12.0							
	2+00	170.10	158.30	11.8								
	3+00											
		169.30	158.81 out	10.5	3+02.3							
		169.30	158.91 in	10.4		3+40 4" S 6V4H	98-18947		8520 Northridge		2-9-98	
	4+00	169.10	159.89	9.2								
						4+45 4" S 5V4H	97-19107		8510 Northridge		10-27-97	
	5+00	169.10	160.89	8.2								
						5+40 4" S 4V4H	97-20187		8506 Northridge		11-13-97	
	6+00	169.10	161.89	7.2		6+25 4" S 3V4H	98-16997		8552 Northridge		9-9-98	
		169.60	162.66	6.9	6+77.7	8" N 162.86	2000-00627		8504 Northridge		2-8-00	
LINE 4	0+00 L-4	166.20	156.48 out	9.7	0+00 = 1+30.0 L-1							
						0+40 4" E 9V14H						
	1+00	165.80	156.78	9.0								
						1+30 4" E 8V14H						
	2+00	166.10	157.08	9.0			2002-02667		8701 W Northridge		9-26-02	
	3+00	166.70	157.38	9.3								
		167.10	157.66	9.4	3+94.8 = 0+00 L-5							
	4+00											
	5+00	167.30	157.98	9.3		4+90 4" E 7V14H	2003-00096		8601 Meadow Pass		1-10-03	
	6+00	167.70	158.28	9.4								
						6+35 4" E 7V14H	99-01282		8706 Meadow Pass		11-20-99	
	7+00	168.20	158.58	9.6								
		168.70	158.66 out	10.0	7+27.6							
		168.70	158.76 in	9.9								
	8+00	170.10	158.88	11.2								
						8+85 4" N 8V4H	2002-05288		8601 Meadow Pass		1-31-02	
	9+00	172.30	159.18	13.1		9+20 4" S 7V9H	2002-03384		8601 Meadow Pass		12-16-02	
						9+80 4" N 7V4H						
	10+00	171.00	159.48	11.5								
		171.40	159.60	11.8	10+06.4							
	11+00	171.70	159.78	11.9		11+00 4" S 8V9H	07-101607		8601 Meadow Pass		6-23-97	
						11+55 4" N 8V4H	2002-00608		8517 Meadow Pass		3-6-02	
	12+00	172.00	160.08	11.9								
		170.60	160.40 out	10.2	12+73.3							
		170.60	160.50 in	10.1								

CONT. ON N-249

99-0055490701 - 8513 W NORTH RIDGE ST- Brand- Tap Made 159' E of MH 6+03.0 (7+69.0) 4" SCH 40 DID NOT USE RISER
 R-6120/100-SWR-3000-01473 - 8513 W NORTH RIDGE ST- BRAND- Rep 6CH 40 pipe from main to deck of house
 instal Twin co, repl 450 Vell + Saddle