

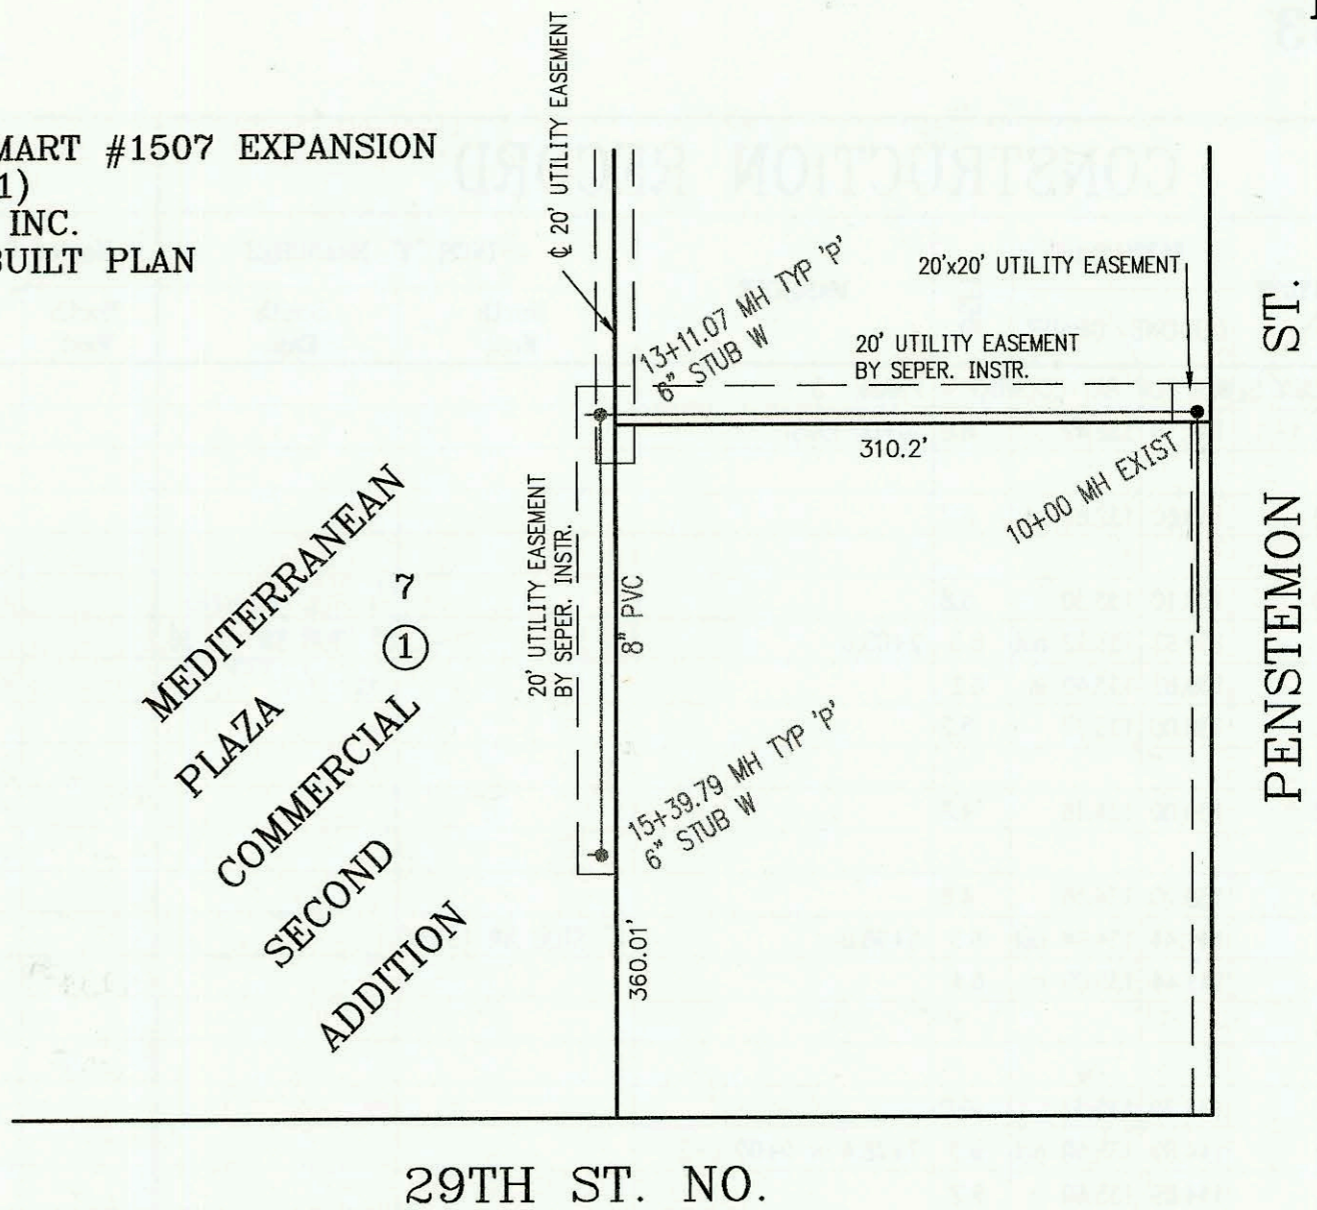


SANITARY SEWER TO SERVE WALMART #1507 EXPANSION  
 PROJECT NO. 664PPS (607861)  
 BUILT BY UTILITY CONTRACTORS INC.  
 BOOKED 4/24/97 PER AS BUILT PLAN

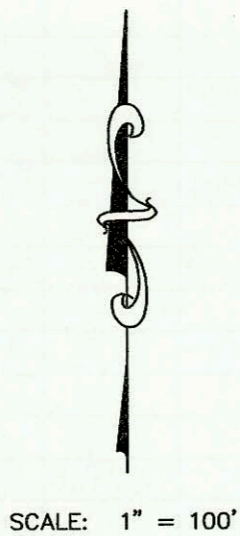


LATERAL 39, MAIN 21, SANITARY SEWER NO. 22  
 PROJECT NO. 468-82606 (742791)  
 BUILT BY H. D. MILLS CONSTRUCTION CO.  
 BOOKED 4/29/97 PER PLAN

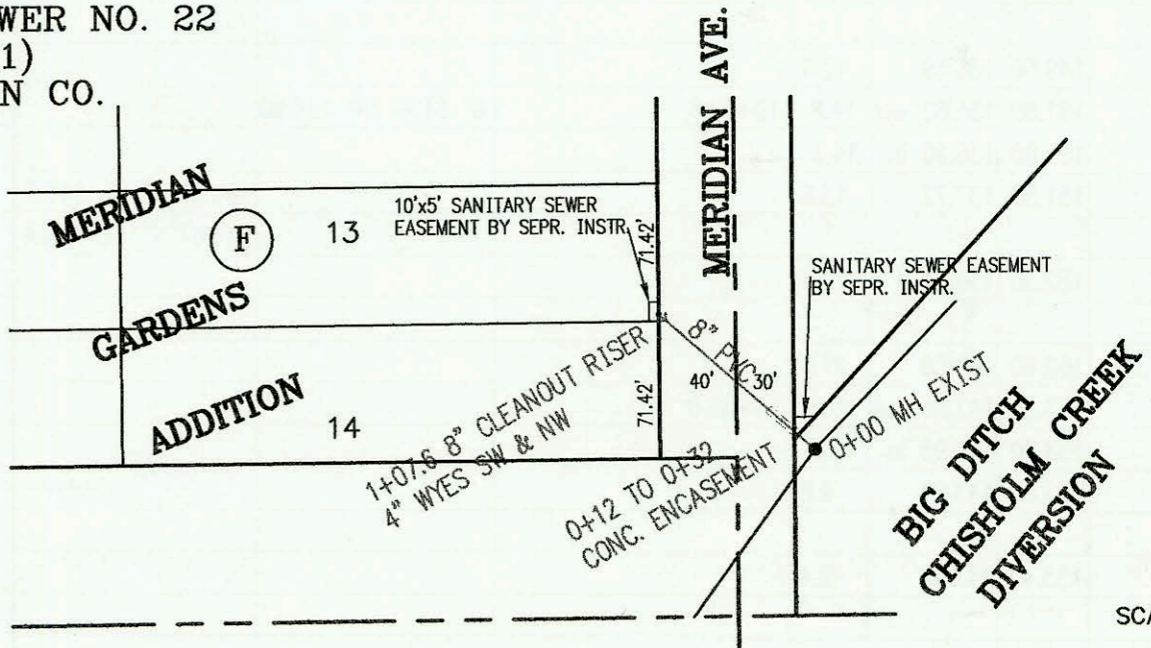

SCALE: 1" = 100'


PAWNEE AVE.

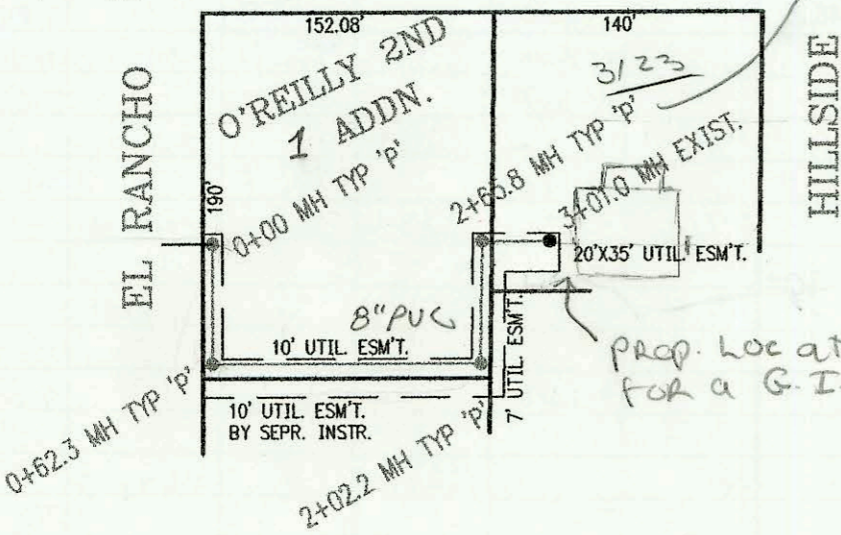

*Refer to F44 for conn  
 re wvel to MH 3101 (exist)*

SANITARY SEWER FOR O'REILLY 2ND ADDITION  
 PROJECT NO. 681PPS (607861)  
 BUILT BY McCULLOUGH EXCAVATION INC.  
 BOOKED 5/16/97 PER AS BUILT PLAN

SANITARY SEWER FOR LOT 3,  
 WICHITA LAND ADDITION  
 PROJECT NO. 614PPS (607861)  
 BUILT BY SUTHERLAND BUILDERS INC.  
 BOOKED 5/22/97 PER AS BUILT PLAN

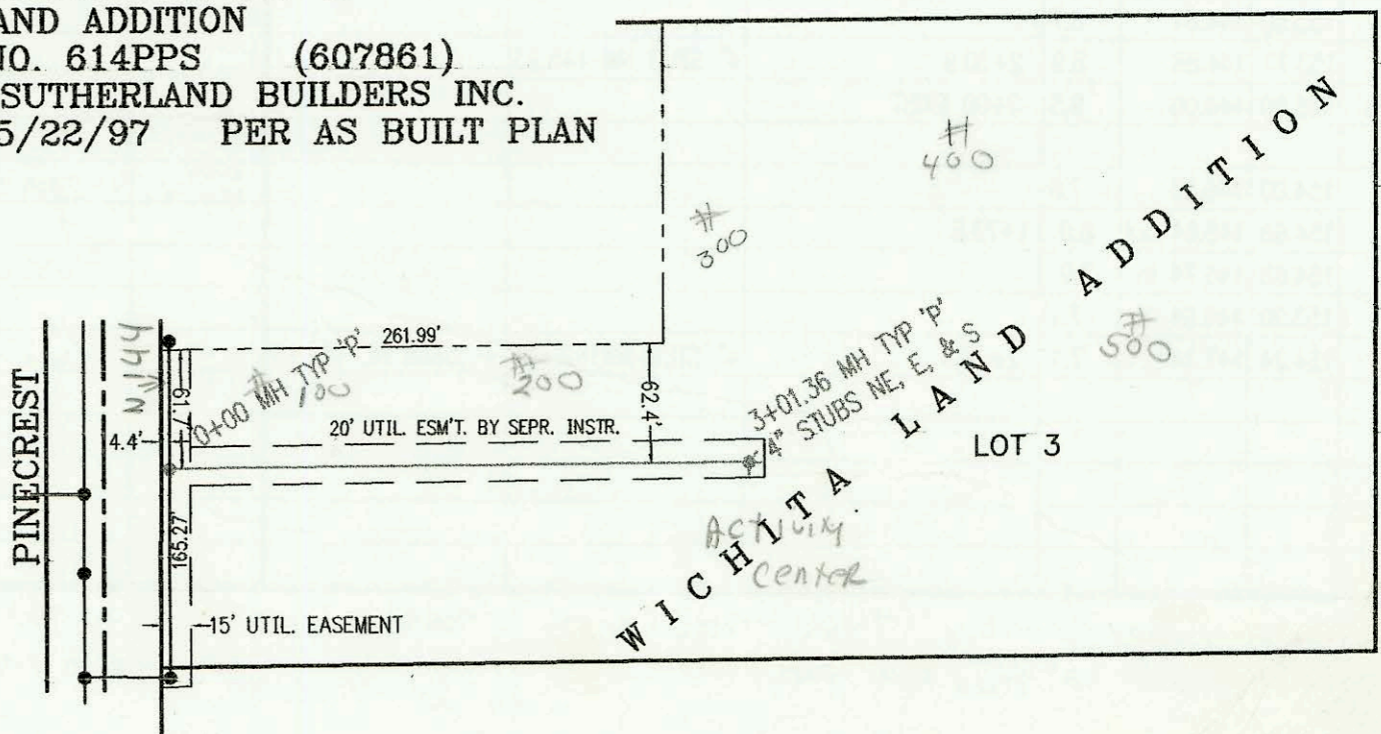

SCALE: 1" = 100'

CONSTRUCTION RECORD						SERVICE RECORD						
STATION	ELEVATION		DEPTH	MANHOLE	4-INCH "Y" BRANCHES		No. of Permit		House Number		DATE OF PERMITS	
	GROUND	GRADE			North West	South East	North West	South East	North West	South East	North West	South East
SANITARY SEWER TO SERVE WALMART #1507 EXPANSION												
10+00	224.04	212.19 out	11.8	10+00 EXIST								
	224.04	212.90 in	11.1									
11+00	225.60	214.02	11.6									
12+00	226.70	215.14	11.6									
13+00	227.90	216.26	11.6									
	227.30	216.37 out	10.9	13+11.07	6" STUB W	218.37						
	227.30	216.57 in	10.7									
14+00	227.00	217.56	9.4									
15+00	226.70	218.67	8.0									
	226.50	219.03	7.5	15+39.79	6" STUB W	218.83						
LATERAL 39, MAIN 21, SANITARY SEWER NO. 22												
0+00	131.60	125.00	6.6	0+00 EXIST								
1+00												
	132.08	125.41	6.7	1+07.59 CLEANOUT RISER W/ 4" DB. WYE								
SANITARY SEWER FOR O'REILLY 2ND ADDITION												
0+00	102.03	93.60	8.4	0+00								
	101.02	93.90 out	7.1	0+62.3								
	101.02	94.06 in	7.0									
1+00	101.50	94.16	7.3									
2+00					1+18.2 4" N	1+07.2 4" S						
	103.02	94.43 out	8.6	2+02.2								
	103.02	94.52 in	8.5									
	103.09	94.78 out	8.3	2+65.8								
	103.09	94.88 in	8.2									
3+00												
	103.70	95.02	8.7	3+01.0 EXIST								
SANITARY SEWER FOR LOT 3 WICHITA LAND ADDITION												
0+00	197.98	190.39 out	7.6	0+00								
	197.98	190.44 in	7.5									
1+00	198.80	191.02	7.8									
2+00	199.60	191.36	8.2									
3+00												
	200.84	192.74	8.1	3+01.36	4" STUB NE	193.04	4" STUB S	193.04				
							4" STUB E	193.04				