


SANITARY SEWER TO SERVE QUAIL RIDGE ADDITION
PROJECT NO. 685PPS
BUILT BY WILDCAT CONSTRUCTION CO.
BOOKED 8/11/97 PER AS BUILT PLAN

Bel Aire Sewer

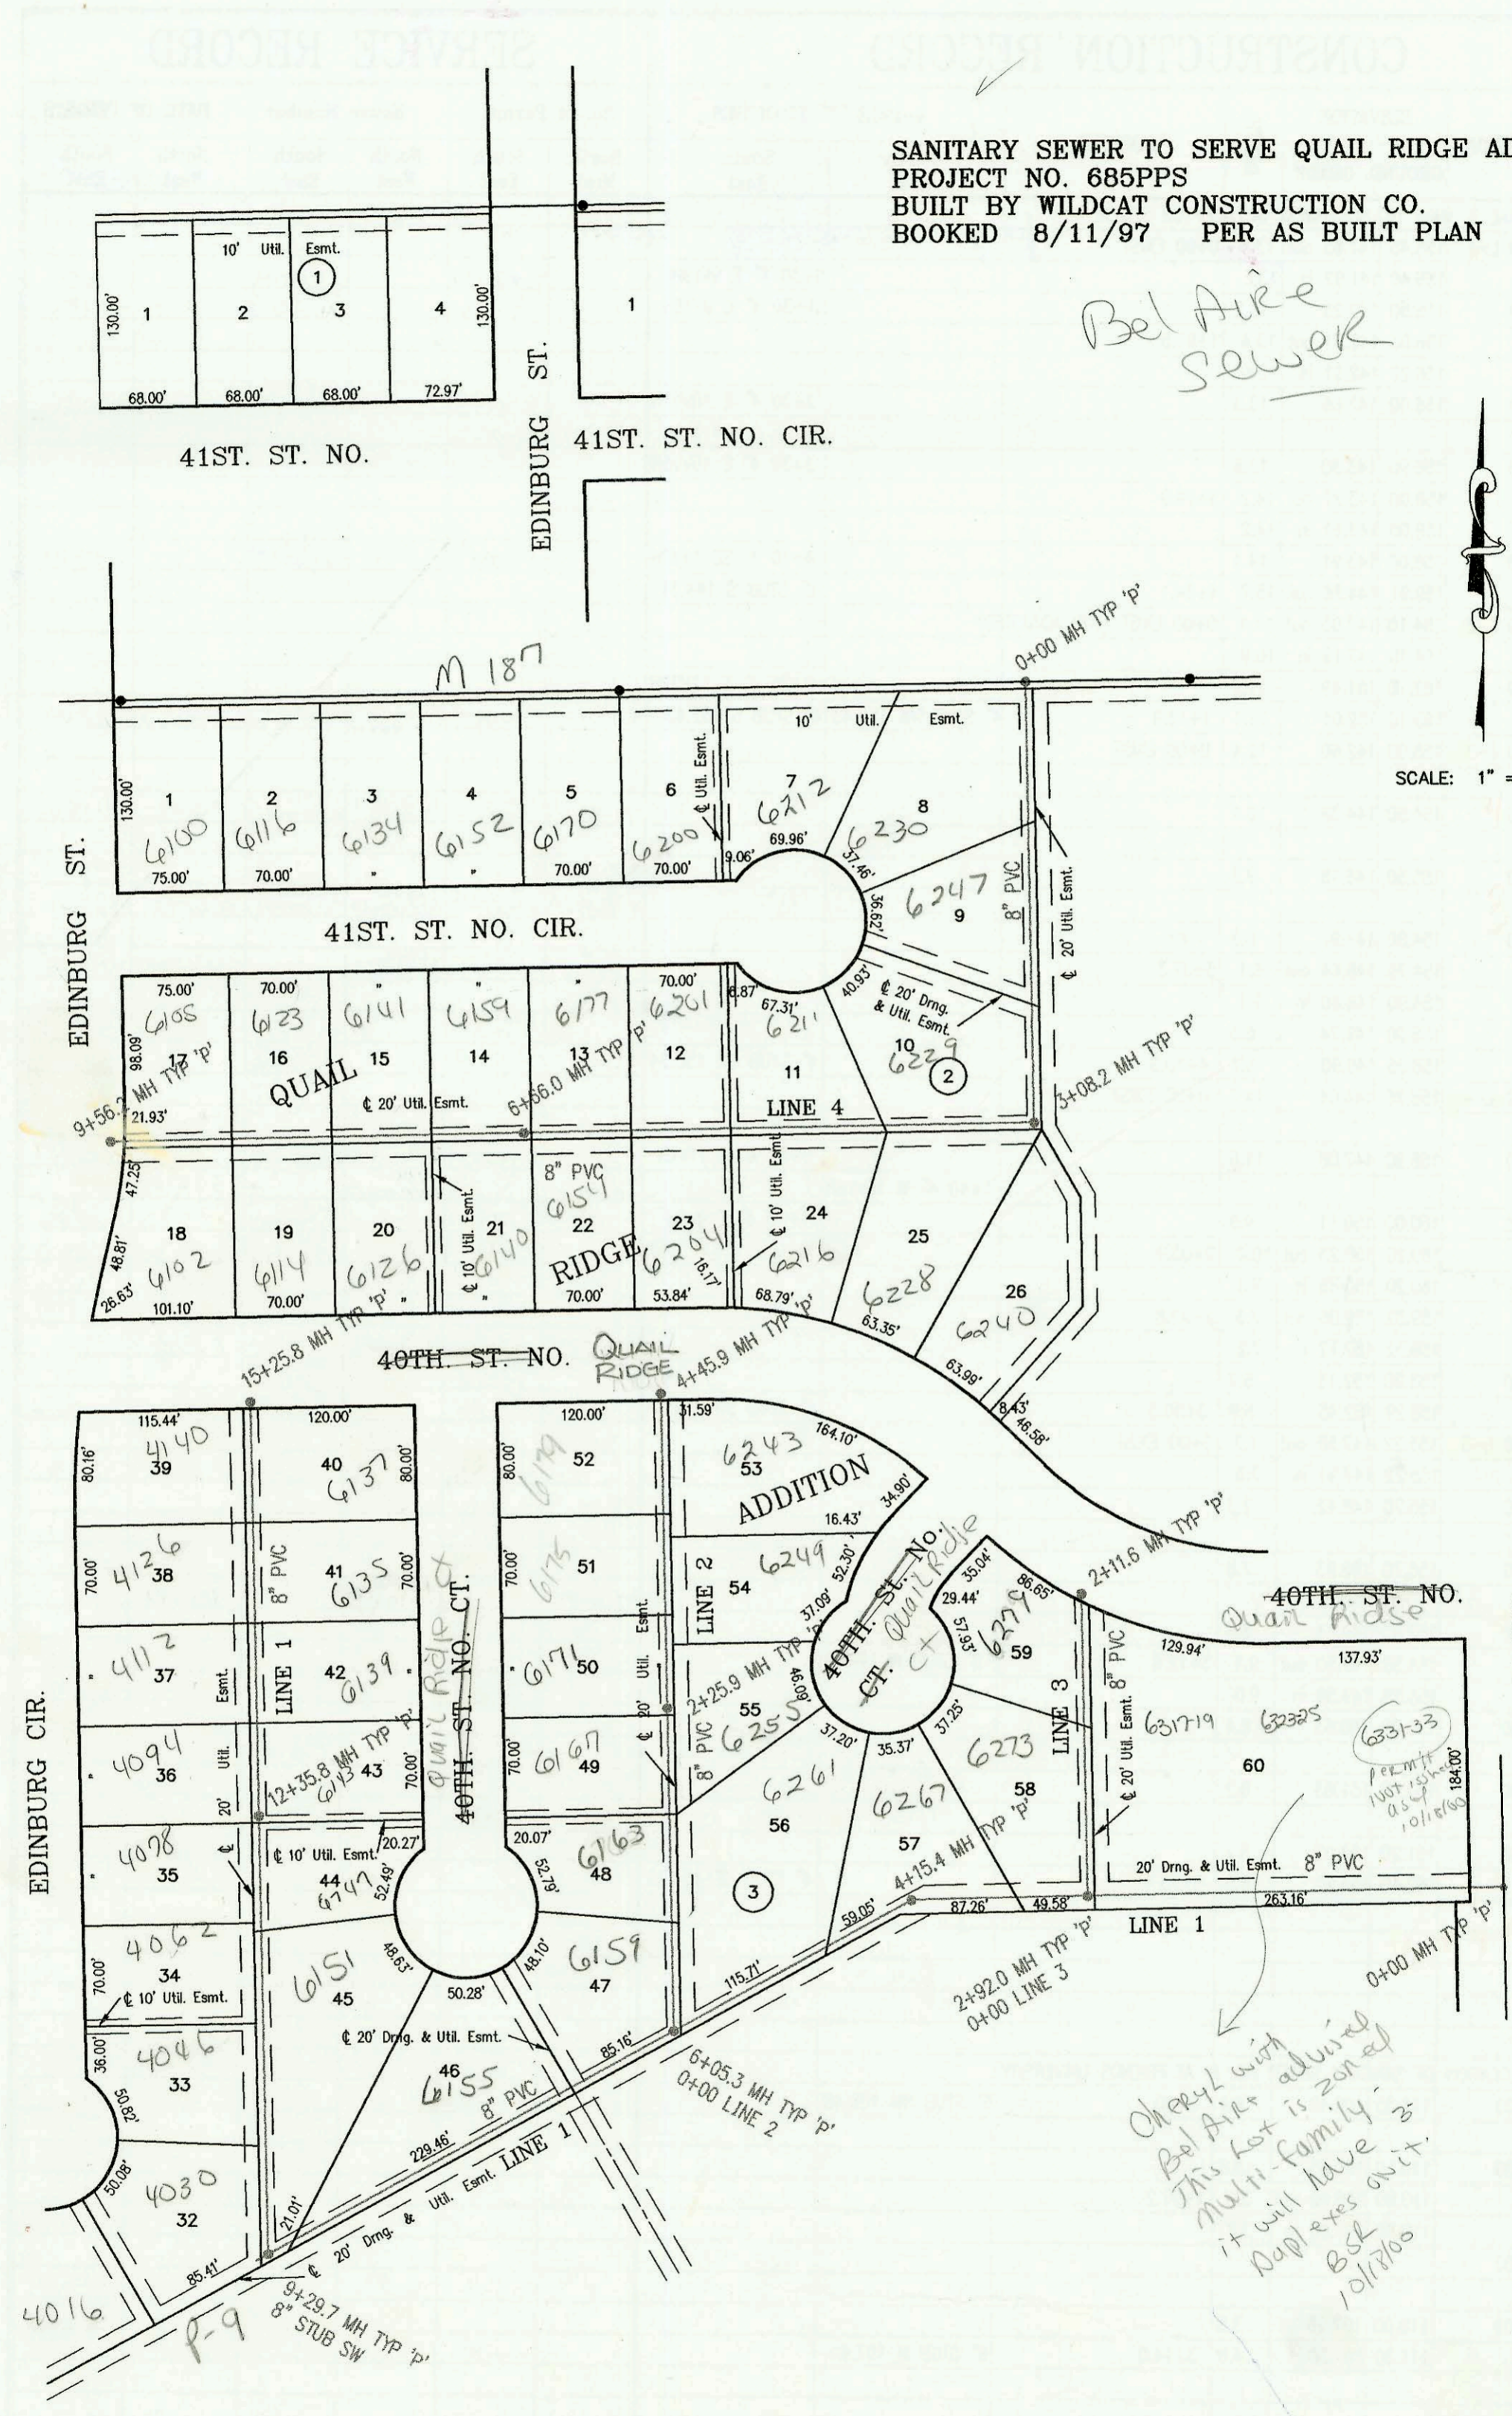

SCALE: 1" = 100'

Cheryl with Bel Aire advised this lot is owned Multi-family - it will have 3 Napl exes on it. BSK 10/17/00

CONSTRUCTION RECORD						SERVICE RECORD						
STATION	ELEVATION		DEPTH	MANHOLE	4-INCH "Y" BRANCHES		No. of Permit		House Number		DATE OF PERMITS	
	GROUND	GRADE			North West	South East	North West	South East	North West	South East	North West	South East
Sanitary Sewer for Quail Ridge Addition, Phase 1												
LINE 1	0+00 L-1	188.04	174.34 out	13.7	0+00							
		188.04	175.79 in	12.3								
	1+00	189.10	178.35	10.8		4" SCH 40 PVC 0+91 saddle 4" SCH 40 1+28.0	2000-02513	6331/33 Quail Ridge			11-17-00	
						4" SCH 40 2+45.0	2000-02297	6333 Quail Ridge			10-19-00	
	2+00	190.20	180.91	9.3			2000-02276	6317 Quail Ridge			10-19-00	
		191.76	183.26 out	8.5	2+92.0							
		191.76	183.36 in	8.4								
	3+00	191.50	183.40	8.1								
	4+00	193.00	183.90	9.1								
		193.73	183.98 out	9.8	4+15.4							
		193.73	184.08 in	9.7								
	5+00	194.10	184.40	9.7								
	6+00	195.10	184.77	10.3								
		195.54	184.79 out	10.8	6+05.3							
		195.54	184.84 in	10.7								
	7+00	196.10	186.49	9.6								
	8+00	197.10	188.24	8.9								
	9+00	198.20	189.98	8.2			2448	6165 Quail Ridge			5-12-98	
		198.80	190.50 out	8.3	9+29.7	8" STUB SW 0.65						
		198.80	190.65 in	8.1								
	10+00	199.40	190.94	8.5		4" SCH 40 SADDLE 10+31.7	2000-02563	4046 Edinburg			11-21-00	
	11+00	200.40	191.36	9.0			3337	4068 Edinburg			9-24-98	
	12+00	201.40	186.81	14.6			3339	4078 Edinburg			9-24-98	
		202.23	191.93 out	10.3	12+35.8							
		202.23	192.03 in	10.2			3338	4074 Edinburg			9-24-98	
	13+00	202.40	192.28	10.1								
							3340	4112 Edinburg			9-24-98	
	14+00	203.40	192.68	10.7								
							3287	4126 Edinburg			3-19-99	
	15+00	204.40	187.23	17.2			3393	4148 Edinburg			8-3-98	
		204.97	193.17	11.8	15+25.8							
LINE 2	0+00 L-2	195.54	184.84	10.7	0+00 = 9+28.5 L-1							
	1+00	196.10	185.24	10.9			3487	6163 Quail Ridge			12-19-97	
									6201 Quail Ridge		5-12-98	
	2+00	197.20	185.64	11.6				1999-00322	6255 Quail Ridge		8-2-99	
		197.89	185.74 out	12.2	2+25.9							
		197.89	185.79 in	12.1			3185	1999-00323 6167 Quail Ridge	6249 Quail Ridge		8-21-97	8-2-99
	3+00	198.20	186.09	12.1								
							3186	3433 6171 Quail Ridge	6248 Quail Ridge		8-21-97	4-16-98
	4+00	199.20	186.49	12.7								
		199.38	186.68	12.7	4+45.9							
LINE 3	0+00 L-3	191.76	183.46	8.3	0+00 = 2+92.0 L-1							
						4" SCH 40 0+74.0						
	1+00	192.40	183.85	8.5								
	2+00	191.60	184.24	7.4								
		191.59	184.29	7.3	2+11.6							
LINE 4	0+00 L-4	188.50	180.30	8.2	0+00							
	1+00	189.60	181.40	8.2								
	2+00	189.60	182.51	7.1			3277	6247 Quail Ridge			2-15-99	
	3+00	189.60	183.61	6.0								
		190.20	183.70 out	6.5	3+08.2	5" SCH 40 PVC 4" stub				6240 Quail Ridge		1-8-98
		190.20	183.80 in	6.4				3485	6248 Quail Ridge		12-12-97	
	4+00	192.20	185.45	6.7								
	5+00	194.60	187.25	7.3			5" SCH 40 PVC 1999-00350	3479	6211 Quail Ridge	6246 Quail Ridge	7-9-99	12-8-97
	6+00	197.30	189.05	8.2				3289	3478 6201 Quail Ridge	6204 Quail Ridge	3-19-99	12-8-97
	CONT ON N-266							3288	3468 6177 Quail Ridge	6154 Quail Ridge	3-19-99	3-16-98