
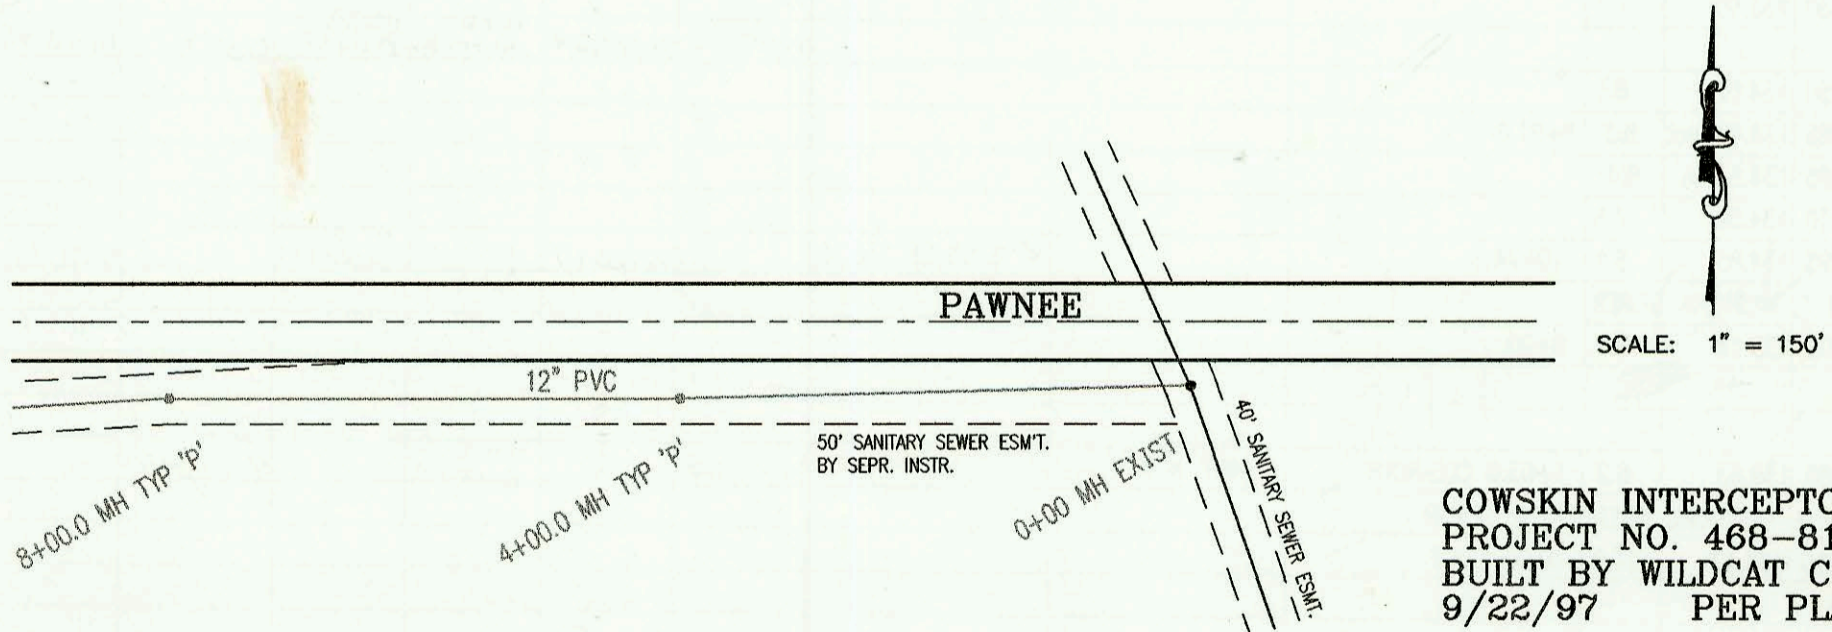



Private Sanitary Sewer Extension to serve (Phase 3)  
 Lot 1, Blk. 1, River Oaks Mobile Home Park  
 PROJECT NO. 690PPS  
 BUILT BY W. B. CARTER CONSTRUCTION CO.  
 9/17/97 PER AS BUILT PLAN

SCALE: 1" = 150'

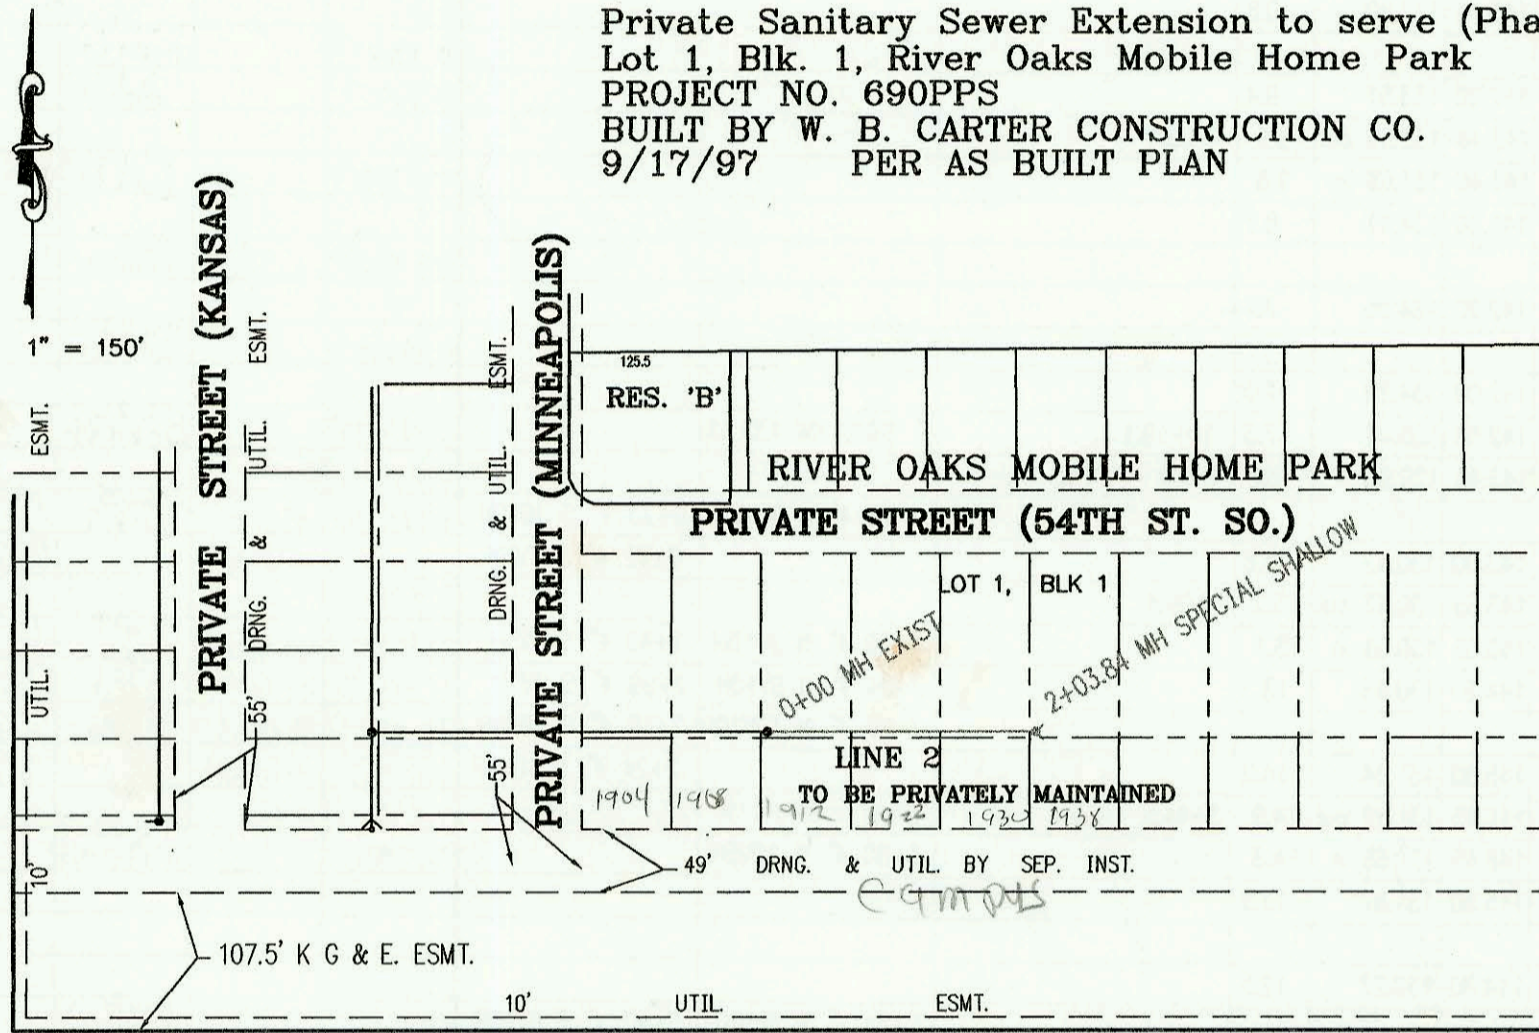

SCALE: 1" = 150'

COWSKIN INTERCEPTOR SEWER  
 PROJECT NO. 468-81838 (607739)  
 BUILT BY WILDCAT CONSTRUCTION CO.  
 9/22/97 PER PLAN

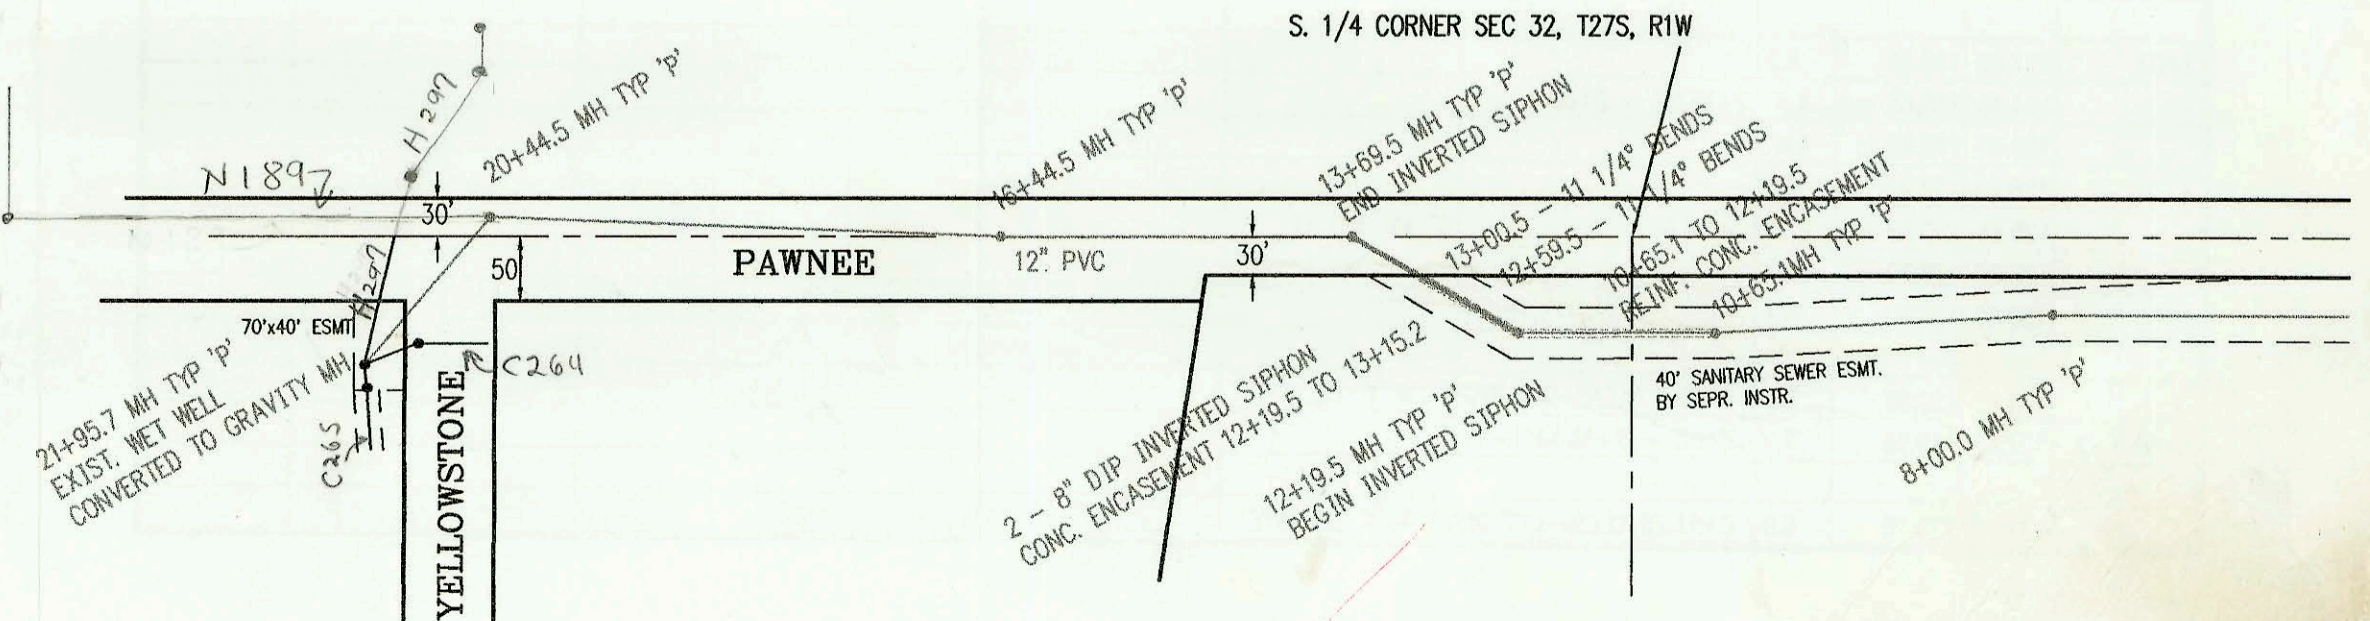

S. 1/4 CORNER SEC 32, T27S, R1W

