

Mobile Home Park

3434 W 44th St

UNPLATTED


CITY MAIN LINES (in easement) OR

SCALE: 1" = 100'

SANITARY SEWER EXTENSION TO SERVE COTTONWOOD GROVE 2ND ADDITION PROJECT NO. 697PPS BUILT BY ALAN'S EXCAVATING BOOKED 9/25/97 PER AS BUILT PLAN

SCALE: 1" = 100'

SANITARY SEWER TO SERVE KANSAS MASONIC ASSISTED LIVING FACILITY PROJECT NO. 699PPS BUILT BY McCULLOUGH EXCAVATION BOOKED 11/3/97 PER AS BUILT PLAN

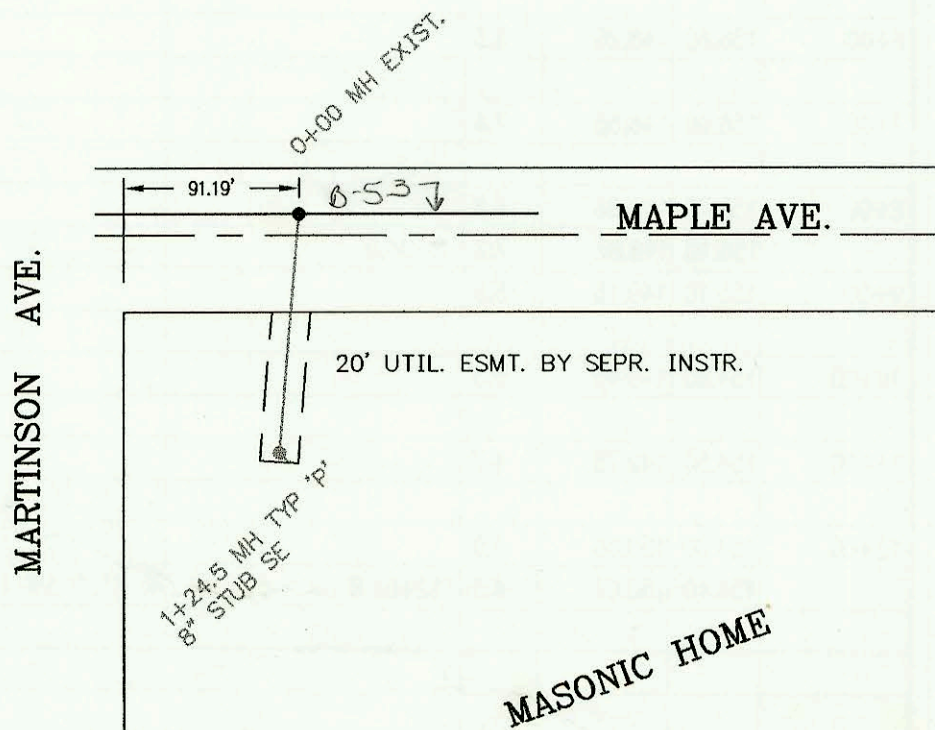

CONSTRUCTION RECORD					SERVICE RECORD								
STATION	ELEVATION		DEPTH	MANHOLE	4-INCH "Y" BRANCHES		No. of Permit		House Number		DATE OF PERMITS		
	GROUND	GRADE			North West	South East	North West	South East	North West	South East	North West	South East	
SANITARY SEWER TO SERVE COTTONWOOD GROVE 2ND ADDITION													
0+00 L-1	97.00	89.73	7.3	0+00 EXIST	Common Address: 3434 W 44th St S.								
1+00	97.20	89.96	7.2										
2+00	96.80	90.18	6.6										
3+00													
	96.70	90.43 out	6.3	3+07.78	4" STUB S 90.63								
0+00 L-2	95.80	88.92	6.9	0+00 EXIST									
	95.60	89.08	6.5										
1+00	96.00	89.15	6.9										
	96.53	89.33 out	7.2	1+59.18									
	96.53	89.33 in	7.2										
2+00	96.50	89.46	7.0										
3+00	96.50	89.78	6.7										
4+00	96.40	90.10	6.3										
	96.43	90.27	6.2	4+51.27	4" STUB W 90.43								
0+00 L-3	94.80	88.26	6.5	0+00 EXIST									
	95.10	89.82 out	5.3	0+46.2									
	95.10	89.87 in	5.2										
1+00	93.80	89.99	3.8										
2+00	96.50	90.31	6.2										
3+00													
	94.77	90.63 out	4.1	3+01.5									
	94.77	90.68 in	4.1										
4+00	96.50	90.96	5.5										
5+00	96.20	91.24	5.0										
6+00	95.80	91.52	4.3										
	96.49	91.61	4.9	6+31.59									
6+94.28	97.14	91.86	5.3	CLEANOUT									
0+00 L-4	94.79	86.04	8.8										
	95.00	86.21	8.8										
1+00	94.40	86.58	7.8										
	94.37	86.74 out	7.6	1+36.59	4" SCH 40 1+45.59	2000- 00360	Lot # 401	2-8-2000					
	94.37	86.82 in	7.6		4" SCH 40 2+44.59	2000- 00361	Lot # 402	2-8-2000					
2+00	94.00	87.00	7.0		4" SCH 40 2+47.59	2000- 00362	Lot # 403	2-8-2000					
					4" SCH 40 3+40.09	2000- 00363	Lot # 404	2-8-2000					
3+00	94.50	87.26	7.2		4" SCH 40 3+63.09	2000- 00364	Lot # 405	2-8-2000					
					4" SCH 40 4+48.59	2000- 00365	Lot # 406	2-8-2000					
4+00	95.00	87.51	7.5		4" SCH 40 4+61.59	2000- 00366	Lot # 407	2-8-2000					
	95.60	87.76 out	7.8	4+96.21	4" SCH 40 5+98.21	2000- 00367	Lot # 408	2-8-2000					
	95.60	87.78 in	7.8		4" SCH 40 6+01.21	2000- 00368	Lot # 409	2-8-2000					
5+00													
6+00	95.20	88.02	7.2										
7+00	94.90	88.25	6.7										
	94.69	88.47 out	6.2	7+98.09	8" STUB E 88.50								
	94.69	88.50 in	6.2										
8+00													
9+00	95.00	88.92	6.1										
10+00	95.00	89.32	5.7										
11+00	95.20	89.73	5.5										
	96.23	89.99	6.2	11+63.98	4" STUB E 90.23								
SANITARY SEWER TO SERVE KANSAS MASONIC HOME ASSISTED LIVING FACILITY													
0+00	110.57	105.57	5.0	0+00 EXIST									
1+00	111.00	106.01	5.0										
	112.59	106.12	6.5	1+24.5	8" STUB SE 106.22								