



N-281A

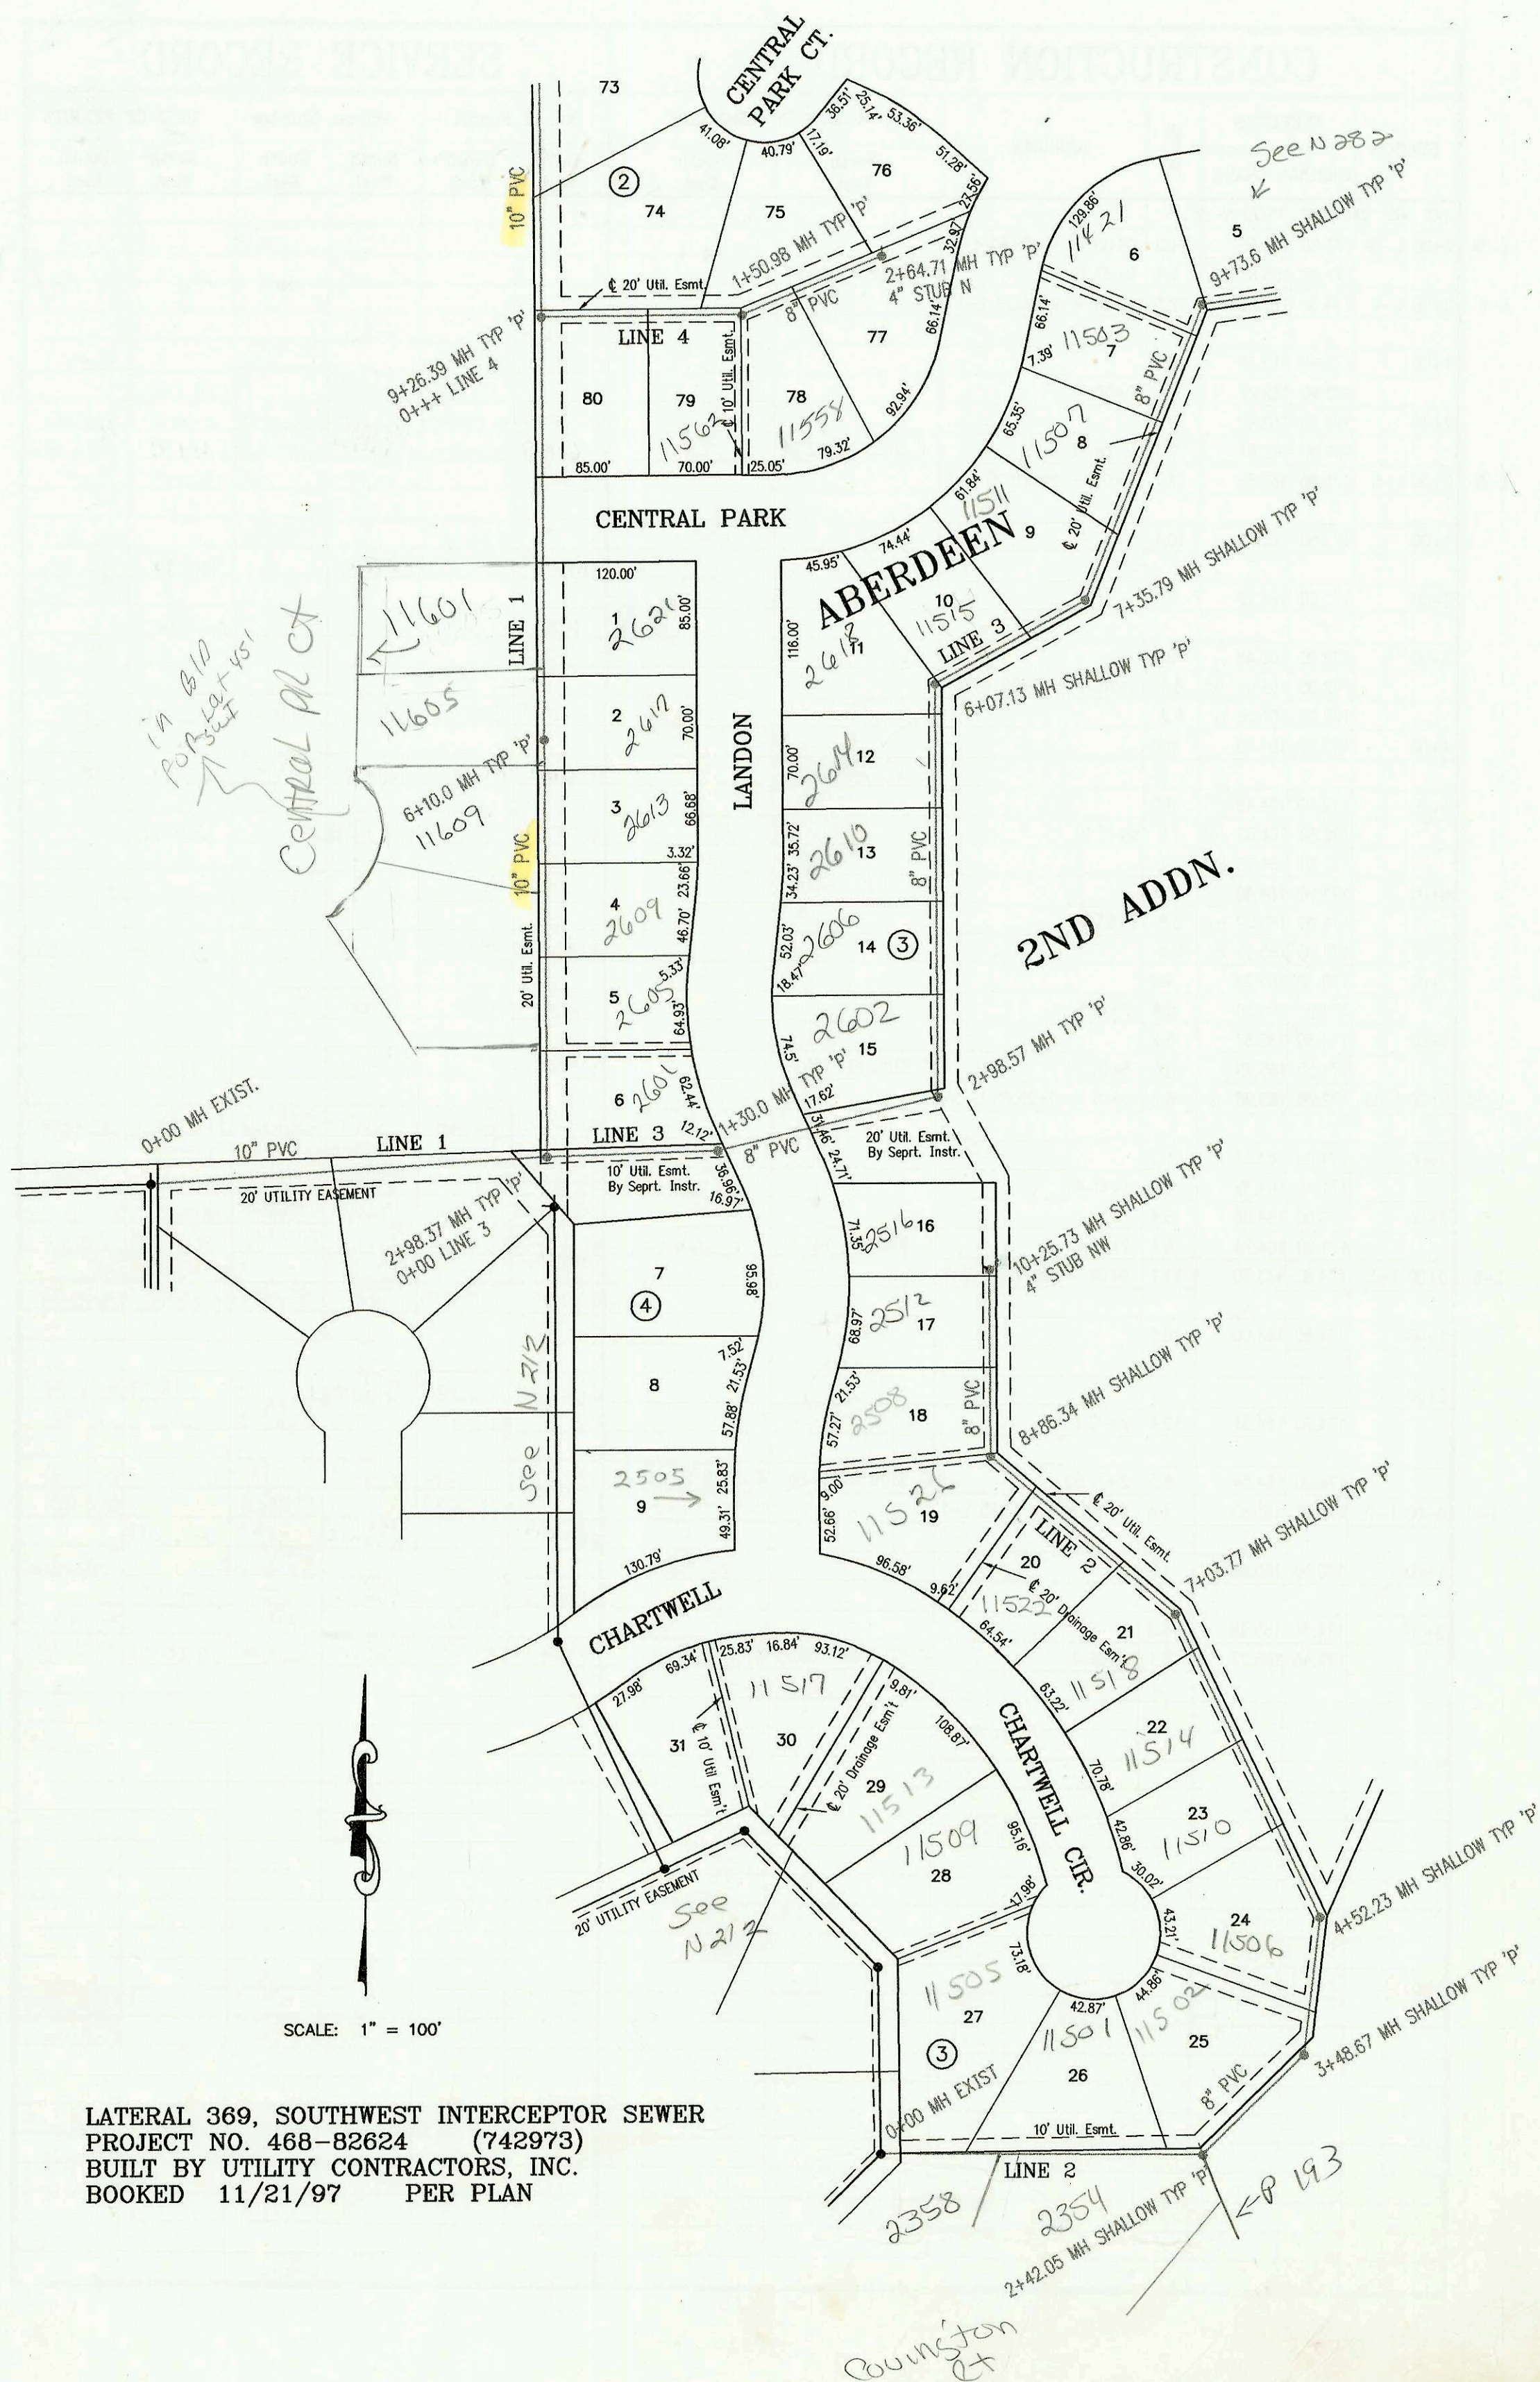

CONSTRUCTION RECORD							SERVICE RECORD					
STATION	ELEVATION		DEPTH	MANHOLE	4-INCH "Y" BRANCHES		No. of Permit		House Number		DATE OF PERMITS	
	GROUND	GRADE			North West	South East	North West	South East	North West	South East	North West	South East
LATERAL 369, SOUTH-WEST INTERCEPTOR				SEWER								
0+00 L-1	171.10	159.70	11.4	0+00 EXIST								
1+00	170.90	159.90	11.0									
2+00	171.00	160.10	10.9									
	168.40	160.30 out	8.1	2+98.37				9883687		2601 London		5-5-98
	168.40	160.40 in	8.0					1999-00399		2605 London		8-6-99
3+00												
4+00	170.20	160.60	9.6							2609 London		5-28-99
5+00	170.70	160.80	9.9			4" SCH 40 5+39 Saddle		2000-02604		2603 London		11-29-00
6+00	171.70	161.00	10.7					2001-02128	985427	11609 W Central PKT	2617 London	8-27-01 4-8-98
	172.30	161.02	11.3	6+10.0								
7+00	173.20	161.20	12.0		4" SCH 40 6+21 Saddle			2001-01093	9835367	11605 W Central PKT	2681 London	5-3-01 3-6-98
8+00	173.80	161.40	12.4		4" SCH 40 6+72 Predco			2001-01376		11601 W Central PKT		6-6-01
9+00	174.00	161.60	12.4									
	174.30	161.65	12.7	9+26.39 = 0+00 L-4								
10+00	174.20	161.80	12.4									
11+00	174.60	162.00	12.6				10+80 4" E 7V14H		99-34467	11538 PL Central PKT		2-24-99
	175.40	162.15	13.3	11+75.0				2001-02352		2718 PARKADE		10-5-01
12+00	175.10	162.20	12.9				11+80 4" E 6V14H		9883547	11534 Central PKT		5-5-98
							12+47 4" E 6V14H					
13+00	175.70	162.40	13.3									
							13+30 4" E 7V14H		98-15077	11526 Central PKT		2-29-98
14+00	175.70	162.60	13.1		14+22.5 4" W 8 V 26 H			2002-02054		2754 PARKADE		7-21-02
	175.60	162.78	12.8	14+89.15 = 0+00 L-5								
15+00	175.20	162.80	12.4									
16+00	175.50	163.00	12.5				16+65 4" E 7V14H	2002-01481		11610 W RYAN PL		5-24-02
17+00	175.40	163.20	12.2		17+78 4" W 7.5' V 26 H			2002-01441		11614 W RYAN PL		5-22-02
18+00	175.10	163.41	11.7									
	174.80	163.43	11.4	18+12.15 = 0+00 L-6								
19+00	174.60	163.60	11.0						9869857	11551 RYAN CR		4-20-98
20+00	174.20	163.80	10.4									
					20+94 4" W 6' V 26 H			2002-02246		11606 RYAN PL		8-15-02
21+00	173.90	164.00	9.9		21+09 4" W 6 V 26 H			2002-01724		11630 RYAN PL		6-19-02
	174.30	164.05 out	10.3	21+25.15					98-1887	11528 RYAN CR		10-2-98
	174.30	164.15 in	10.2									
22+00	172.00	164.30	7.7					2002-02246		11624 RYAN		8-15-02
23+00	170.90	164.50	6.4						98-176737	11529 RYAN CR		9-21-98
	171.10	164.60	6.5	23+50.0					98240867	11522 RYAN CR		12-17-98
24+00	170.50	164.70	5.8						98149487	11518 RYAN CR		8-6-98
25+00	170.00	164.90	5.1		4" SCH 40 25+37.15	4" SCH 40 25+36.15		2000-00191	2000-00190	11510 RYAN CR	11514 RYAN CR	1-21-00 1-21-00
26+00	169.80	165.10	4.7									
	170.20	165.21	5.0	26+53.15 = 0+00 L-7								
27+00	169.40	165.30	4.1						9881357	2820 SHEFFORD		5-5-98
28+00	169.40	165.50	3.9									
29+00	169.90	165.71	4.2									
	170.70	165.86 out	4.8	29+77.16	8" STUB N 166.13	8" STUB E 166.13				2816 SHEFFORD	2812 CARDINGTON	6-16-98 9-21-99
	170.70	166.13 in	4.6					98-	99-009287			
30+00	170.60	166.20	4.4									
						4" SCH 40 30+93.16		9869807	99009947	2812 SHEFFORD	2894 CARDINGTON	4-20-98 10-21-99
31+00	171.70	166.50	5.2			4" SCH 40 31+29.37			2000-01148	2885 CARDINGTON		6-20
	172.90	166.75	6.1	31+82.37	4" SCH 40 32+12.33	4" SCH 40 32+27.33		9900976	2000-01484	2886 SHEFFORD	2891 CARDINGTON	10-21-99 6-20
32+00	172.50	166.80	5.7									
	173.40	167.04	6.4	32+79.33		4" STUB SW 167.23			2000-01893		2804 CARDINGTON	8-24-00
CONT. ON N-281												

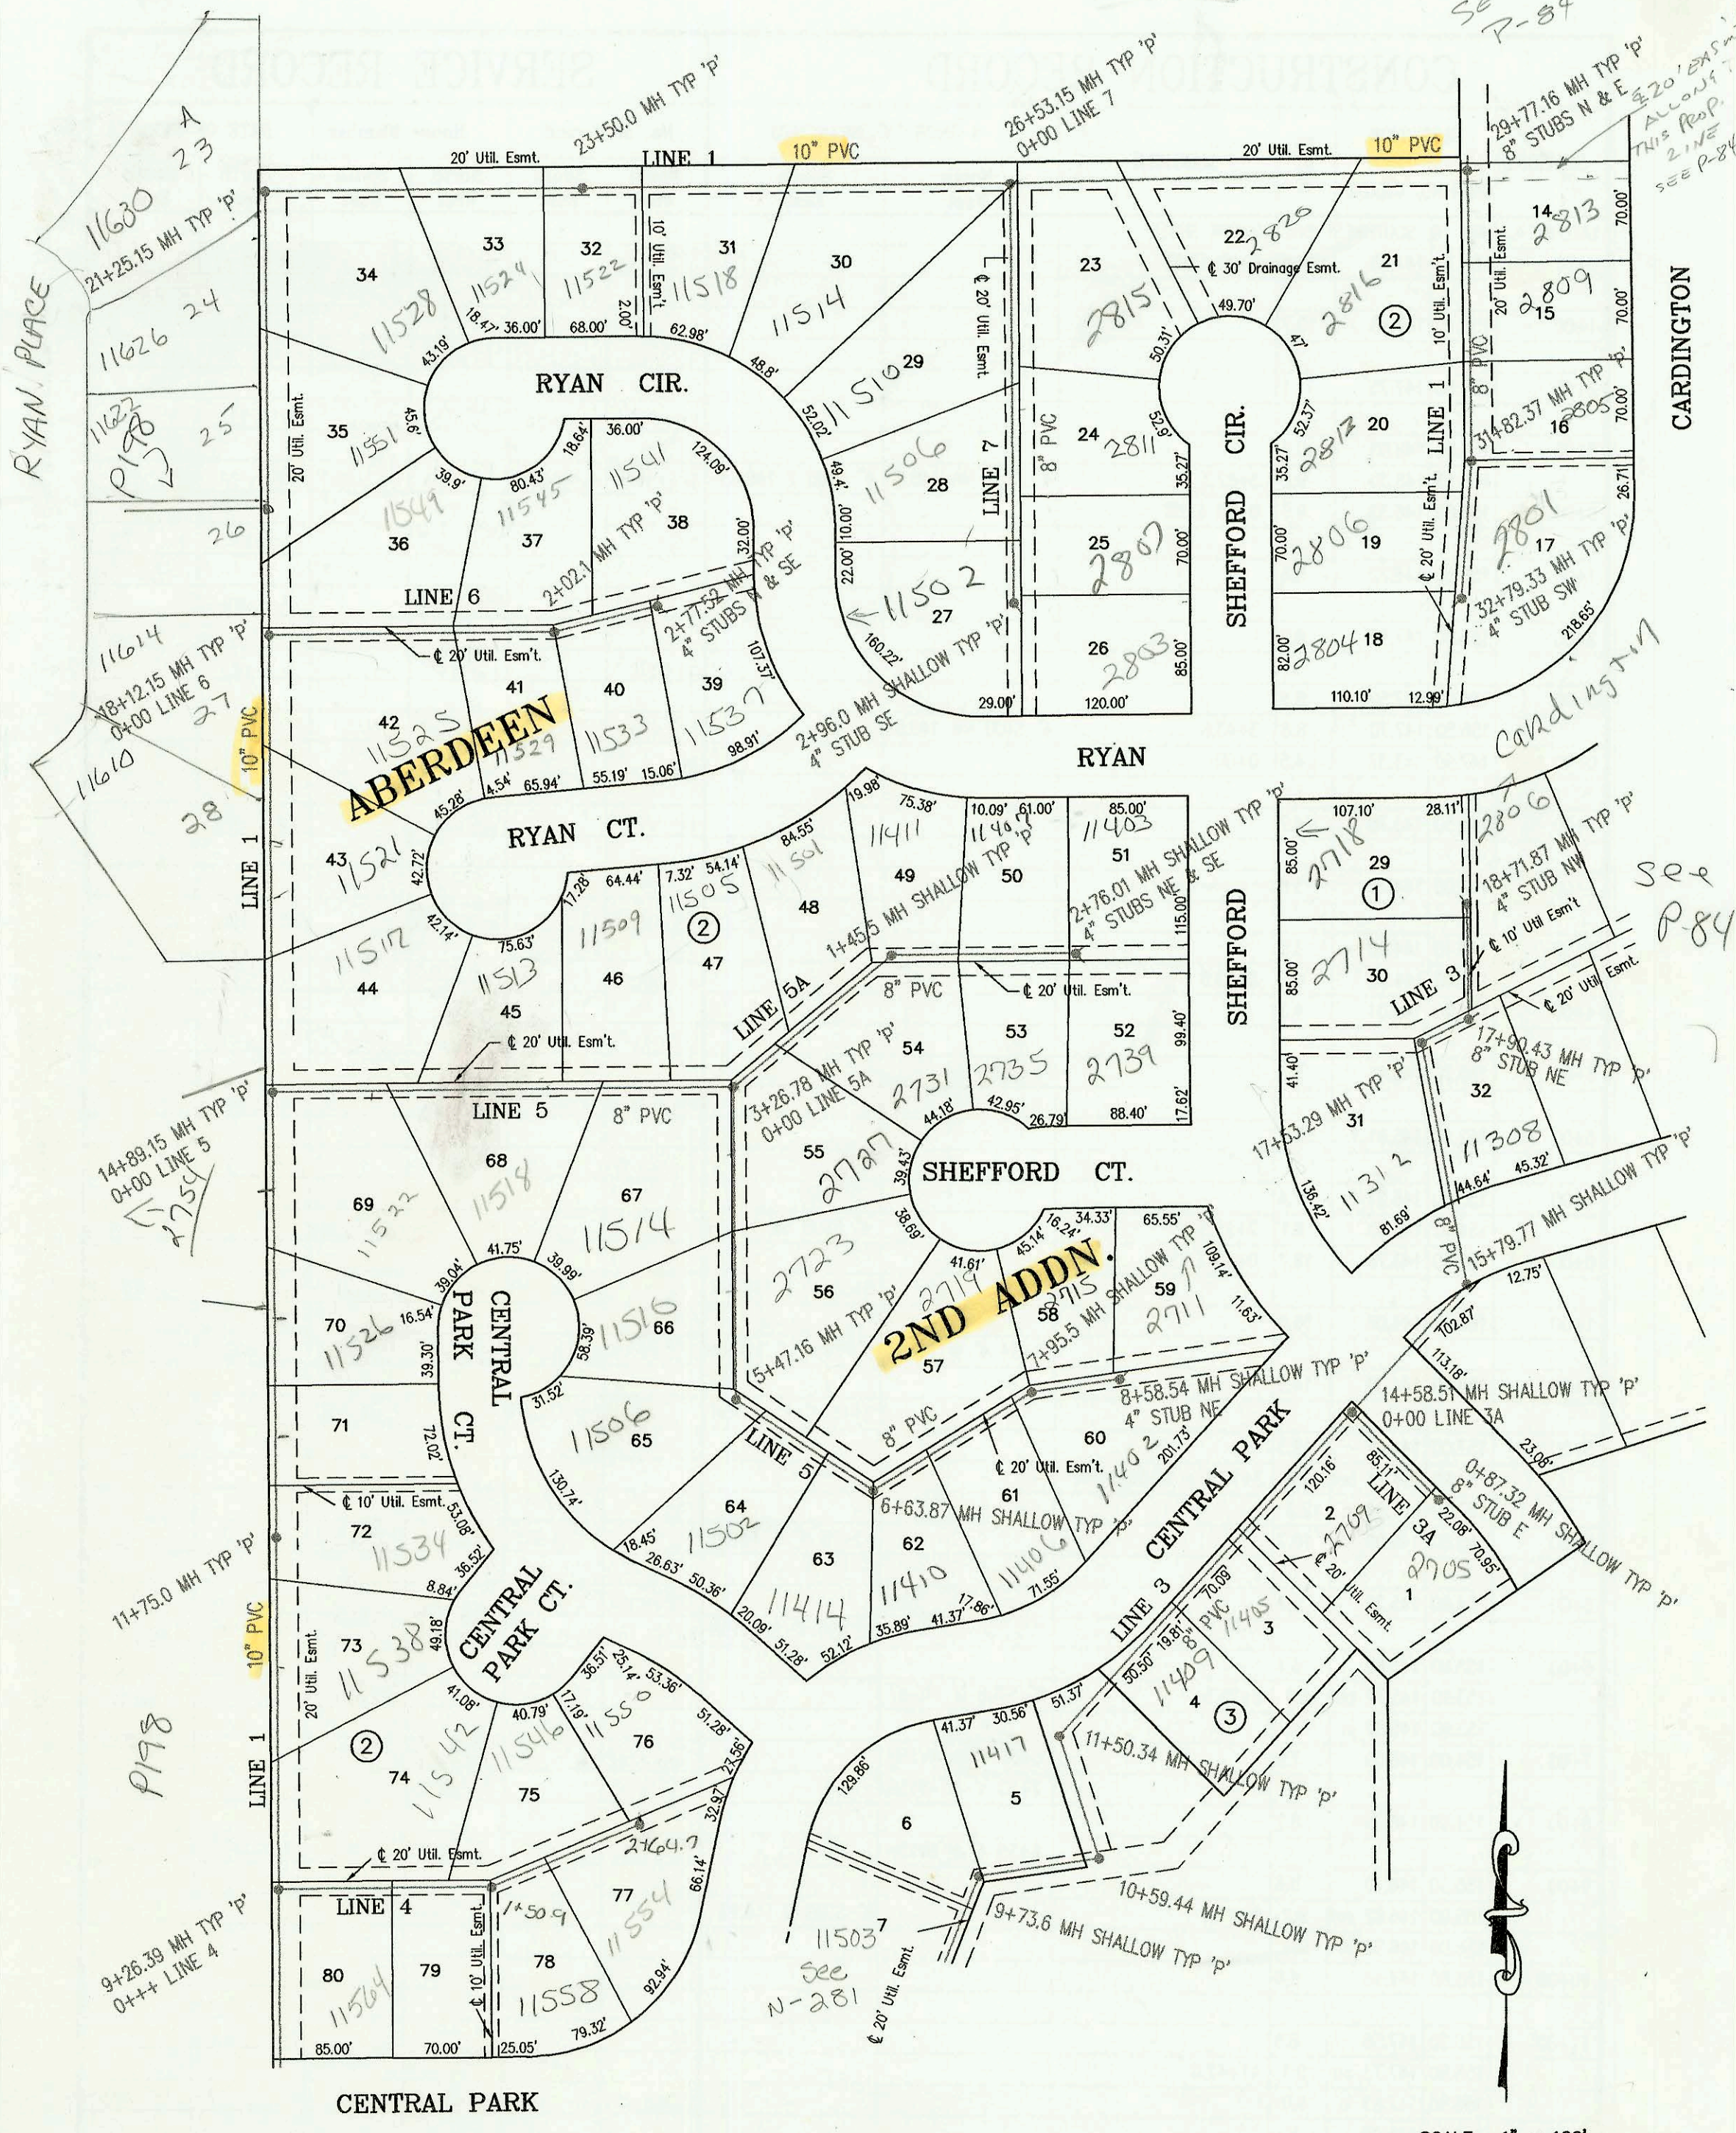

SCALE: 1" = 100'

LATERAL 369, SOUTHWEST INTERCEPTOR SEWER
 PROJECT NO. 468-82624 (742973)
 BUILT BY UTILITY CONTRACTORS, INC.
 BOOKED 11/21/97 PER PLAN

CONSTRUCTION RECORD						SERVICE RECORD						
STATION	ELEVATION		DEPTH	MANHOLE	4-INCH "Y" BRANCHES		No. of Permit		House Number		DATE OF PERMITS	
	GROUND	GRADE			North West	South East	North West	South East	North West	South East	North West	South East
LAT 369, SW	CONT.	FROM N-281										
0+00 L-3A	170.50	165.55	4.9	0+00 = 14+58.51 L-3								
	171.20	165.81	5.4	0+87.32	8" STUB E 165.91							
0+00 L-4	174.30	161.82	12.5	0+00 = 9+26.39 L-1								
1+00	172.40	162.12	10.3			4" sch 40 1+06.3	98-31082		11542 Central PK	11562 Central PK		3-2-98
	172.40	162.27	10.1	1+50.98			99-58797		11542 Central PK		3-31-99	
2+00	171.70	162.42	9.3				98-23237	98-160067	11546 Central PK	11558 Central PK	12-3-98	8-28-98
	171.90	162.61	9.3	2+64.71	4" STUB N 162.94		99-61447	98-220437	11550 Central PK	11551 Central PK	4-1-99	11-16-98
0+00 L-5	175.60	162.88	12.7	0+00 = 14+89.15 L-1			98-18107		11547 Ryan Ct		2-2-98	
1+00	173.50	163.08	10.4			4" sch 40 0+70		99-00690		11522 Central PK		9-16-99
					4" sch 40 1+48		99-00689		11513 Ryan Ct		9-16-99	
2+00	173.00	163.28	9.7									
							98-18787		11509 Ryan Ct		10-2-91	
3+00	172.00	163.48	8.5									
	172.20	163.86 out	8.3	3+26.78 = 0+00 L-5A								
	172.20	163.96 in	8.2		4" sch 40 3+73.78		99-01121	99-01411	11514 Central PK	11517 Shefford	11-5-99	12-7-99
4+00	172.20	164.18	8.0		4" sch 40 4+67.78		99-01122	99-000051	11519 Central PK	11523 Shefford	11-5-99	6-24-99
5+00	172.50	164.48	8.0									
	172.50	164.62 out	7.9	5+47.16			98-18952		11506 Central PK		2-9-98	
	172.50	164.72 in	7.8									
6+00	171.50	164.88	6.6		4" sch 40 lot 55.87 saddle			2001-00871		11414 W Central PK		4-12-01
	171.00	165.07 out	5.9	6+63.87								
	171.00	165.17 in	5.8				99-96307	99-09175	11419 Shefford	11410 Central PK	5-10-99	10-21-99
7+00	170.10	165.28	4.8				2002-00518	98-98377	11403 Shefford	11402 Central PK	3-4-02	1-23-97
	171.20	165.56	5.6	7+95.5								
8+00	170.80	165.57	5.2									
	171.50	165.75	5.8	8+58.54	4" STUB NE 165.75		98-176747		11411 Shefford		9-21-98	
0+00 L-5A	172.20	163.96	8.2	0+00 = 3+26.78 L-5A		4" sch 40 3+79.78	98-21687	99-01411	11505 Ryan Ct	11507 Shefford	11-11-98	12-7-99
1+00	171.00	164.26	6.7				99-55577		11501 Ryan Ct		3-14-99	
	171.10	164.39	6.7	1+45.45			98-18367	98-60797	11411 Ryan	11412 Shefford	7-2-98	4-20-98
2+00	170.00	164.56	5.4				99-38377	99-60477	11407 Ryan	11408 Shefford	3-3-99	1-11-99
	171.20	164.78	6.4	2+76.01	4" STUB NE 165.11	4" stub SE	98-185627	98-90667	11403 Ryan	11404 Shefford	8-21-98	5-21-98
0+00 L-6	174.80	163.70	11.1	0+00 = 18+12.15 L-1								
							98-112597	99-96317	11544 Ryan	11525 Ryan Ct	6-24-98	5-10-99
1+00	174.60	164.00	10.6									
2+00							99-68307	99-68297	11545 Ryan Ct	11529 Ryan Ct	4-16-99	4-16-99
	174.70	164.31	10.4	2+02.1				99-109587	11533 Ryan Ct			5-24-99
	174.00	164.54	9.5	2+77.52	4" STUB N 164.86	4" STUB SE 164.86	99-92477	99-00974	11541 Ryan Ct	11537 Ryan	5-4-99	10-21-99
0+00 L-7	170.20	165.83	4.4	0+00 = 26+53.15 L-1				98-27677	11537 Shefford		2-19-98	
							2000-0191		11510 Ryan Ct		7-21-2000	
1+00	170.50	165.68	4.8			4" sch 40 1+59.0		2000-01872	11506 Ryan Ct	11507 Shefford		8-24-00
							98-90687					
2+00	171.30	165.98	5.3					2002-02821	11502 Ryan	11503 Shefford	5-21-98	07-16-02
	172.40	166.27	6.1	2+96.0	4" STUB NE 166.53	4" stub SE	99-34467	98-18377	11502 Ryan	11503 Shefford	12-25-99	7-29-98