


PRIVATE SANITARY SEWER FOR WILLOWOOD ESTATES ADDITION
PROJECT NO. 696PPS
BUILT BY A-PLUS PLUMBING
12/23/97 PER AS BUILT PLAN

*Private Maint by
Mobile PARK*



SCALE: 1" = 150'

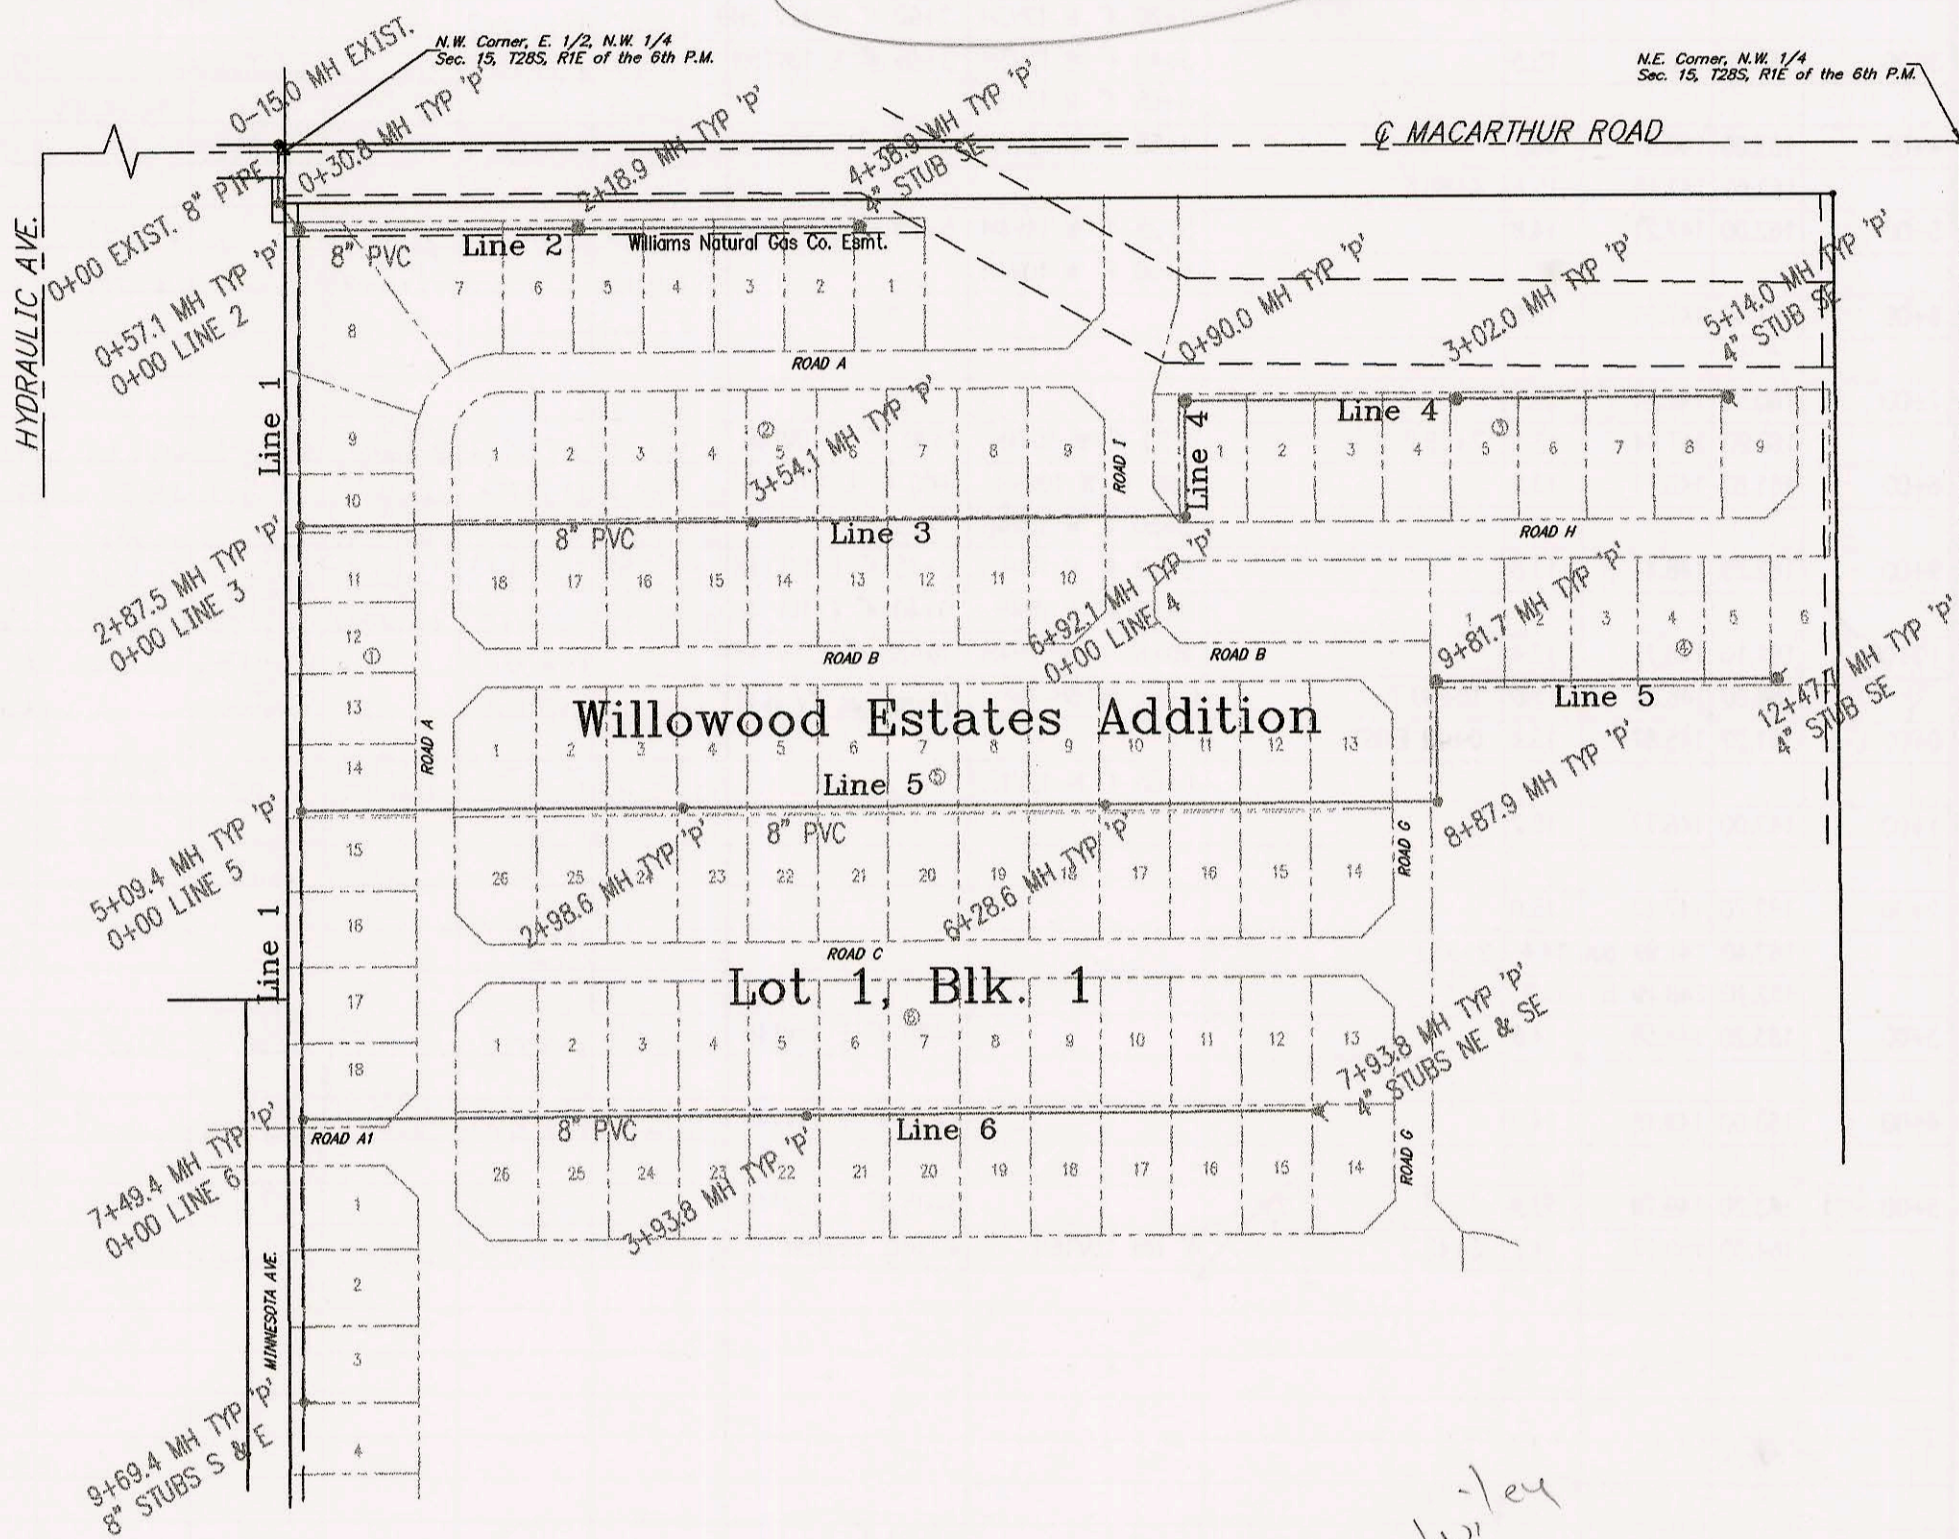

Stanley Wiley

4148 S Hydraulic

CONSTRUCTION RECORD						SERVICE RECORD						
STATION	ELEVATION		DEPTH	MANHOLE	4-INCH "Y" BRANCHES		No. of Permit		House Number		DATE OF PERMITS	
	GROUND	GRADE			North West	South East	North West	South East	North West	South East	North West	South East
PRIVATE SANITARY SEWER FOR WILLOWOOD ESTATES ADDITION												
0-15	84.00	74.45	9.6	0-15.0 EXIST								
0+00	83.50	74.50	9.0									
	85.21	74.62	10.6	0+30.8								
	85.03	74.89	10.1	0+57.1 = 0+00 L-2								
1+00	86.00	74.98	11.0									
2+00	87.00	75.21	11.8									
	87.52	75.40	12.1	2+87.5 = 0+00 L-3								
3+00	87.50	75.46	12.0									
4+00	87.40	75.90	11.5									
5+00	87.10	76.35	10.8									
	87.80	76.39 out	11.4	5+09.4 = 0+00 L-5								
	87.80	76.49 in	11.3									
6+00	87.00	76.67	10.3									
7+00	85.90	76.87	9.0									
	85.70	76.97 out	8.7	7+49.4 = 0+00 L-6								
8+00	84.60	77.00	7.6									
9+00	86.40	77.52	8.9									
	88.34	77.88	10.5	9+69.4	8" STUB E 77.98	8" STUB S 77.88						
0+00 L-2	85.03	75.89	9.1	0+00 = 0+57.1 L-1								
1+00	86.70	76.61	10.1									
2+00	86.50	77.53	9.0									
	86.28	77.65	8.6	2+18.9								
3+00	86.00	78.41	7.6									
4+00	85.60	79.34	6.3									
	85.26	79.70	5.6	4+38.9								
0+00 L-3	87.52	75.50	12.0	0+00 = 2+87.5 L-1								
1+00	87.00	76.03	11.0									
					1+69 4" N	1+49 4" S						
2+00	87.00	76.55	10.4		2+19 4" N	2+04 4" S						
					2+74 4" N	2+59 4" S						
3+00	86.90	77.08	9.8		3+29 4" N	3+14 4" S						
	87.41	77.36	10.1	3+54.1								
4+00	86.80	77.49	9.3		3+84 4" N	3+69 4" S						
					4+39 4" N	4+24 4" S						
5+00	86.60	77.77	8.8		4+94 4" N	4+79 4" S						
					5+49 4" N	5+36 4" S						
6+00	85.30	78.06	7.2		6+04 4" N	5+89 4" S						
	85.55	78.32 out	7.2	6+92.1 = 0+00 L-4								
0+00 L-4	85.55	78.42 in	7.1	0+00 = 6+92.1 L-3								
	84.89	78.52 out	6.4	0+90								
	84.89	78.62 in	6.3									
1+00	84.50	78.66	5.8									
2+00	85.00	79.02	6.0									
3+00												
	85.59	79.39	6.2	3+02.0								
4+00	85.30	79.70	5.6									
5+00	85.50	80.02	5.5									
	86.23	80.06	6.2	5+14.0								
0+00 L-5	87.80	76.49	11.3	0+00 = 5+09.4 L-1								
1+00	86.50	76.86	9.6									
2+00	87.00	77.23	9.8									
					1+69 4" N	1+49 4" S						
					2+19 4" S	2+04 4" S						
					2+74 4" N	2+59 4" S						
	87.50	77.60	9.9	2+98.6								
CONT. ON N-284												

Line 5 - Lots D-1 thru D-13 - 98-0724-7 5-12-98
 Line 6 - Lots E-1 thru E-13 98-11346-7 - 6-29-98