



SCALE: 1" = 100'

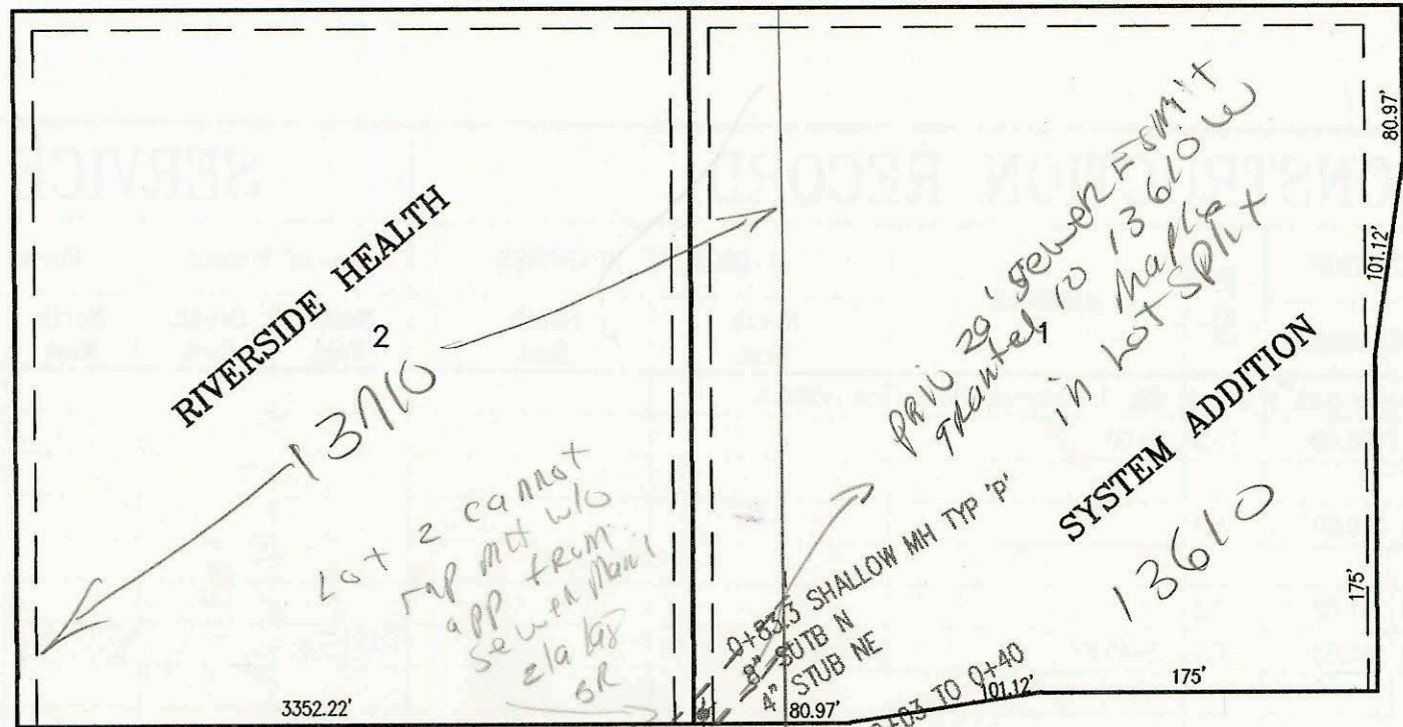

County Sewer  
0+00 SHALLOW MH TYP 'P'  
SANITARY SEWER TO SERVE - City Sewer  
RIVERSIDE HEALTH SYSTEM ADDITION  
PROJECT NO. 749PPS (607861)  
BUILT BY K. C. EXCAVATING, INC.  
BOOKED 1/5/98 PER AS BUILT PLAN

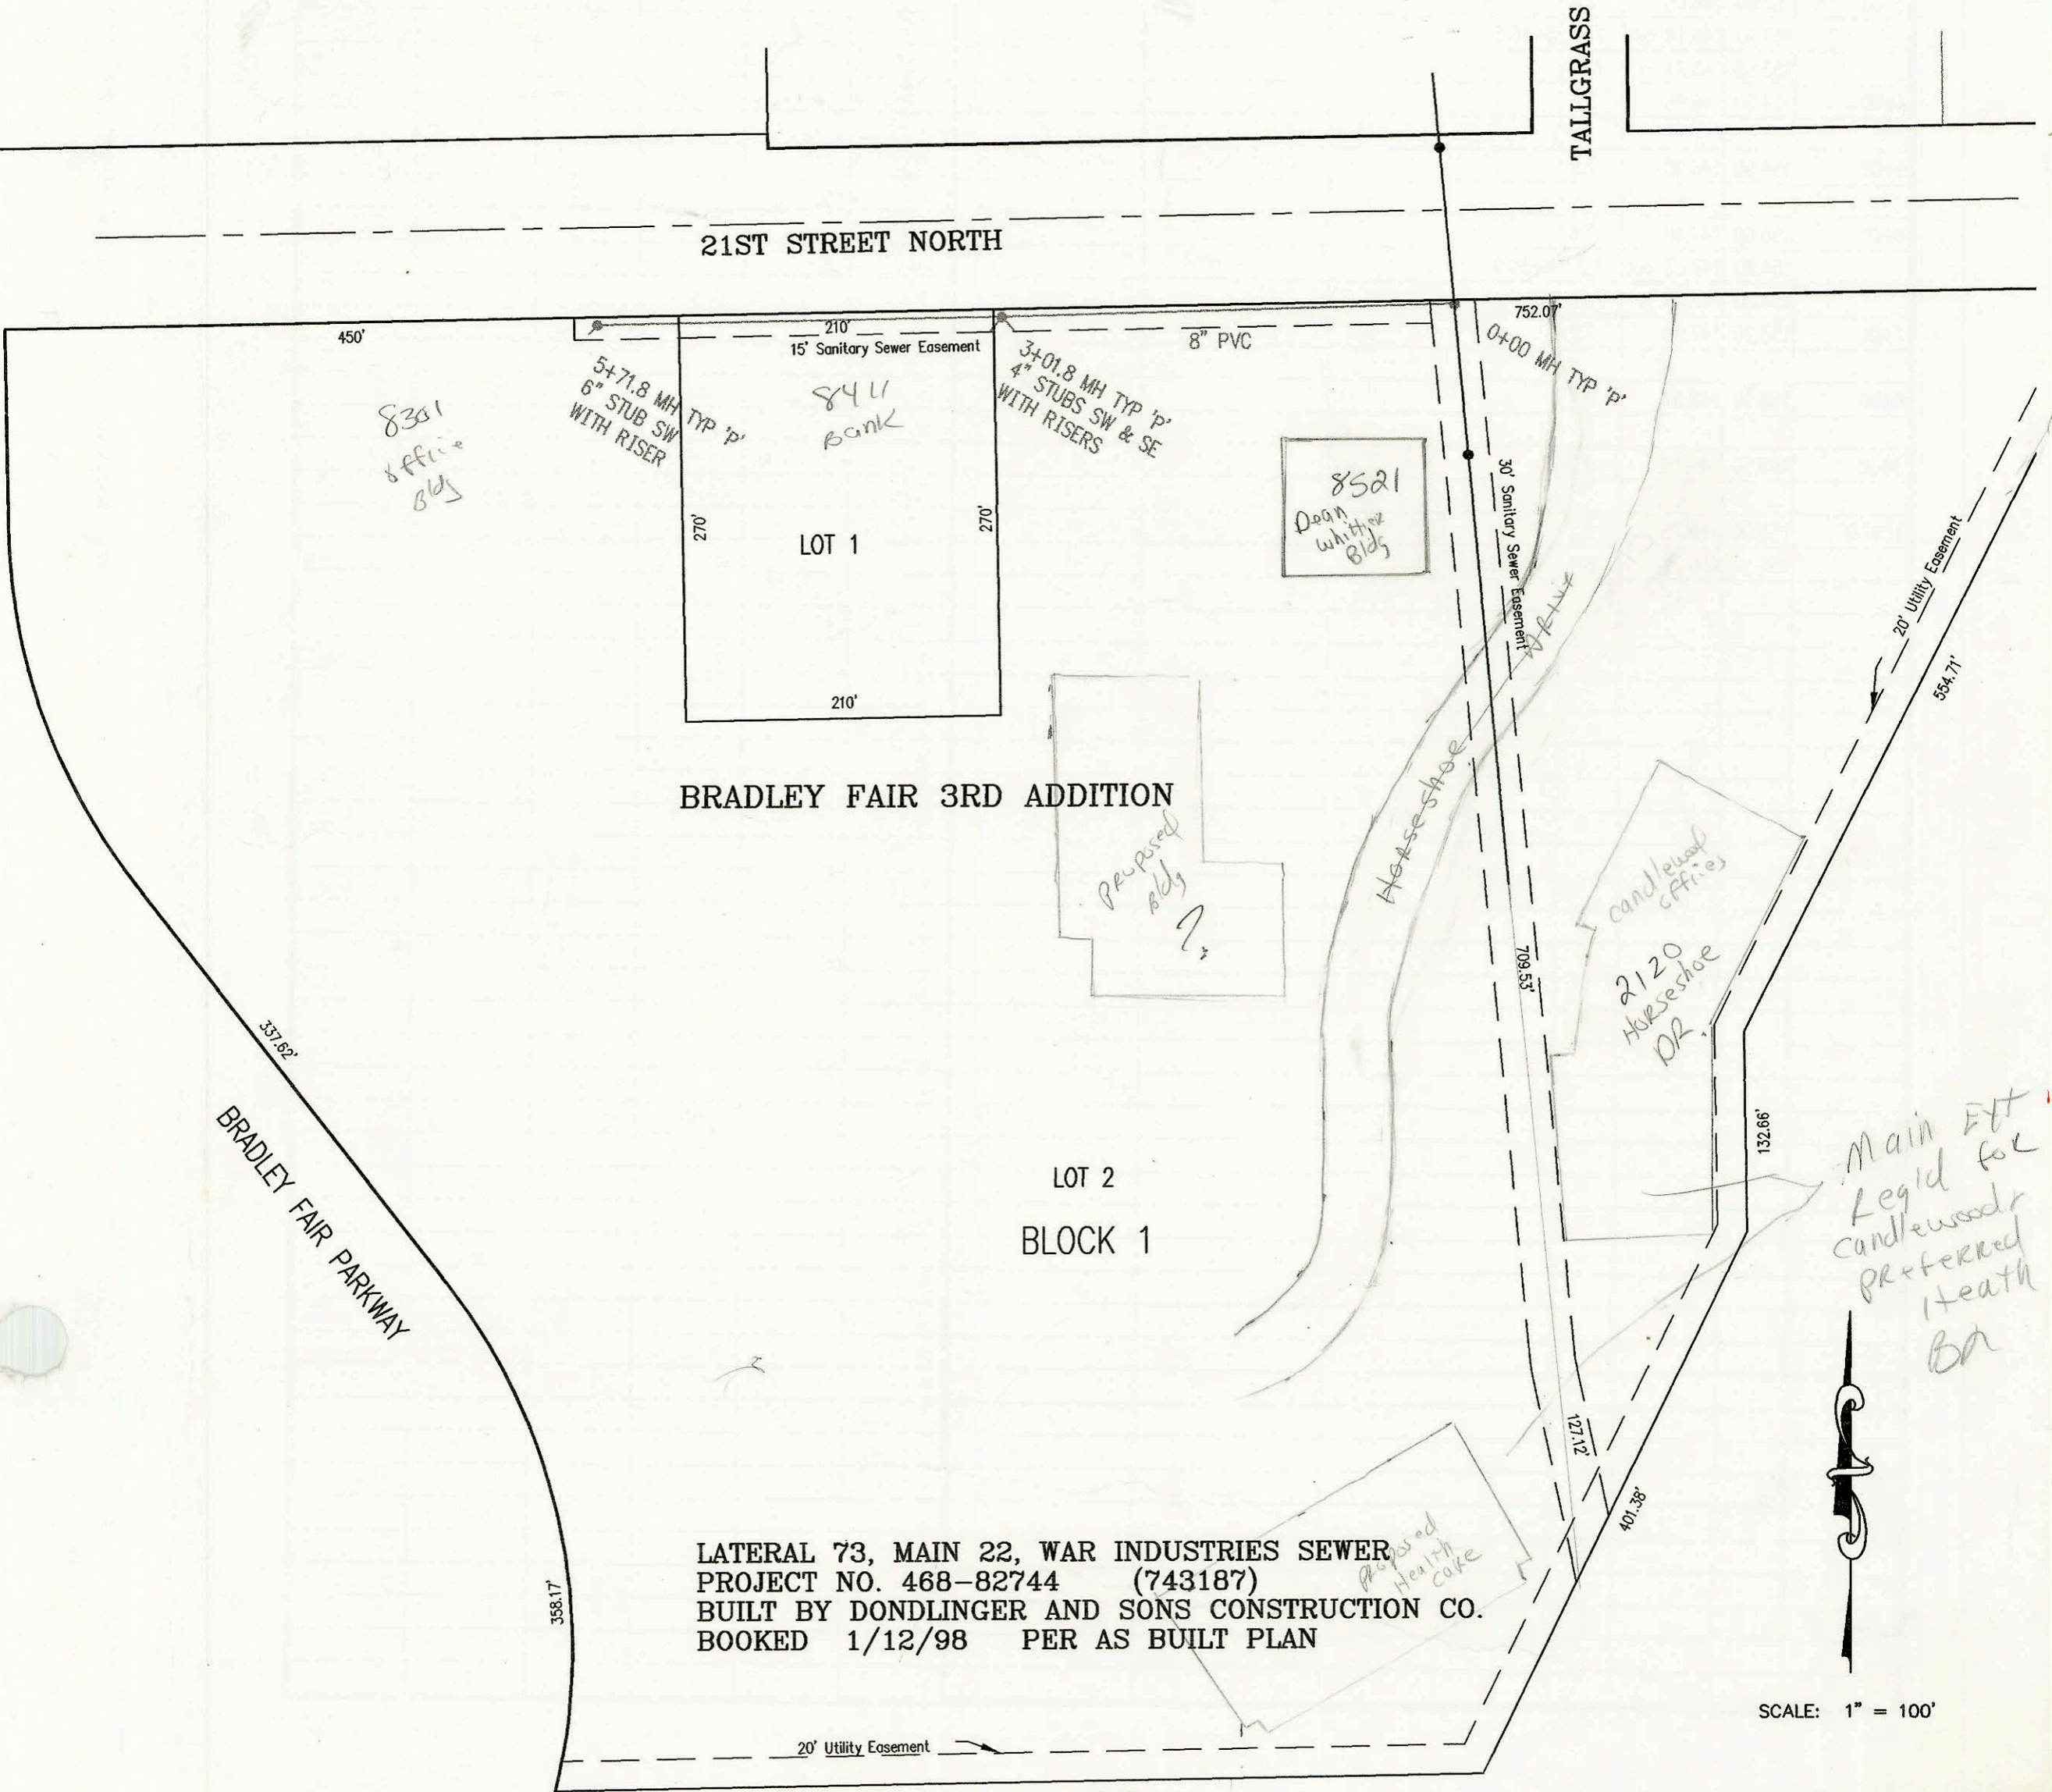

SCALE: 1" = 100'

