

UNPLATTED

45TH. ST. NORTH

11+10.86 MH TYP 'P'

12+92.20 MH TYP 'P'

UNION PACIFIC RAILROAD

113.1 LF 18\"/>

7+10.86 MH TYP 'P'

SW Cor., NE 1/4
Sec. 30, T26S, R2E

20' Sanitary Sewer Esmt.
by separate instr.

3+10.86 MH TYP 'P'

8\"/>

24\"/>

0+00 MH EXIST




SCALE: 1" = 100'

LATERAL 55, MAIN 9, SANITARY SEWER NO. 23
 PROJECT NO. 468-82712 (743153)
 BUILT BY ASSOCIATED CONSTRUCTION CO.
 BOOKED 2/4/98 PER PLAN

UNPLATTED

18+10.20 MH TYP 'P'
8\"/>

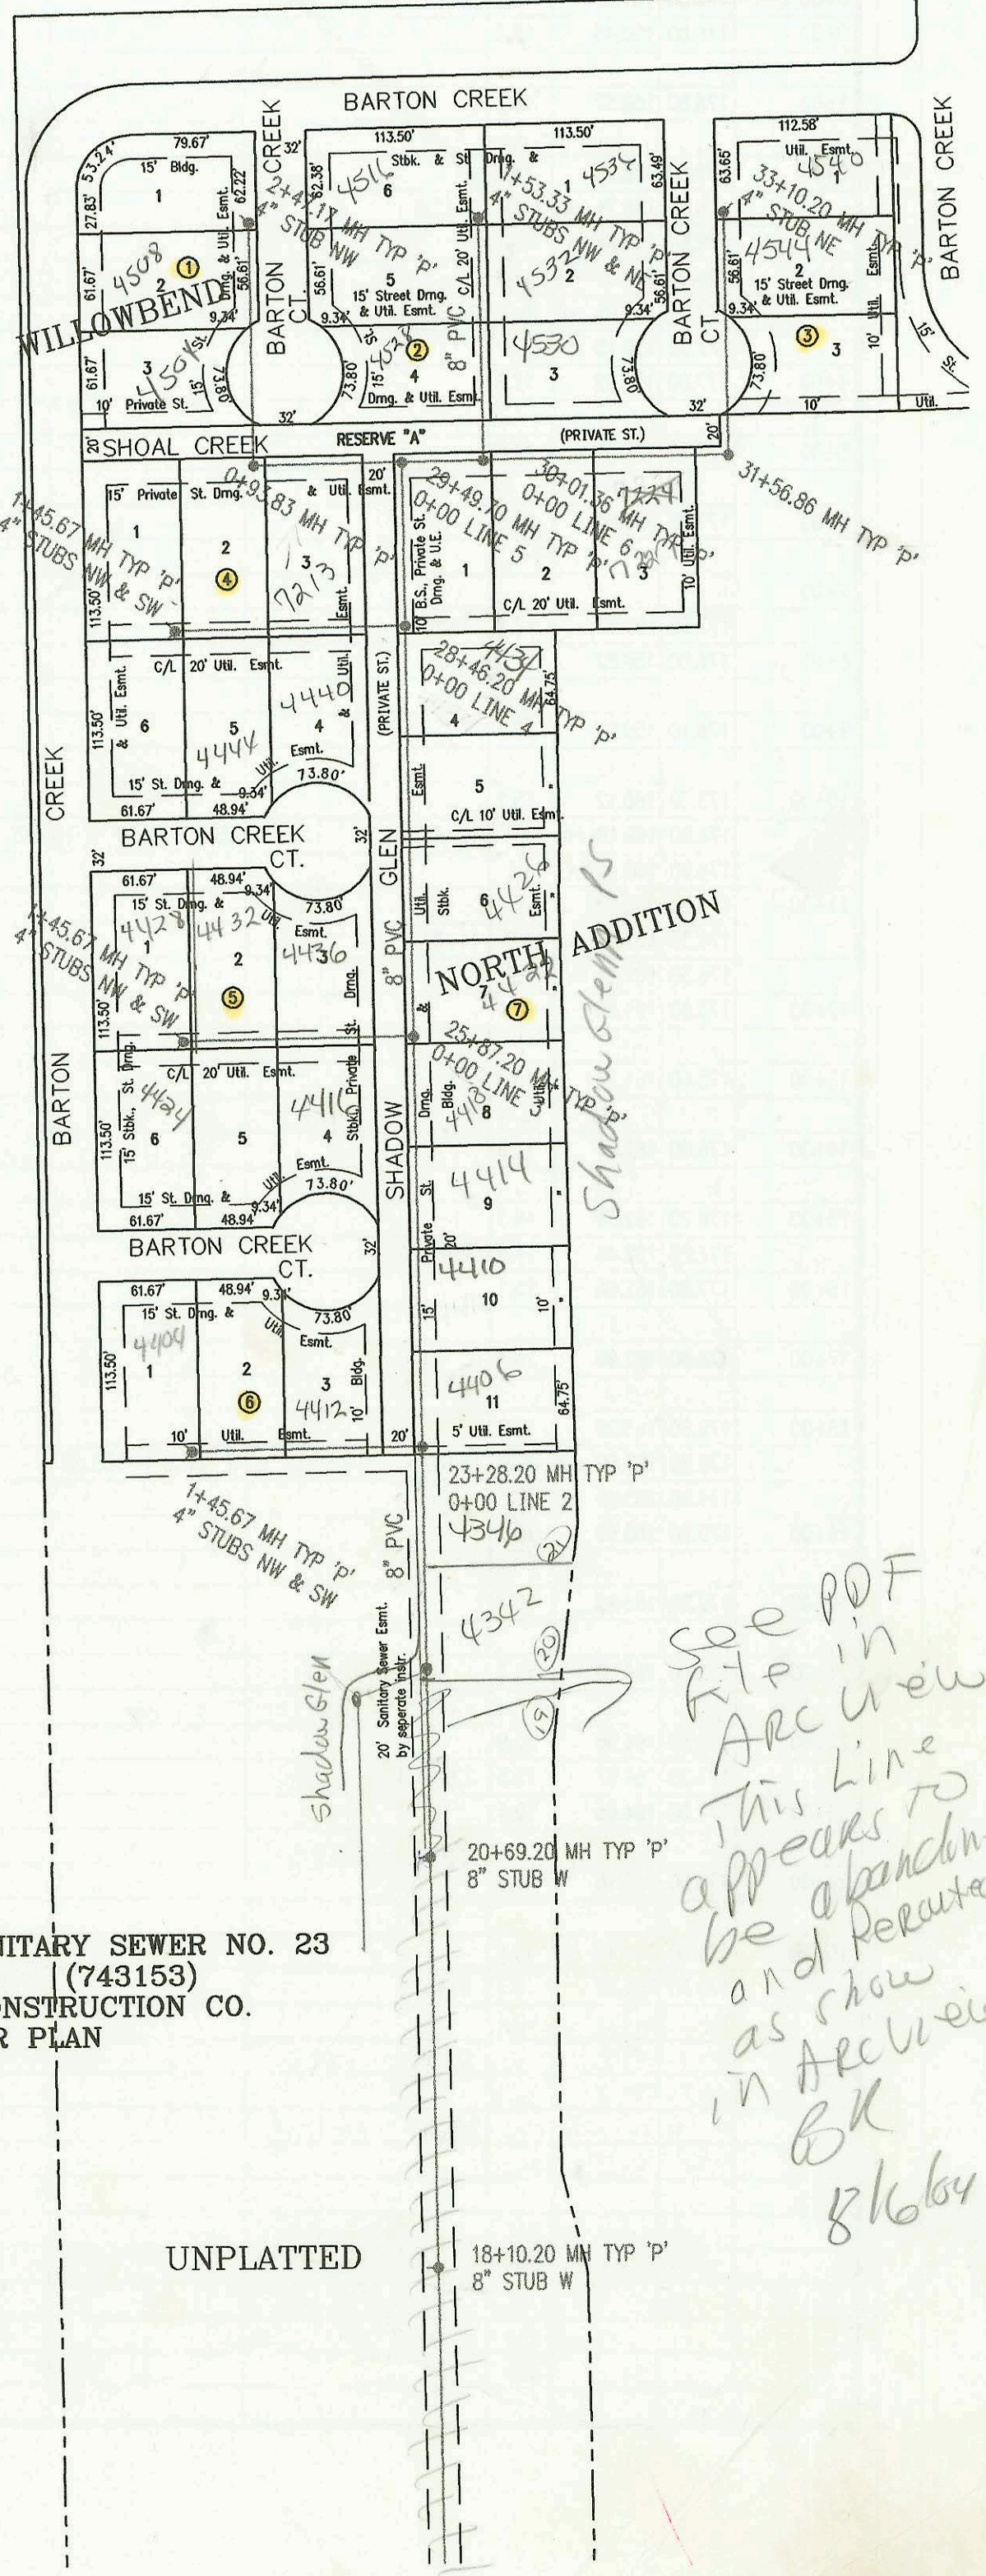

See PDF
 file in
 Arc view
 This line
 appears to
 be abandoned
 and rerouted
 as show
 in Arc view
 BK
 8/6/04

LINE 1

CONSTRUCTION RECORD						SERVICE RECORD							
STATION	ELEVATION		DEPTH	MANHOLE	4-INCH "Y" BRANCHES		No. of Permit		House Number		DATE OF PERMITS		
	GROUND	GRADE			North West	South East	North West	South East	North West	South East	North West	South East	
LAT 55, MAIN 9, SANITARY SEWER NO. 23													
0+00 L-1	174.07	164.35 out	9.7	0+00 EXIST									
	174.07	165.68 in	8.4										
1+00	172.00	166.08	5.9										
2+00	171.10	166.48	4.6										
3+00	172.60	166.88	5.7										
	172.99	166.98	6.0	3+10.88									
4+00	172.60	167.38	5.2										
5+00	173.50	167.78	5.7										
6+00	179.00	168.10	10.9										
7+00	181.00	168.58	12.4										
	181.55	168.68	12.9	7+10.86									
8+00	185.00	169.26	15.7										
9+00	183.50	169.86	13.6										
10+00	178.90	170.46	8.4										
11+00	180.70	171.06	9.6										
	181.21	171.13 out	10.1	11+10.86									
	181.21	171.23 in	10.0										
12+00	180.00	171.59	8.4										
	181.08	171.96 out	9.1	12+92.2									
	181.08	172.06 in	9.0										
13+00	181.00	172.09	8.9										
14+00	181.70	172.49	9.2										
15+00	182.50	172.89	9.6										
	183.15	173.09	10.1	15+51.2	8" STUB W 173.19								
16+00	183.30	173.39	9.9										
17+00	184.10	173.79	10.3										
18+00	184.90	174.19	10.7										
	185.22	174.23	11.0	18+10.2	8" STUB W 174.33								
19+00	185.50	175.05	10.4										
20+00	186.50	175.85	10.6										
	187.30	176.40	10.9	20+69.2	8" STUB W 176.50								
21+00	187.40	176.75	10.6										
22+00	188.10	177.55	10.6										
					21+52 4" sch tap								
					21+59 4" sch tap								
23+00	189.00	178.35	10.6										
	189.55	178.57	11.0	23+28.2 = 0+00 L-2									
24+00	190.00	179.39	10.6										
25+00	190.90	180.39	10.5										
	192.14	181.26	10.9	25+87.2 = 0+00 L-3									
26+00	192.00	181.49	10.5										
27+00	193.00	182.49	10.5										
28+00	193.90	183.49	10.4										
	194.49	183.95	10.5	28+46.2 = 0+00 L-4									
29+00	194.70	184.59	10.1										
	195.39	185.09 out	10.3	29+49.7 = 0+00 L-5									
	195.39	185.19 in	10.2										
30+00													
	195.79	185.39 out	10.4	30+01.36 = 0+00 L-6									
	195.79	185.49 in	10.3										
31+00	196.30	185.89	10.4										
	197.03	186.12 out	10.9	31+56.86									
	197.03	186.22 in	10.8										
CONT. ON N-291													

Handwritten notes in the table include permit numbers (e.g., 98-064-1, 98-106207, 99-528-7), house numbers (e.g., 4342 N. Shadow Glen, 4340 N. Shadow Glen, 4400 Shadow Glen, 4410 Shadow Glen, 4414 Shadow Glen, 4342 N. Shadow Glen, 4400 Shadow Glen), and dates (e.g., 3-7-06, 3-29-06, 6-29-98, 1-21-01, 6-2-98, 4-3-06, 5-17-99).