


LATERAL 136, WAR INDUSTRIES SEWER
PROJECT NO. 468-82693 (743120)
BUILT BY MIES CONSTRUCTION CO.
BOOKED 2/13/98 PER PLAN



SCALE: 1" = 200'

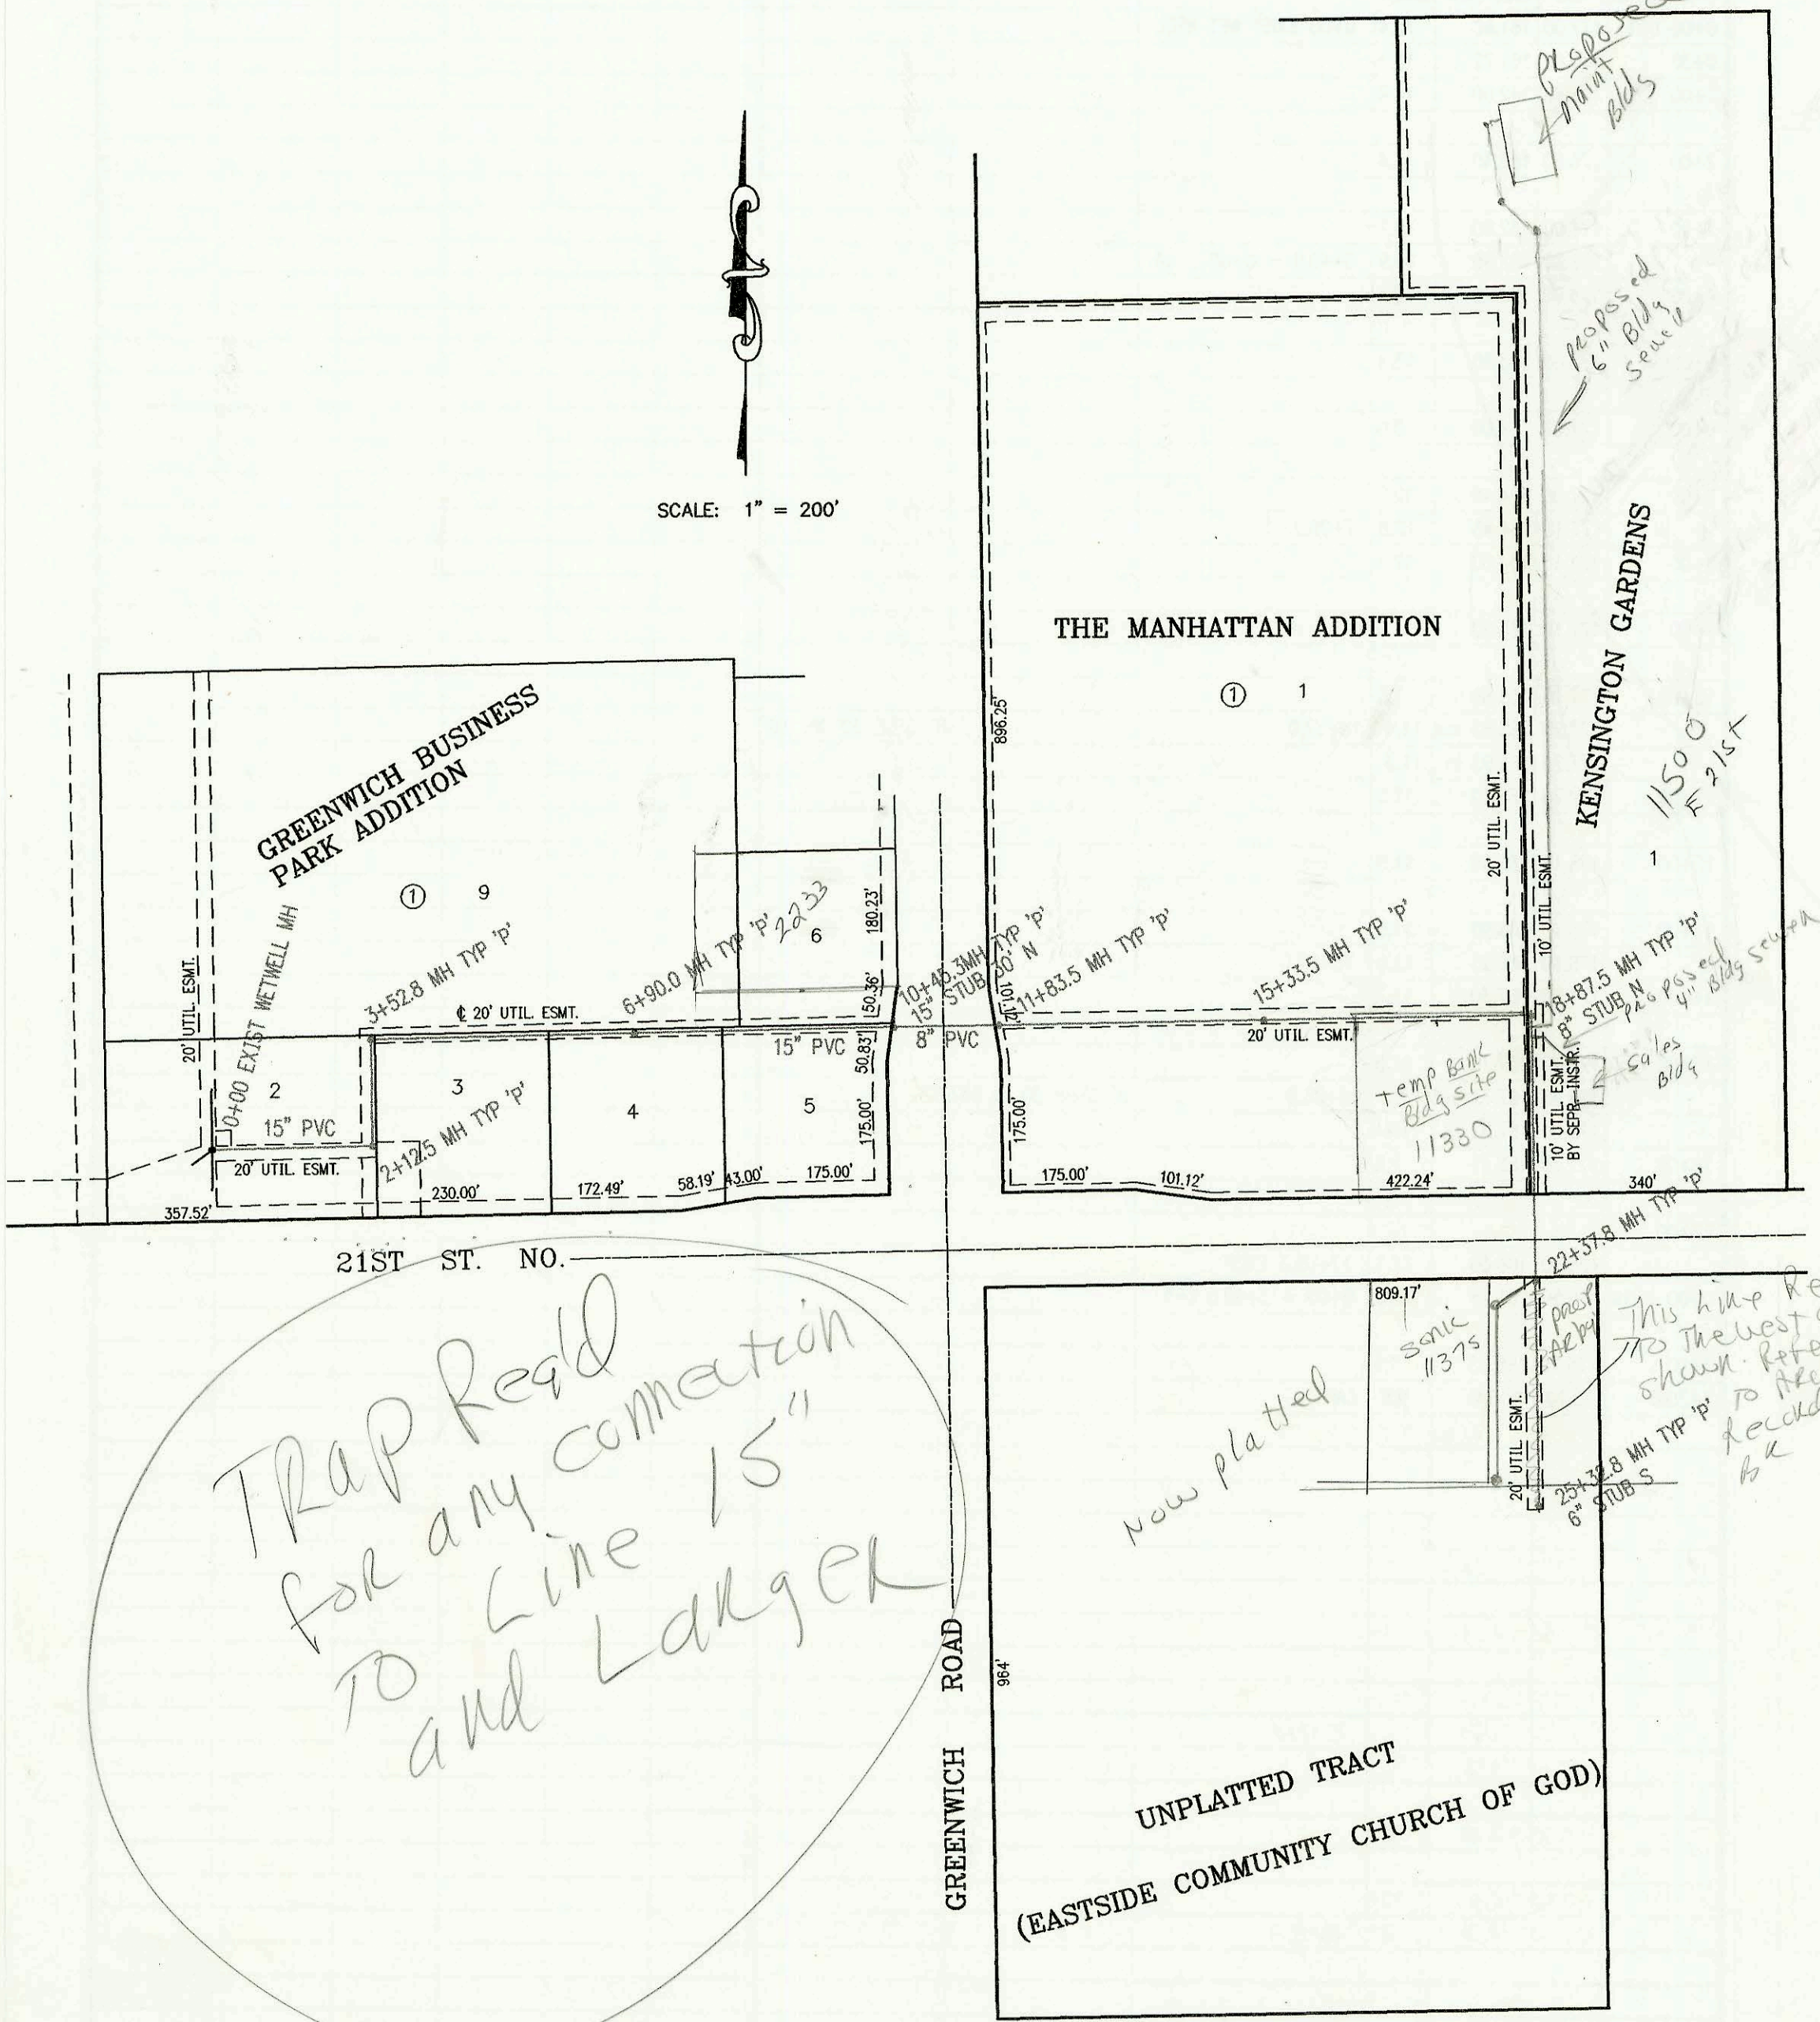

CONSTRUCTION RECORD						SERVICE RECORD						
STATION	ELEVATION		DEPTH	MANHOLE	4-INCH "Y" BRANCHES		No. of Permit		House Number		DATE OF PERMITS	
	GROUND	GRADE			North West	South East	North West	South East	North West	South East	North West	South East
LATERAL 136, WAR INDUSTRIES			SEWER									
0+00 L-1	176.80	161.60	15.2	0+00 EXIST WET WELL								
0+30	176.80	158.46	18.3									
1+00	176.80	158.57	18.2									
2+00	176.80	158.72	18.1									
	176.80	158.74 out	18.1	2+12.5								
	176.80	158.84 in	18.0									
3+00	176.90	158.97	17.9									
	177.00	159.05 out	18.0	3+52.8								
	177.00	159.15 in	17.9									
4+00	177.00	159.22	17.8									
5+00	177.20	159.37	17.8									
6+00	177.40	159.52	17.9									
7+00												
	177.50	159.67	17.8	7+02.8								
8+00	176.80	159.82	17.0									
9+00	176.10	159.97	16.1									
10+00	175.30	160.12	15.2									
	174.90	160.18 out	14.7	10+45.3	15" STUB 30' N	160.28						
	174.90	160.76 in	14.1									
11+00	176.80	160.98	15.8									
	176.30	161.31 out	15.0	11+83.5								
	176.30	161.41 in	14.9									
12+00	175.60	161.46	14.1									
13+00	175.60	161.76	13.8									
14+00	176.00	162.06	13.9									
15+00	176.70	162.36	14.3									
	177.00	162.46	14.5	15+33.5								
16+00	177.80	162.66	15.1									
17+00	178.80	162.96	15.8									
18+00	179.60	163.26	16.3									
	179.80	163.52 out	16.3	18+87.5	8" STUB N	163.62	91-5590-7		11550 (Maintenance) 5-21st Facility	3-31-99		
	179.80	163.62 in	16.2									
19+00	179.90	163.66	16.2				915593-7		11560 (Temp Sales) 5-21st Bldg	3-31-99		
20+00	179.20	163.96	15.2									
21+00	178.60	164.26	14.3									
22+00	178.50	164.56	13.9									
	177.20	164.67	12.5	22+37.8								
23+00	177.00	164.86	12.1									
24+00	176.50	165.16	11.3									
25+00	175.50	165.46	10.0									
	175.30	165.56	9.7	25+32.8	6" STUB S	165.75						