


LATERAL 139, WAR INDUSTRIES SEWER
 PROJECT NO. 468-82698 (743138)
 BUILT BY MEIS CONSTRUCTION CO.
 BOOKED 2/13/98 PER PLAN

SCALE: 1" = 200'

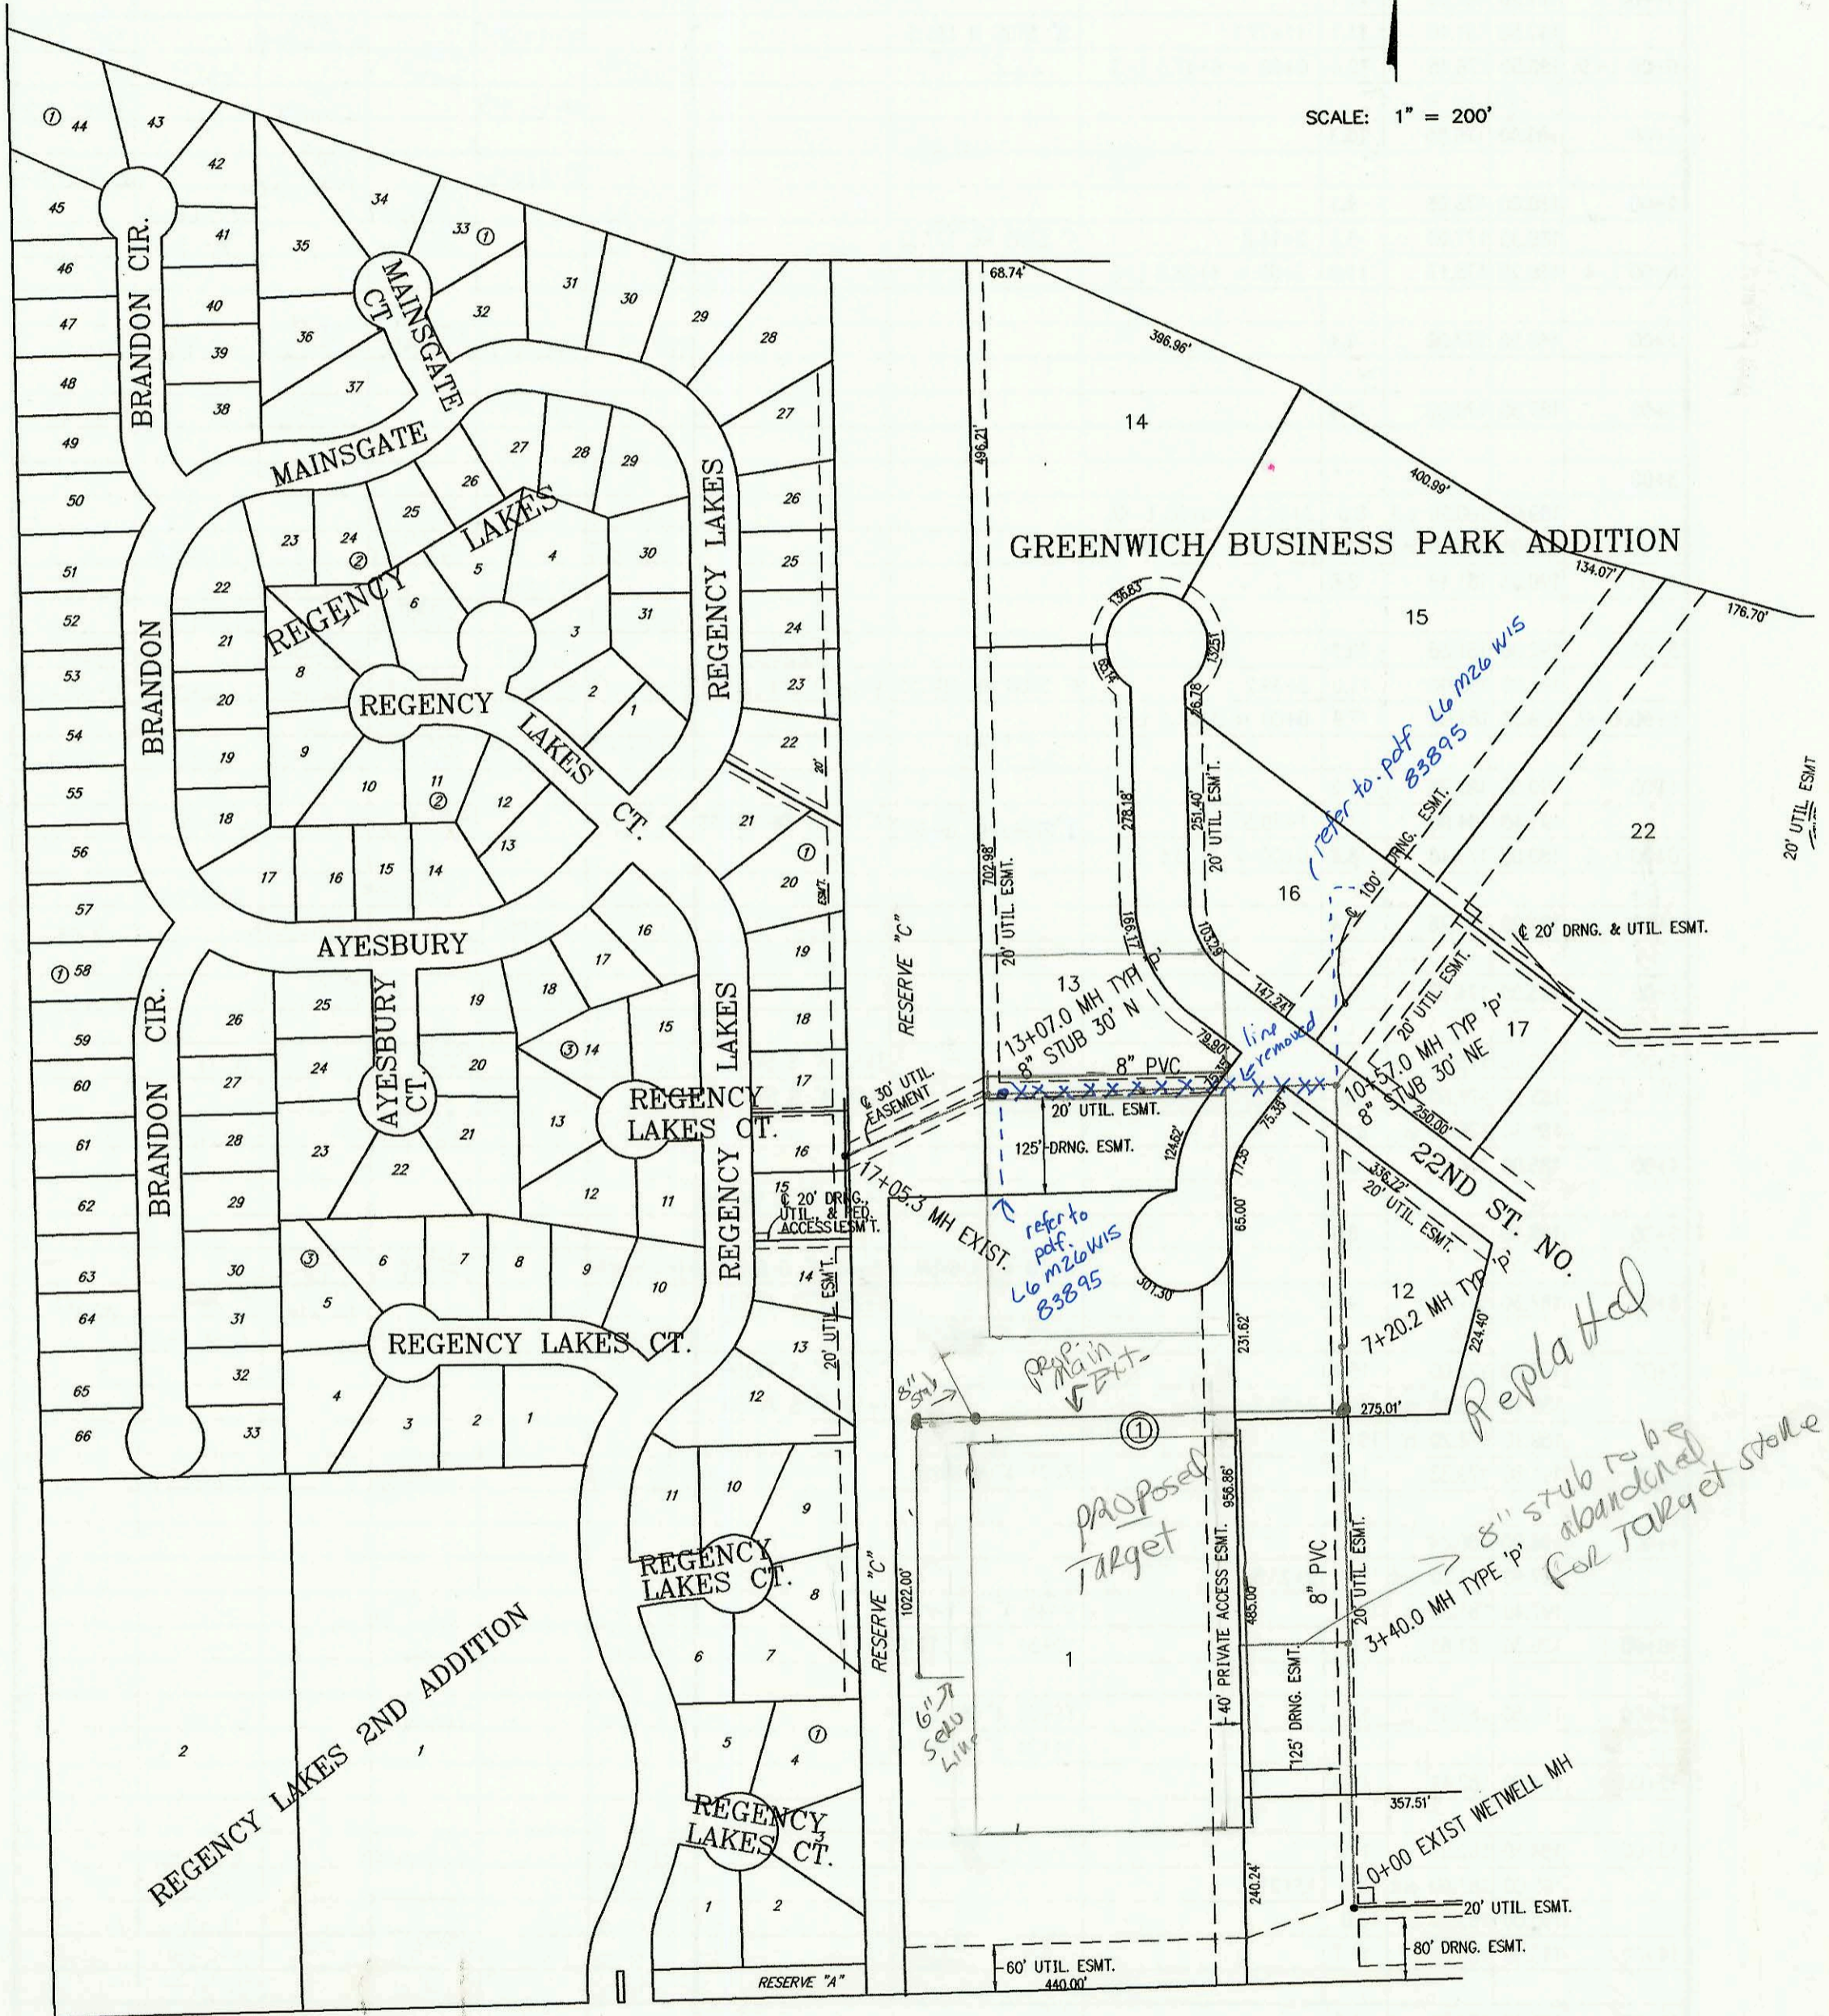

Target Store

IF sewer contractor asks to install 6" service line to within 5' of prop structure as before release of main ext. you can allow under following:

1. Must be same contractor who is doing main ext.
2. Must issue sewer permit from OCI
3. No conn to bldg until priv. prop has been released (4) Repl. 2nd permit

