



REPLACEMENT AND RELOCATION OF
 SANITARY SEWERS IN WICHITA AND LEWIS AND IN
 THE ALLEY BETWEEN LEWIS AND WATERMAN
 PROJECT NO. 468-82623 (621375)
 BUILT BY CORNEJO CONSTRUCTION CO. (SUB. DONDLINGER)
 BOOKED 3/10/98 PER AS BUILT PLAN

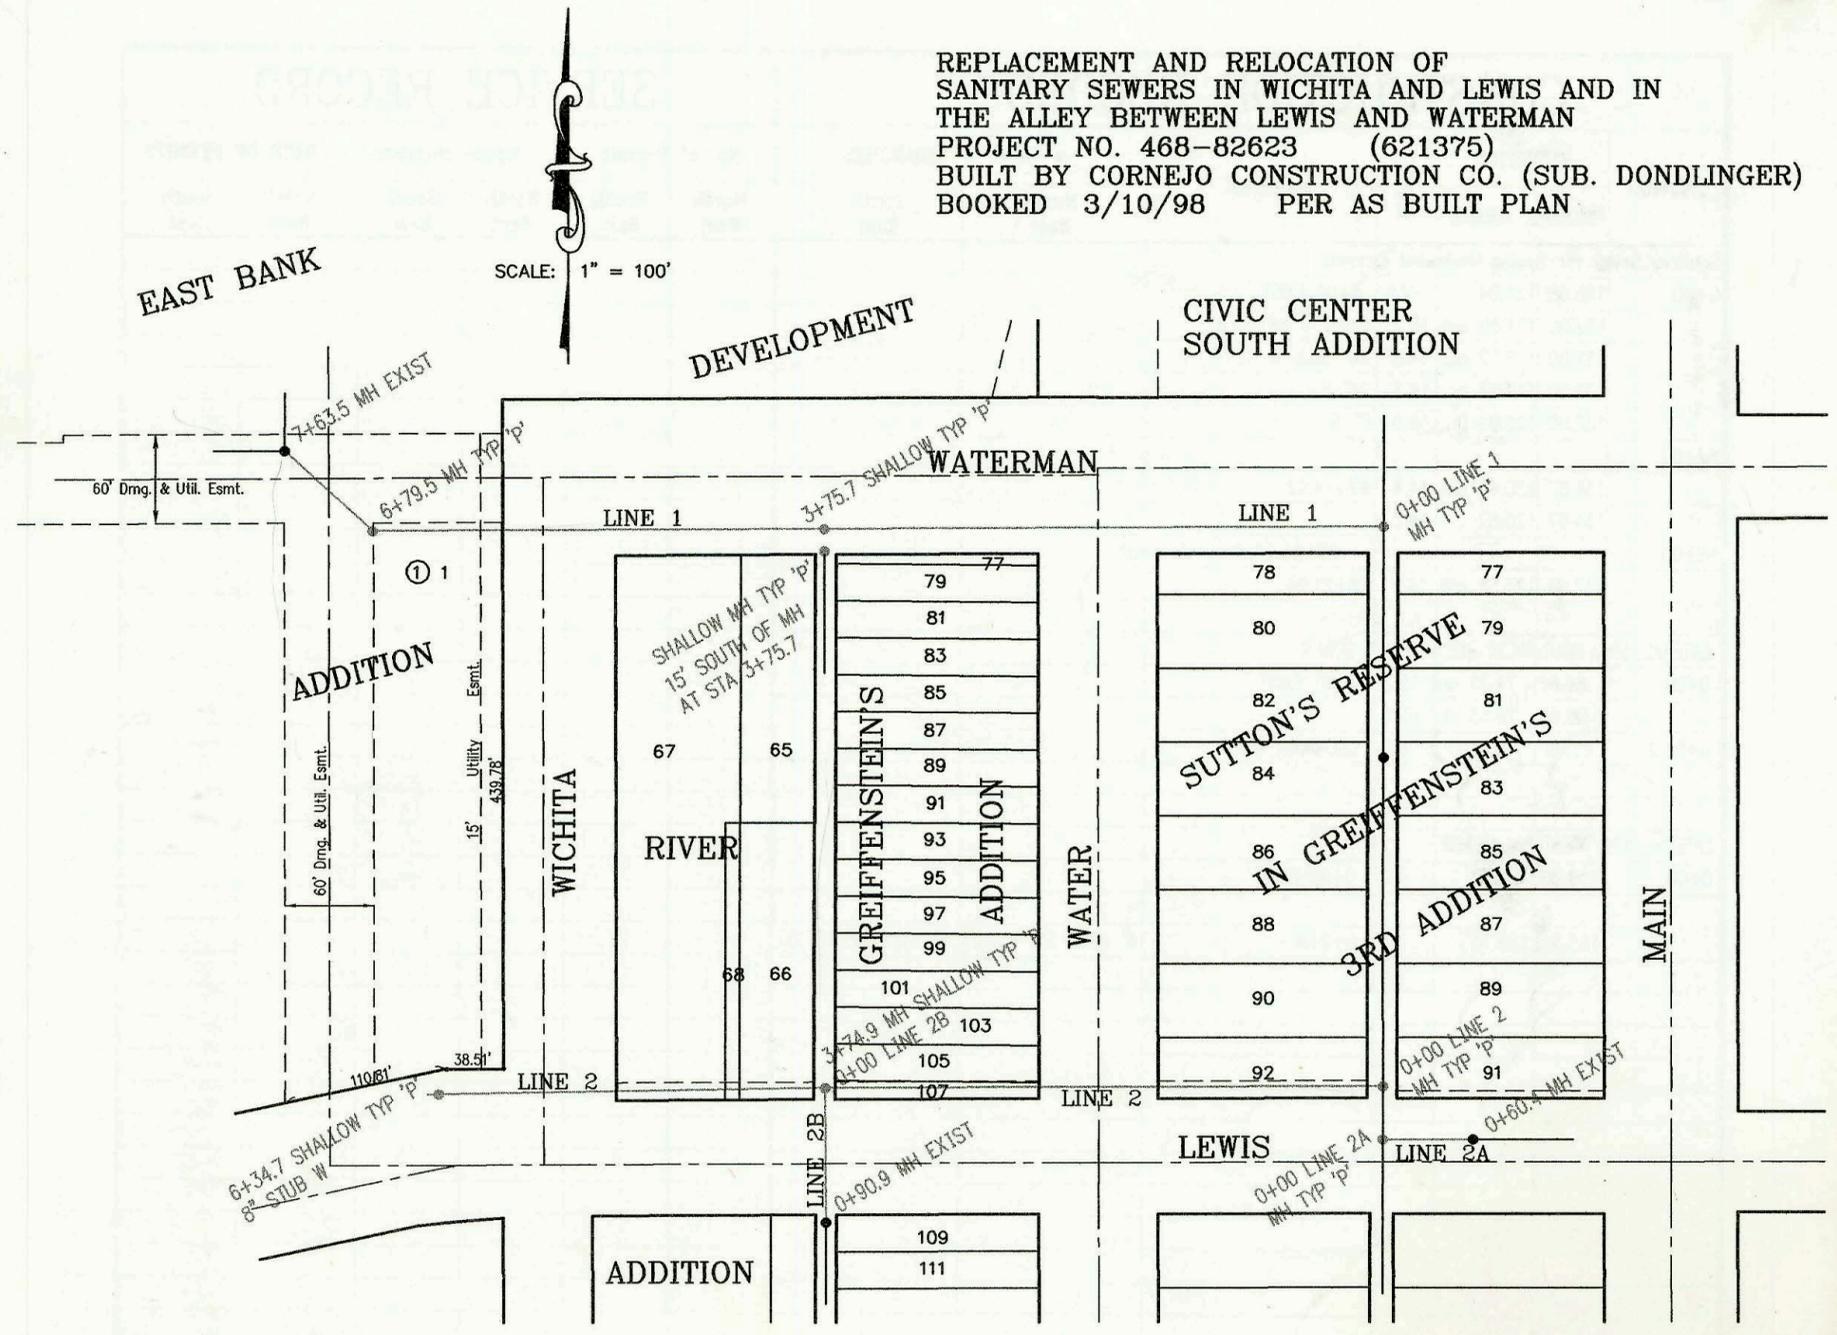

LATERAL 158, SANITARY SEWER NO. 22
 PROJECT NO. 468-82791 (743377)
 BUILT BY W. B. CARTER CONSTRUCTION CO.
 BOOKED 4/8/98 PER AS BUILT PLAN

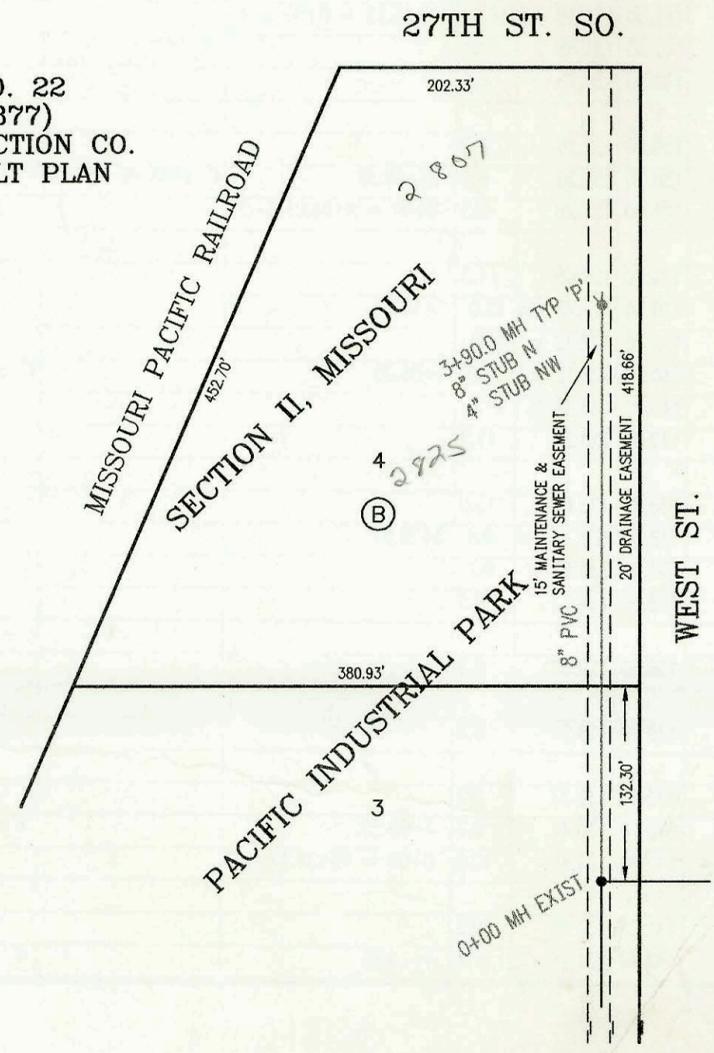

CONSTRUCTION RECORD					SERVICE RECORD							
STATION	ELEVATION		DEPTH	MANHOLE	4-INCH "Y" BRANCHES		No. of Permit		House Number		DATE OF PERMITS	
	GROUND	GRADE			North West	South East	North West	South East	North West	South East	North West	South East
Replacement & Relocation of Sanitary Sewers in Wichita and Lewis Streets and in the Alley between Lewis and Waterman												
0+00 L-1	111.25	102.99 out	8.3	0+00								
	111.25	103.09 lin	8.2									
1+00	110.50	103.29	7.2									
2+00	110.20	103.49	6.7									
3+00	110.70	103.69	7.0									
	110.18	103.85	6.3	3+75.7								
4+00	110.20	103.90	6.3									
5+00	109.30	104.10	5.2									
6+00	108.90	104.30	4.6									
	112.50	104.46	8.0	6+79.5								
7+00	109.00	104.60	4.4									
	114.50	104.72	9.8	7+63.5 EXIST								
0+00 L-2	109.78	102.46 out	7.3	0+00								
	109.78	102.64 in	7.1									
1+00	110.30	102.94	7.4									
2+00	109.50	103.24	6.3									
3+00	109.90	103.54	6.4									
	109.78	103.77	6.0	3+74.9 = 0+00 L-2B								
4+00	109.80	103.84	6.0									
5+00	109.10	104.11	5.0									
6+00	109.50	104.44	5.1									
	109.97	104.54	5.4	6+34.7	8" STUB W							
0+00 L-2A	109.23	102.38 out	6.9	0+00								
	109.23	103.15 in	6.1									
	109.80	103.33	6.5	0+60.4 EXIST								
0+00 L-2B	109.78	103.86	5.9	0+00 = 3+74.9 L-2								
	109.40	104.14	5.3	0+90.9 EXIST								
LATERAL 158, SANITARY SEWER NO. 22												
0+00	103.90	95.94 out	8.0	0+00 EXIST								
	103.90	96.72 in	7.2									
1+00	104.30	97.02	7.3									
2+00	103.20	97.32	5.9									
							38977-9		2825 SWEST		6-10-98	
3+00	104.00	97.62	6.4									
	104.20	97.92	6.3	3+90.0	8" STUB N 97.92 4" STUB NW 98.25				2807 SWEST		?	