
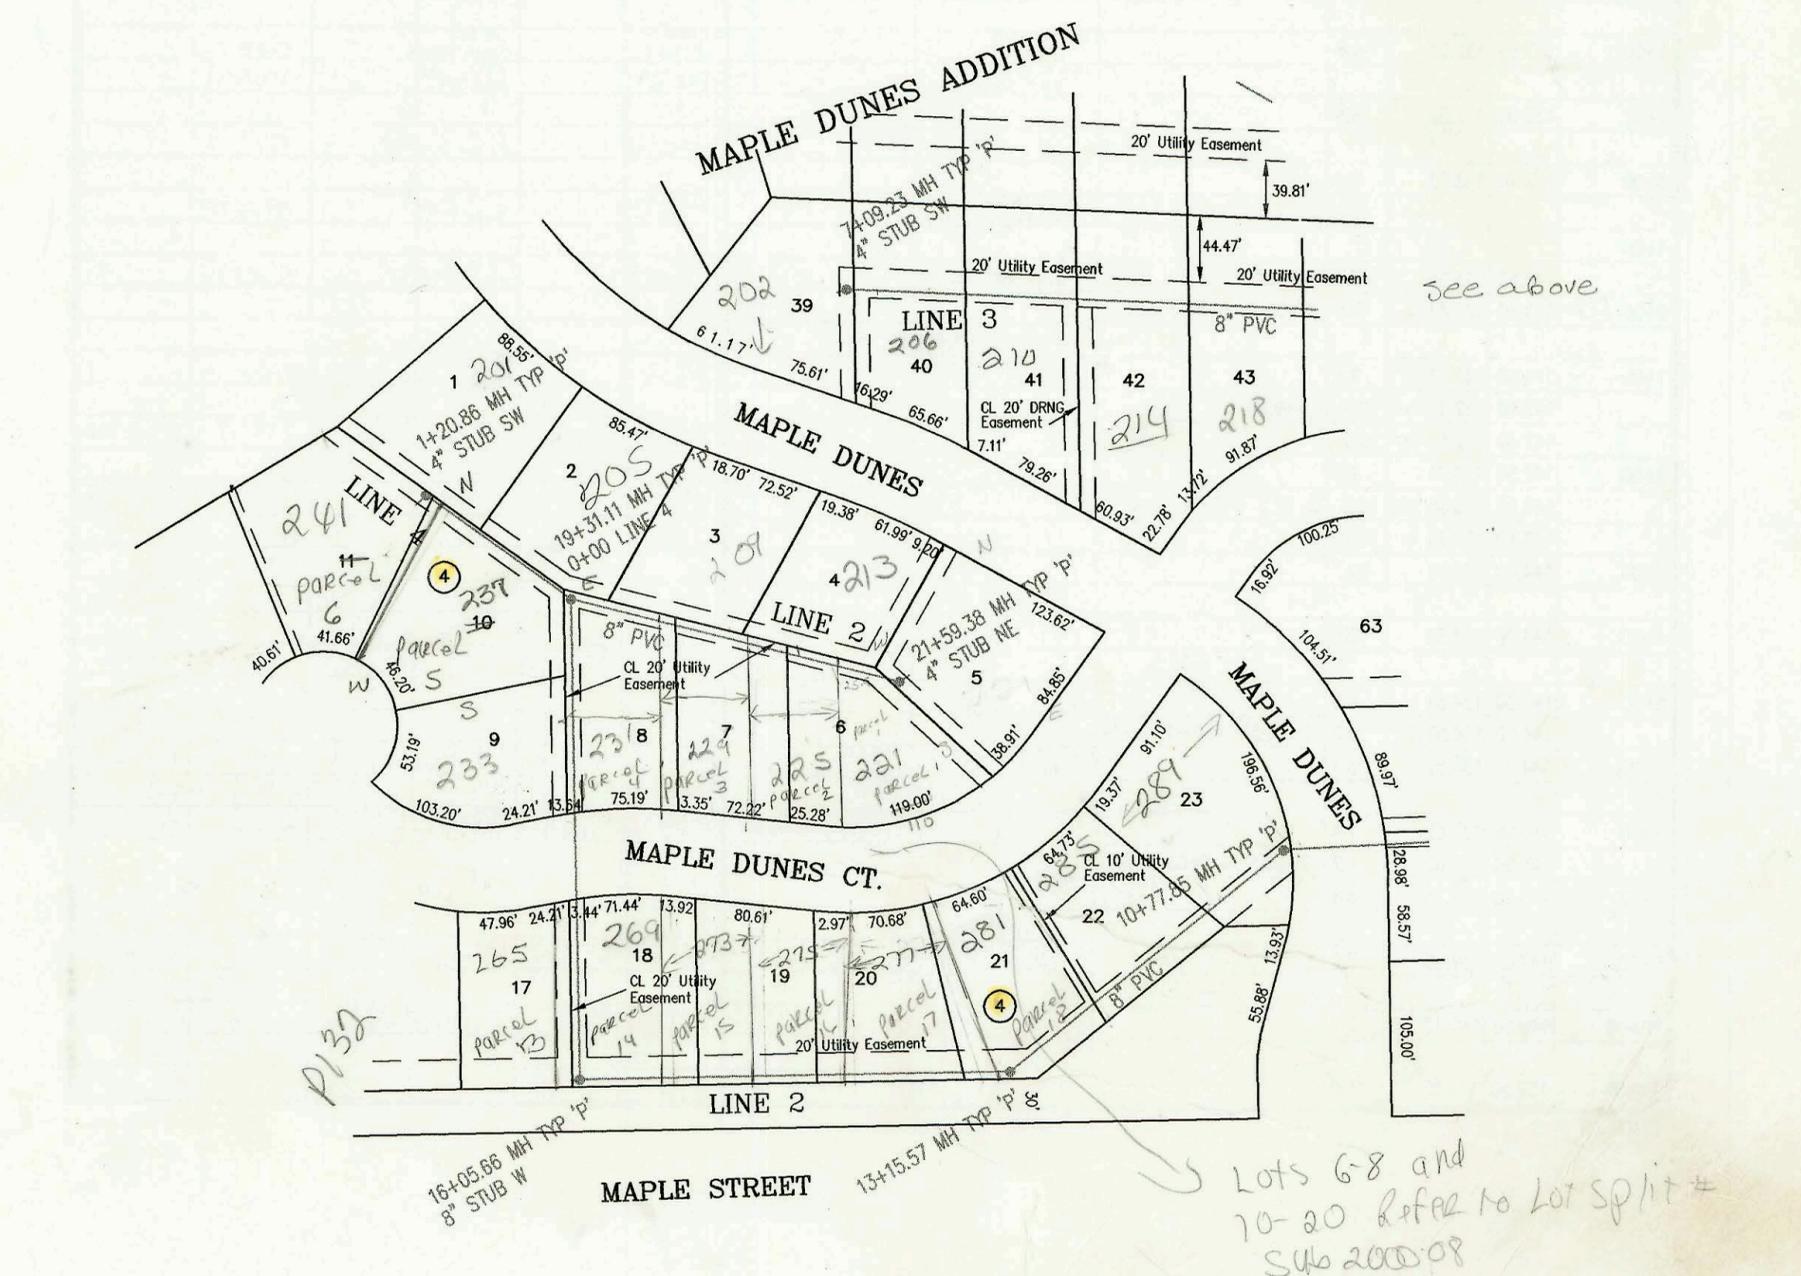


LATERAL 6, COWSKIN INTERCEPTOR SEWER
PROJECT NO. 468-82714 (743203)
BUILT BY NOWAK CONSTRUCTION CO.
BOOKED 4/16/98 PER PLAN

NOT IN
ARCHIVE
AS OF 6-22-98
NOTE SENT TO
SYSTEM PLANNING
6-22-98

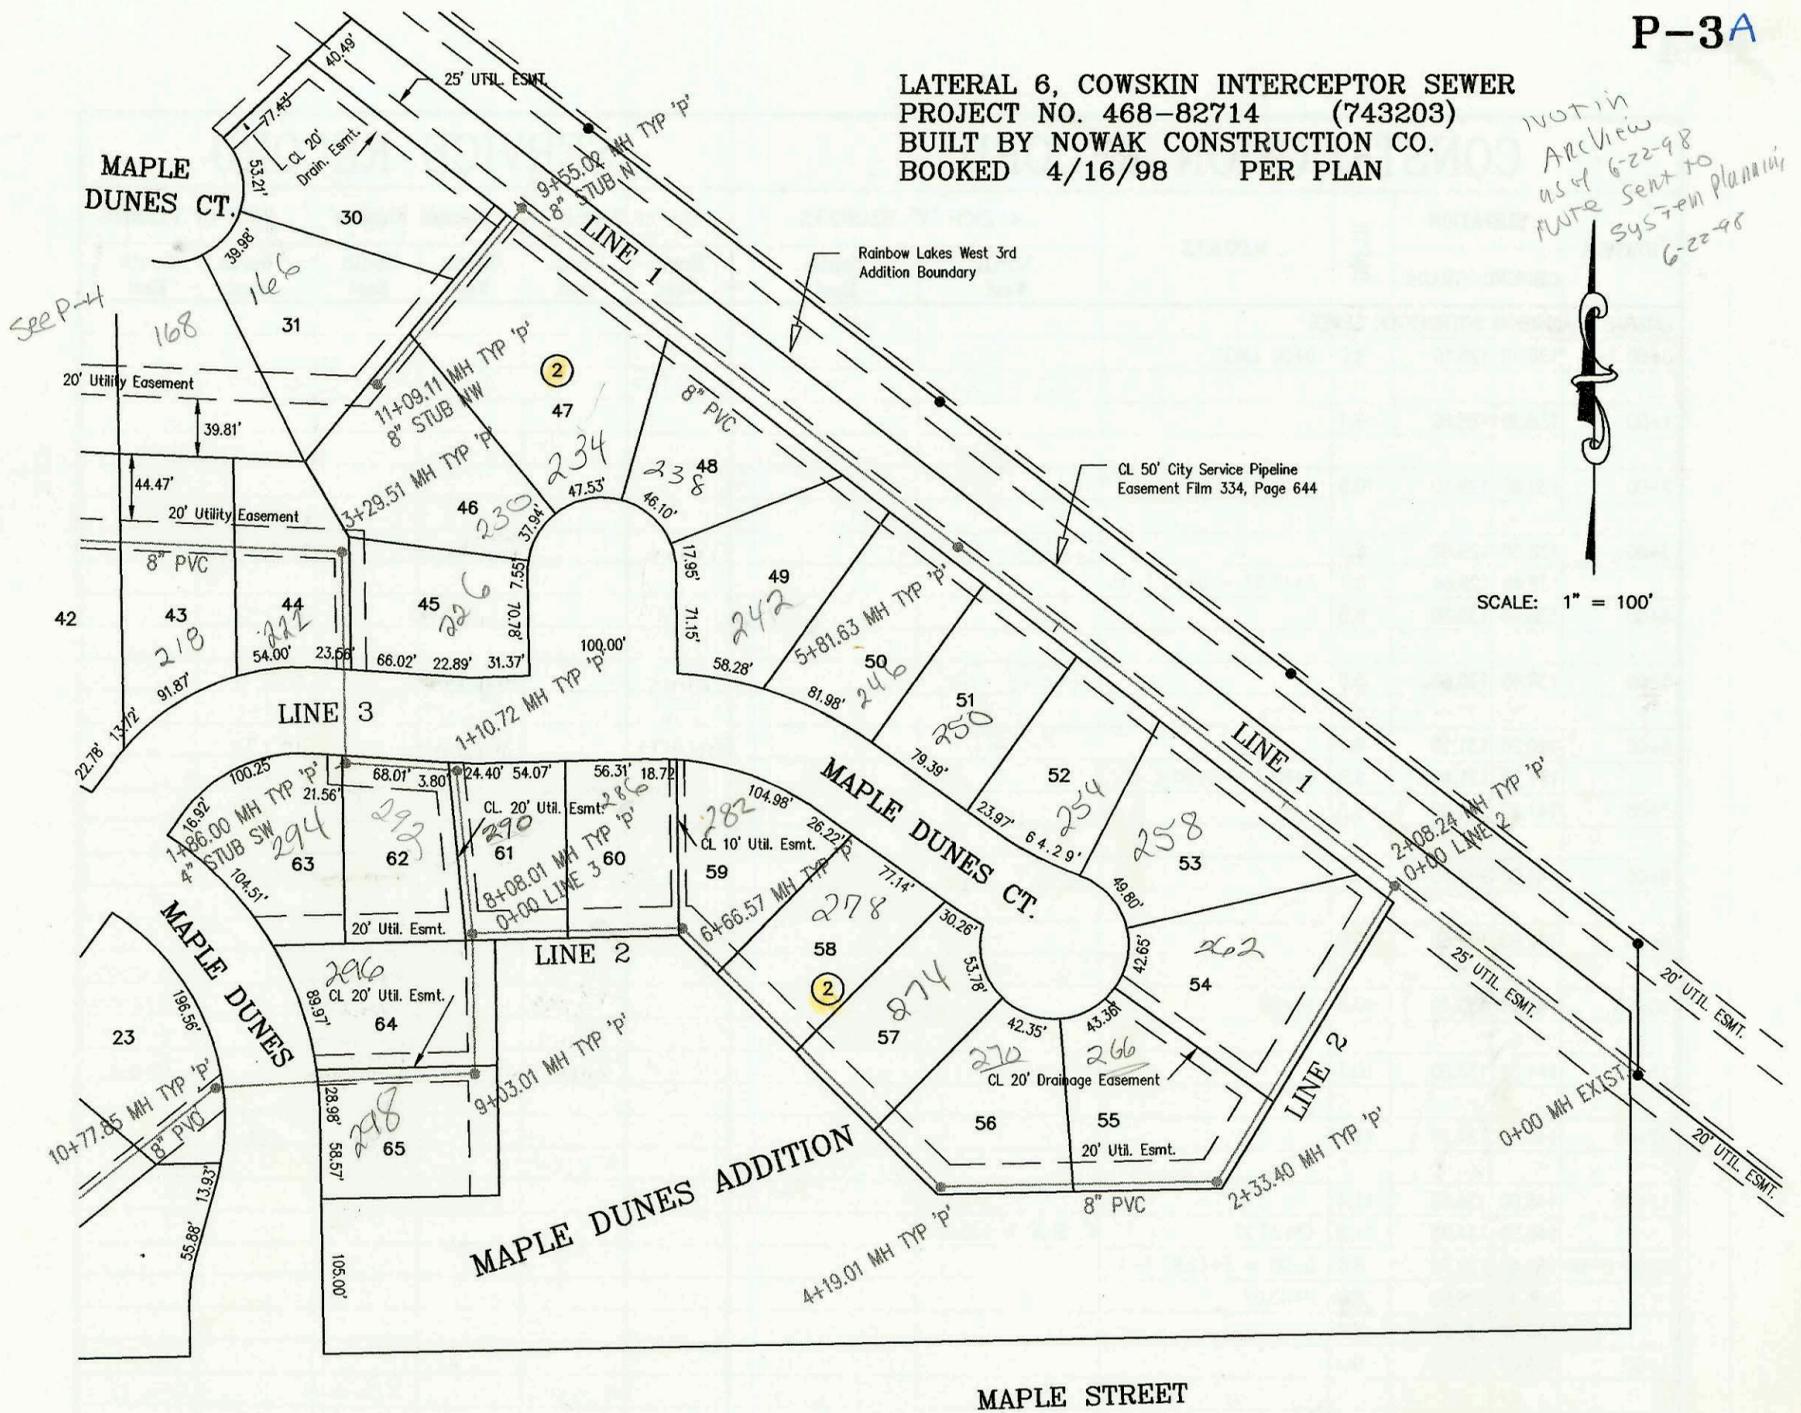

CONSTRUCTION RECORD						SERVICE RECORD						
STATION	ELEVATION		DEPTH	MANHOLE	4-INCH "Y" BRANCHES		No. of Permit		House Number		DATE OF PERMITS	
	GROUND	GRADE			North West	South East	North West	South East	North West	South East	North West	South East
LATERAL 6, COWSKIN INTERCEPTOR SEWER												
0+00 L-1	132.90	123.53	9.4	0+00 EXIST								
1+00	132.60	123.93	8.7									
2+00	132.60	124.33	8.3									
	133.10	124.36	8.7	2+08.24 = 0+00 L-2	4" SCH 40 3+01.24			99-00589	259 Maple Dunes		9-3-99	
3+00	133.10	124.82	8.3					98-11667	259 Maple Dunes		6-3-98	
4+00	133.50	125.32	8.2					98-95727	250 S Maple Dunes		6-5-98	
5+00	133.80	125.82	8.0					98-11637	246 S Maple Dunes		6-19-98	
	134.60	126.23	8.4	5+81.63								
6+00	134.30	126.32	8.0					98-22957	242 Maple Dunes		2-4-99	
7+00	134.70	126.82	7.9									
					4" SCH 40 PVC 7+77.13			2000- 01923	238 S Maple Dunes		10-3-05	
8+00	135.20	127.32	7.9									
9+00	135.50	127.82	7.7									
	136.20	128.10 out	8.1	9+55.02								
	136.20	128.20 in	8.0					2001 02494	234 Maple Dunes		10-8-01	
10+00	136.20	129.14	7.1									
								1999-2	166 Maple Dunes	230 S Maple Dunes	7-15-99	2-4-99
11+00	137.00	131.24	5.8									
	137.40	131.43	6.0	11+09.1								
0+00 L-2	133.10	124.46	8.6	0+00 = 2+08.24 L-1								
1+00	135.80	124.76	11.0									
2+00	135.50	125.06	10.4									
	136.20	125.16 out	11.0	2+33.4				2003 02154	216 Maple Dunes		8-18-03	
	136.20	125.26 in	10.9									
3+00	135.90	125.46	10.4					2002 02546	270 Maple Dunes		9-17-02	
4+00	136.00	125.76	10.2					2004 02261	271 Maple Dunes		1-30-04	
	136.40	125.82 out	10.6	4+19.01								
	136.40	125.92 in	10.5									
5+00	136.00	126.16	9.8					2001 01996	272 Maple Dunes		8-14-01	
6+00	136.00	126.46	9.5					2003 01995	282 Maple Dunes		8-14-01	
	136.40	126.66 out	9.7	6+66.57								
	136.40	126.76 in	9.6									
7+00	136.00	126.86	9.1		4" SCH 40 7+23.5			1999- 01303	236 Maple Dunes		11-23-99	
8+00	136.60	127.16	9.4									
	136.60	127.18 out	9.4	8+08.01 = 0+00 L-3								
	136.60	127.28 in	9.3		4" SCH 40 DL 8+17.01 TAP			2001- 01028	296 Maple Dunes		4-27-01	
9+00	136.00	127.56	8.4									
	136.40	127.57 out	8.8	9+03.01		4" SCH 40 9+10.01		2000- 00461	298 Maple Dunes		2-18-00	
	136.40	127.67 in	8.7									
10+00	138.20	127.96	10.2									
	138.80	128.19 out	10.6	10+77.85								
	138.80	128.29 in	10.5					98-9573-7	289 S Maple Dunes		6-5-98	
11+00	138.40	128.36	10.0									
12+00	138.30	128.66	9.6									
13+00	138.30	128.96	9.3									
	138.70	129.01 out	9.7	13+15.57								
	138.70	129.11 in	9.6		4" SCH 40 DL 14+57.57 TAP			2000- 02463	277 N Maple Dunes		11-13-00	
14+00	138.90	129.36	9.5		4" SCH 40 DL 14+60.57 TAP			2000- 02228	278 Maple Dunes		10/11/00	
					4" SCH 40 DL TAP 14+90.66			2000- 01651	275 Maple Dunes		7-19-00	
15+00	139.60	129.66	9.9									
					4" SCH 40 15+56.66			2000- 00122	269 S Maple Dunes		1-15-2000	
16+00	140.40	129.96	10.4									
	140.80	129.98 out	10.8	16+05.66								
	140.80	130.08 in	10.7									
17+00	142.10	130.45	11.7									

CONT. ON P-2