


LATERAL 7, COWSKIN INTERCEPTOR SEWER
PROJECT NO. 468-82715 (743302)
BUILT BY MIES CONSTRUCTION CO.
BOOKED 4/22/98 PER AS BUILT PLAN

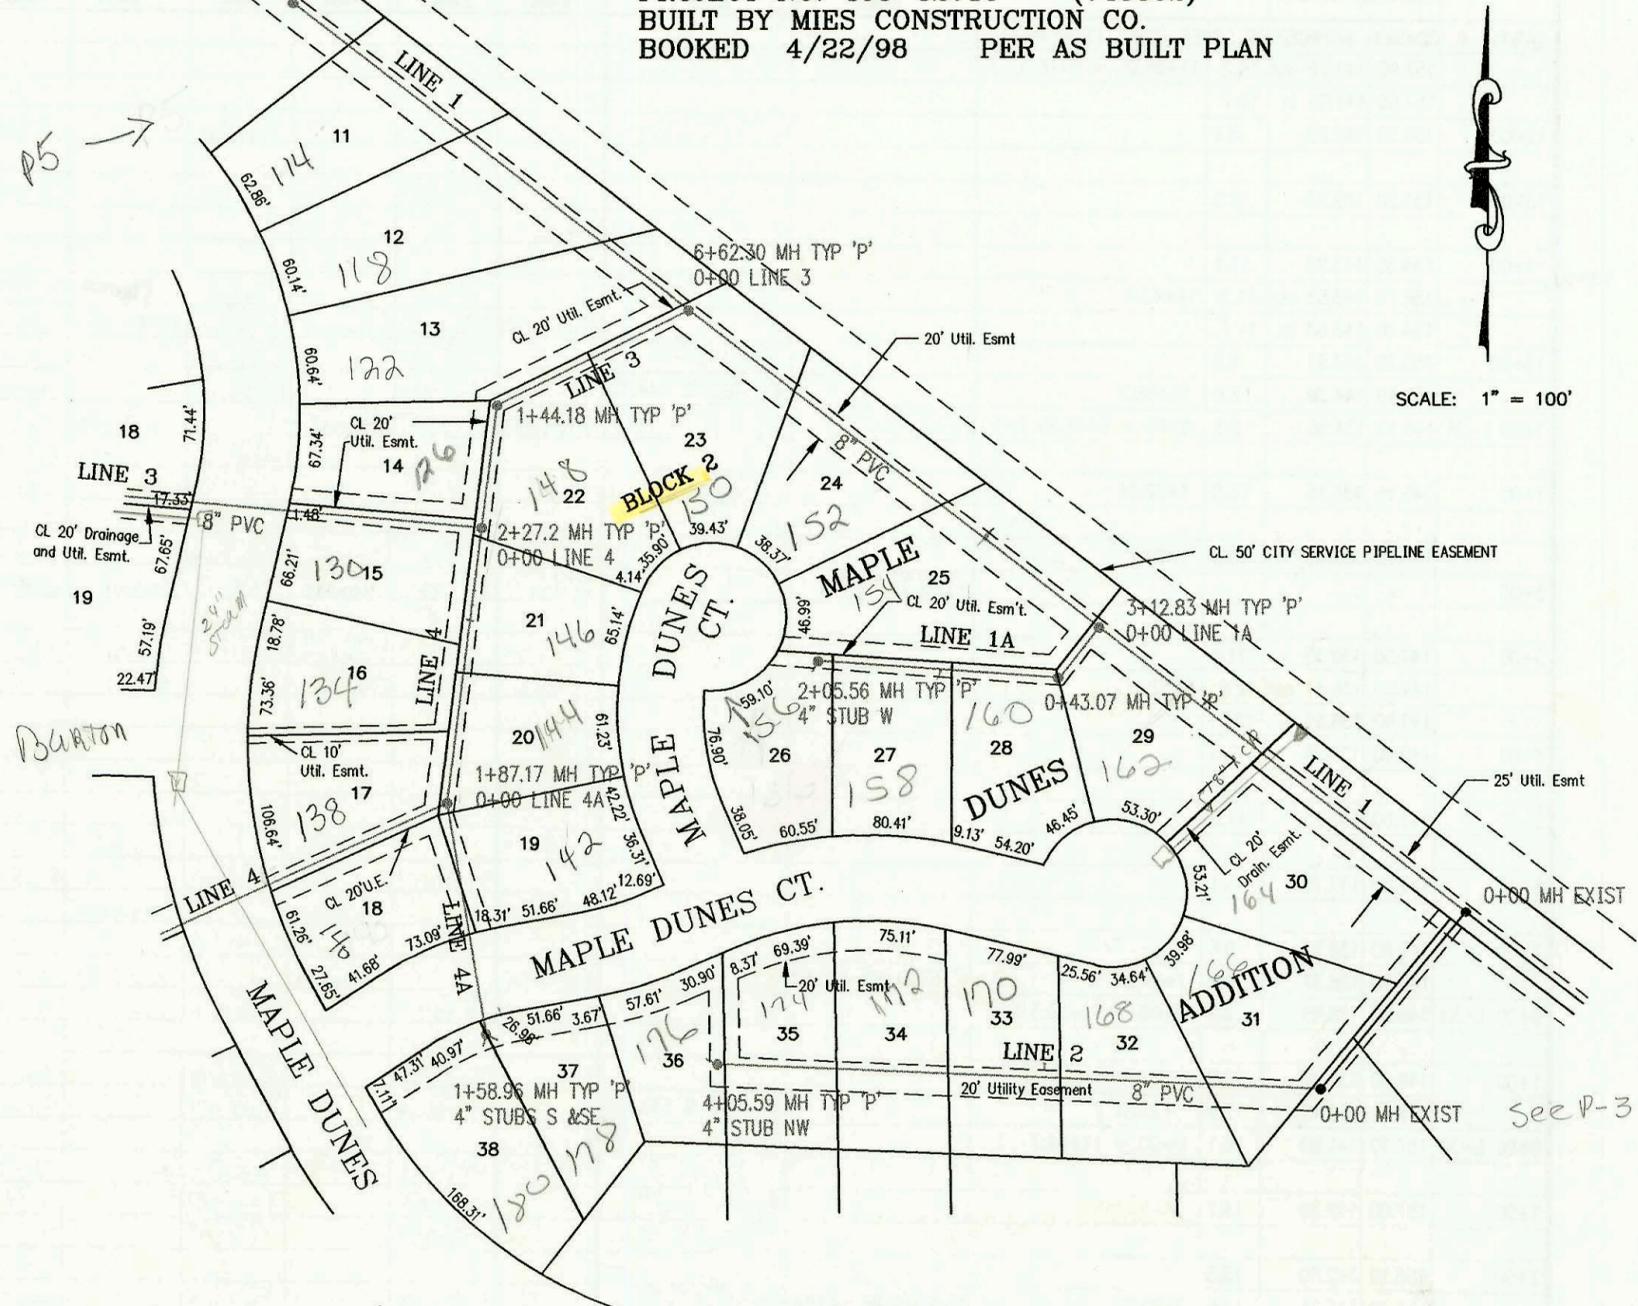

CONSTRUCTION RECORD					SERVICE RECORD							
STATION	ELEVATION		DEPTH	MANHOLE	4-INCH "Y" BRANCHES		No. of Permit		House Number		DATE OF PERMITS	
	GROUND	GRADE			North West	South East	North West	South East	North West	South East	North West	South East
LATERAL 7,	COWSKIN	INTERCEPTOR	SEWER									
0+00 L-1	136.10	128.10	8.0	0+00 EXIST								
					4" SCH 40 DL 1+01 TAP		2000- 01875		160 S Maple Dunes Ct		8-22-00	
1+00	138.30	128.60	9.7									
2+00	139.60	129.10	10.5									
3+00	138.30	129.60	8.7		4" SCH 40 DL 2+24.83 TAP		2001- 00425		162 S Maple Dunes		2-27-01	
	138.40	129.66	8.7	3+12.83 = 0+00 L-1A								
4+00	138.60	130.10	8.5									
5+00	139.40	130.60	8.8		4" SCH 40 DL 4+28.83 TAP		2001- 01165 2001- 01701		154 Maple Dunes 152 Maple Dunes		5-11-01 7-11-01	
6+00	140.20	131.10	9.1		4" SCH 40 0+51		99-00677		150 S Maple Dunes		9-15-99	
	141.20	131.41	9.8	6+62.3 = 0+00 L-3								
7+00	141.10	131.60	9.5									
8+00	141.80	132.10	9.7		4" SCH 40 DL 8+32 TAP		2000- 02361		118 Maple Dunes		10-30-00	
9+00	142.60	132.60	10.0									
10+00	143.90	133.10	10.8	10+00	4" SCH 40 10+67		2001- 02745 2000- 00568		114 S Maple Dunes 110 S Maple Dunes		10-31-01 3-2-00	
					4" SCH 40 DL 11+84.0 TAP		2000- 01949 2001- 01165		102 S Maple Dunes 106 S Maple Dunes		8-31-00 5-11-01	
11+00	144.30	133.60	10.7									
12+00	145.20	134.10	11.1		4" SCH 40 DL 12+29.27 TAP		2001- 01266		124 S Maple Dunes		5-22-01	
13+00	146.00	134.60	11.4									
	146.50	134.75	11.8	13+30.27	4" STUB W 135.08							
0+00 L-1A	138.40	129.76	8.6	0+00 = 3+12.83 L-1								
	138.90	129.98	8.9	0+43.07								
	138.90	130.08	8.8									
1+00	139.70	130.36	9.3									
2+00					4" SCH 40 1+26.07		99-00590		158 S Maple Dunes		9-3-99	
	142.80	130.89	11.9	2+05.58	4" STUB W 131.22		2000- 00570		156 Maple Dunes		3-2-00	
0+00 L-2	137.40	131.53	5.9	0+00 EXIST								
1+00	137.80	132.03	5.8		4" SCH 40 1+12		2000- 01261		168 S Maple Dunes		5-23-00	
					4" SCH 40 1+37.59		99-00904		170 Maple Dunes		10-15-99	
2+00	139.00	132.53	6.5									
3+00	139.40	133.03	6.4				99-102267		172 S Maple Dunes		5-13-99	
4+00					4" SCH 40 DL 3+74.59 TAP		2000- 01876		174 S Maple Dunes		8-22-00	
	140.60	133.56	7.0	4+05.59	4" STUB NW 133.89		99-123427		176 S Maple Dunes		5-28-99	
0+00 L-3	141.20	131.61	9.6	0+00 = 6+62.3 L-1								
1+00	141.60	132.11	9.5		4" SCH 40 DL 1+27.18 TAP		2001- 01064		122 S Maple Dunes		5/1/01	
	142.40	132.33 out	10.1	1+44.18								
	142.40	132.43 in	10.0				2001- 02493	98-224127	126 S Maple Dunes	148 S Maple Dunes	10-8-01	11-16-98
2+00	142.50	132.71	9.8									
	143.10	132.85 out	10.3	2+27.2 = 0+00 L-4								
	143.10	132.95 in	10.2									
3+00	144.00	133.31	10.7									
4+00	144.30	133.81	10.5									
					4" SCH 40 DL 5+02.59 TAP		2001- 00563		13402 Burton		3-15-01	
5+00	143.30	134.31	9.0									
	144.10	134.55	9.6	5+46.59 = 0+00 L-3A								
6+00	144.00	135.62	8.4		4" SCH 40 6+59.59	4" SCH 40 DL 5+68.59 TAP	2000- 01444	2001- 00561	118 S Angela Ave	13406 Burton	6-16-00	3-15-01
7+00	145.00	137.62	7.4				2001- 01313	2001- 01167	125 Angela	13410 Burton	5-8-02	5-11-01
	146.00	138.83	7.2	7+60.5 = 0+00 L-3B								
8+00	145.90	139.15	6.8									
9+00	147.00	139.96	7.0		4" SCH 40 DL 8+88.5 TAP	4" SCH 40 DL 8+50.5 TAP	2001- 01168	2001- 00447	121 Angela	13506 Burton	5-11-01	2-28-01
10+00	148.50	140.77	7.7		4" SCH 40 DL 9+50.7 TAP	4" SCH 40 9+40.50	2001- 00066	2000- 00007	117 S Angela	13510 Burton	1-10-01	1-4-2000
11+00	157.50	141.58	15.9									