


SANITARY SEWER TO SERVE LOTS 5 & 6, PARK WEST PLAZA  
 PROJECT NO. 757PPS  
 BUILT BY MEIS CONSTRUCTION CO.  
 BOOKED 4/22/98 PER AS BUILT PLAN

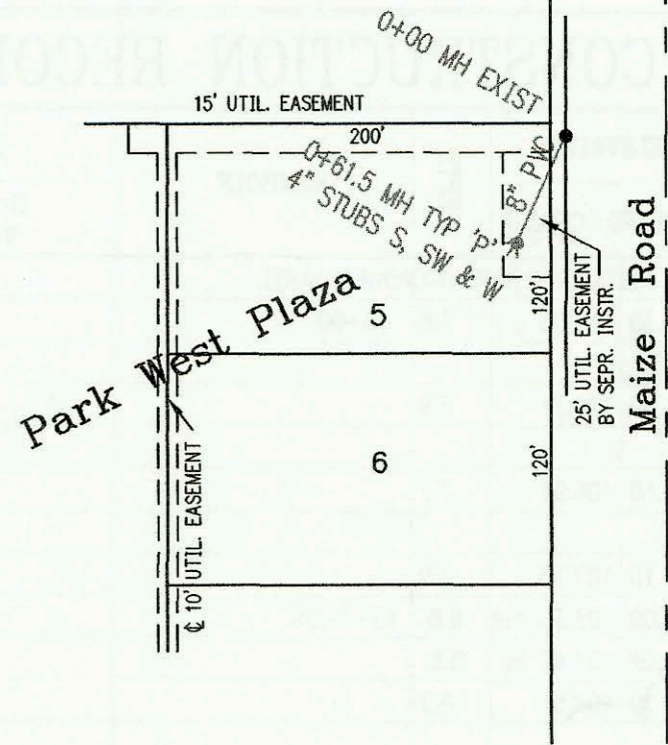


SCALE: 1" = 100'

SCALE: 1" = 100'


K-96 R/W

SANITARY SEWER TO SERVE FIRE STATION NO. 18  
 PROJECT NO. 734PPS  
 BUILT BY W. B. CARTER CONSTRUCTION CO.  
 BOOKED 4/24/98 PER AS BUILT PLAN

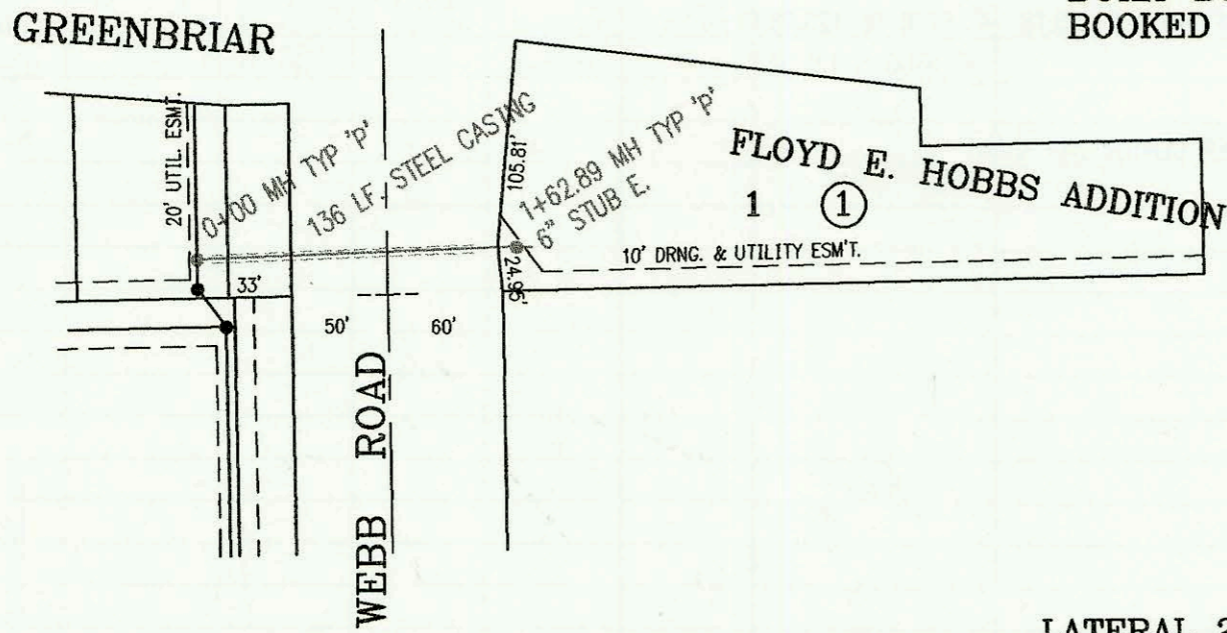

LATERAL 267, MAIN 5, SANITARY SEWER NO. 22  
 PROJECT NO. 468-82665 (743237)  
 BUILT BY W. B. CARTER CONSTRUCTION CO.  
 BOOKED 5/6/98 PER PLAN

*Handwritten notes:*  
 5302 w/ Litch - 4/23/01  
 Bryan Legally, owner signed  
 agreement to not protest main  
 thru of city sewer if street is put  
 thru at same future time. At such  
 time the city would extend an  
 8" line to property and extend on  
 to connect the Gladly sewer.  
 4/23/01  
 BSK

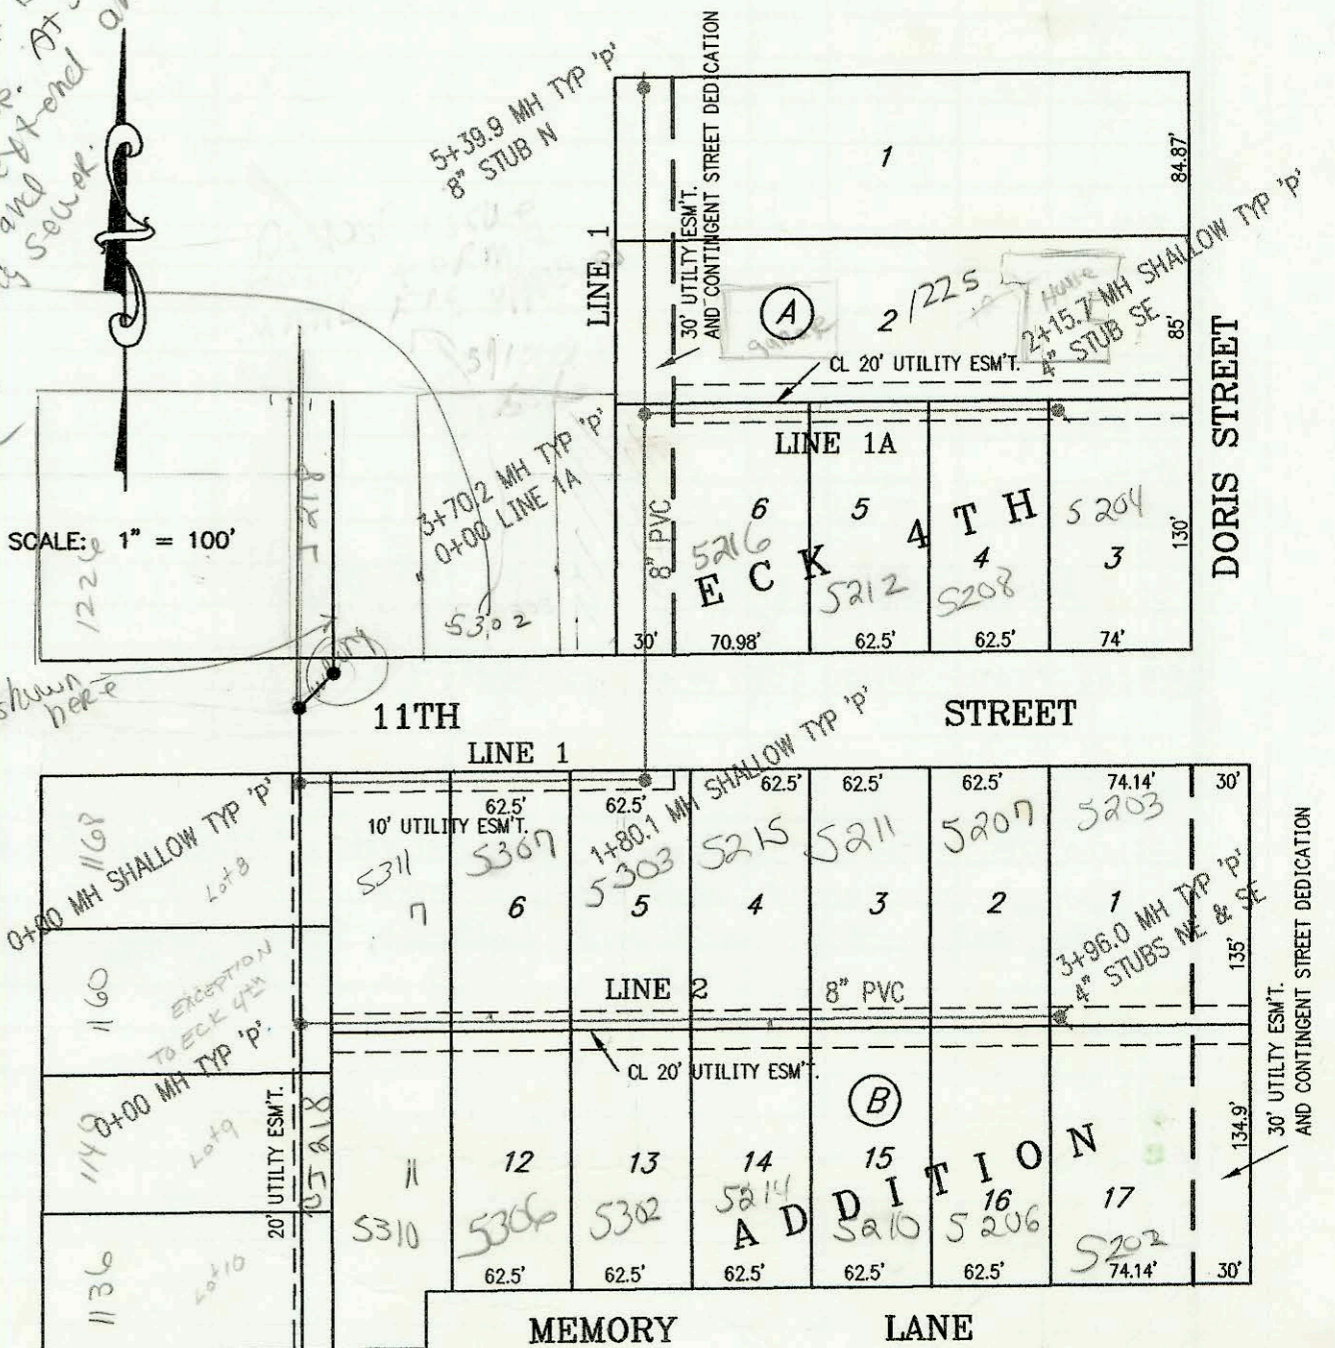

SCALE: 1" = 100'

*Handwritten notes:*  
 This line is not correct as shown here  
 See (J 218)

CONSTRUCTION RECORD						SERVICE RECORD						
STATION	ELEVATION		DEPTH	MANHOLE	4-INCH "Y" BRANCHES		No. of Permit		House Number		DATE OF PERMITS	
	GROUND	GRADE			North West	South East	North West	South East	North West	South East	North West	South East
SANITARY SEWER TO SERVE LOTS 5 & 6, PARK PLAZA WEST ADDITION (757PPS)												
0+00	133.80	125.90 out	7.9	0+00 EXIST								
	133.80	127.75 in	6.1									
	137.18	129.90	7.3	0+61.5	4" STUB W 129.74	4" STUB S 129.70						
					4" STUB SW 129.70							
SANITARY SEWER TO SERVE FIRE STATION NO. 18 (734PPS)												
0+00	221.36	206.73 out	14.6	0+00	4" STUB W 209.11							
	221.36	206.90	14.5									
1+00	221.70		221.7									
	223.65	211.44	12.2	1+44.0		6" STUB E 211.71						
LATERAL 267, MAIN 5, SANITARY SEWER NO. 22												
0+00 L-1	128.00	121.15	6.9	0+00								
1+00	127.80	121.46	6.3									
	128.55	121.70 out	6.9	1+80.1								
	128.55	121.80 in	6.8									
2+00	128.30	121.66	6.6									
3+00	129.20	122.16	7.0		4" SCH 40 3+41.2 Saddle		2001- 01048		520a. W 52e 11th Below		4-30-01	
	130.50	122.37 out	8.1	3+70.2 = 0+00 L-1A								
	130.50	122.47 in	8.0									
4+00	130.20	122.56	7.6									
5+00	130.70	122.86	7.8									
	131.30	122.98	8.3	5+39.9	8" STUB N 123.08							
0+00 L-1A	130.50	122.47	8.0	0+00 = 3+70.2 L-1								
1+00	128.90	122.77	6.1				98-18327		1225 (Det'd Garage) DORIS		9-24-98	
					4" SCH 40 0+42		2005- 00591		5216 w 11th		3-6-00	
					4" SCH 40 0+89		98-18237		1225 DORIS		9-24-98	3-6-00
2+00	128.30	123.07	5.2		4" SCH 40 1+67.7		2005- 00591		5218 w 11th		3-6-00	
	128.60	123.12	5.5	2+15.7	4" STUB SE 123.45		2005- 60593		5204 w 11th		3-6-00	
0+00 L-2	127.50	120.73	6.8	0+00			99-15847		5311 w 11th		1-27-99	
					4" SCH 40 0+98.6		99-01001		5307W 11th		10-25-99	
1+00	129.00	121.03	8.0		4" SCH 40 0+37		2005- 02259		5310 Memory		9-19-05	
					4" SCH 40 1+69		99-00953		5308 w 11th		10-19-99	3-7-00
2+00	130.30	121.33	9.0		4" SCH 40 2+37.4		2005- 00609		5315 w 11th		10-25-99	3-7-00
					4" SCH 40 2+90.4		99-01000		5315 w 11th		10-25-99	3-7-00
					4" SCH 40 3+58		99-00954		5311 w 11th		10-25-99	3-7-00
3+00	129.20	121.63	7.6		4" SCH 40 3+70		99-00999		5207 w 11th		10-25-99	3-7-00
	128.80	121.92	6.9	3+96.0	4" STUB NE 122.25	4" STUB SE 122.25	99-15857		5205 w 11th		1-27-99	3-7-00
					4" SCH 40				5207 Memory			
2001-01048-4/30/01-5302 w 11th- Padgett Ex- Saddle 29' S of MH 3170.2 (3141.2) Tap on East Side of house.												