

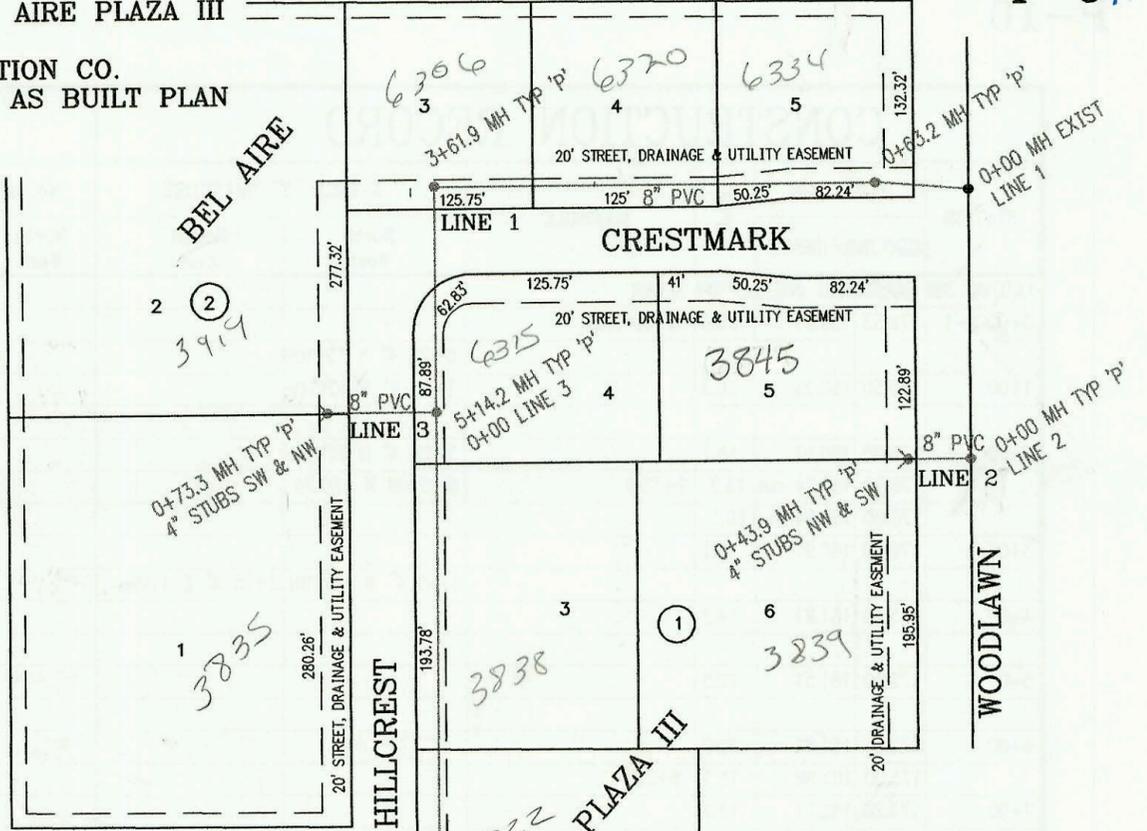


SANITARY SEWER FOR BEL AIRE PLAZA III
PROJECT NO. 781PPS
BUILT BY MIES CONSTRUCTION CO.
BOOKED 6/9/98 PER AS BUILT PLAN

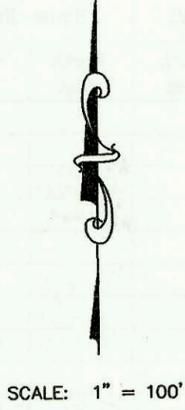


41ST ST. NO.

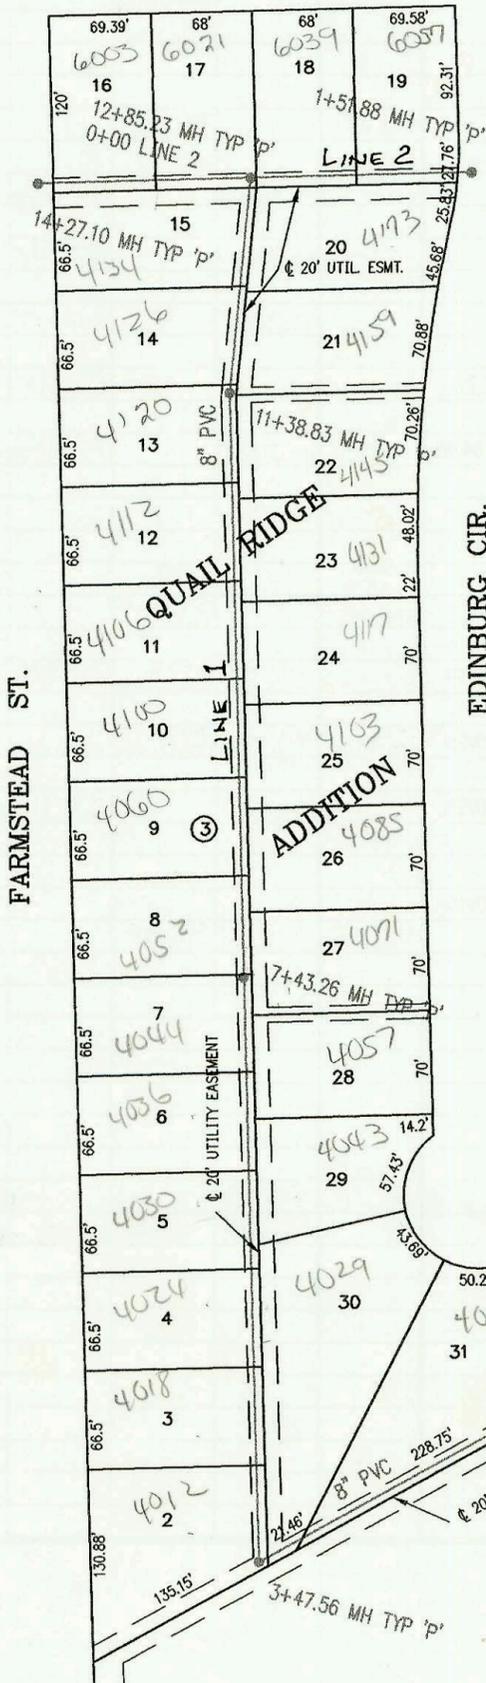

37TH ST. NO.

Bel Aire
SANITARY SEWER FOR QUAIL RIDGE ADDITION (PHASE 2)
PROJECT NO. 760PPS
BUILT BY NOWAK CONSTRUCTION CO.
BOOKED 5/28/98 PER AS BUILT PLAN

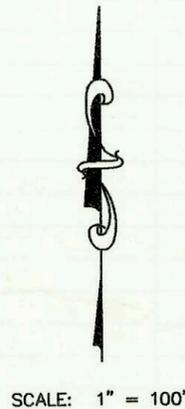

CONSTRUCTION RECORD					SERVICE RECORD							
STATION	ELEVATION		DEPTH	MANHOLE	4-INCH "Y" BRANCHES		No. of Permit		House Number		DATE OF PERMITS	
	GROUND	GRADE			North West	South East	North West	South East	North West	South East	North West	South East
SANITARY SEWER FOR QUAIL RIDGE ADDITION (PHASE 2)												
LINE 1	0+00 L-1	198.80	190.67	8.1	0+00 EXIST	4" SCH 40 OT 22.6		3392		4030 Farmstead		8-3-98
	1+00	199.80	191.09	8.7		4" SCH 40 1+25 TAP		3383		4060 Farmstead		4-17-98
	2+00	200.50	191.50	9.0								
	3+00	201.00	191.92	9.1								
		201.66	192.12 out	9.5	3+47.56							
		201.66	192.22 in	9.4								
	4+00	201.40	192.65	8.7		4" SCH 40 3+61.16 4" SCH 40 4+51.56	4" SCH 40 4+94.6 TAP	2000- 1879	3582	4012 Farmstead	4029 Farmstead	8-22-00 9-17-98
	5+00	202.40	193.47	8.9		4" SCH 40 5+16.26 4" SCH 40 5+39.26	4" SCH 40 Saddle 5+95.3	2000- 00973	3507	4024 Farmstead	4043 Farmstead	4-20-00 4-29-99
	6+00	203.40	194.29	9.1								
						4" SCH 40 6+67.26	4" SCH 40 Saddle 6+83.3	2000- 00653	3251	4036 Farmstead	4057 Farmstead	3-10-00 12-24-98
	7+00	204.40	195.11	9.3								
		205.57	195.47 out	10.1	7+43.26	4" SCH 40 7+90.9 Saddle	4" SCH 40 Saddle 7+60.3	99-01070	99-448	4044 Farmstead	4052 Farmstead	11-99
		205.57	195.57 in	10.0								
	8+00	205.50	195.72	9.8								
	9+00	206.50	195.99	10.5								
						4" SCH 40 10+17.83	4" SCH 40 10+51.83	2000- 00784	99-00329	4052 Farmstead	4071 Farmstead	3-16-00 8-3-99
	10+00	207.60	196.26	11.3								
						4" SCH 40 11+20.83 4" SCH 40 11+89.6		2000- 00705	99-00734	4120 Farmstead	4145 Farmstead	3-16-00 9-22-99
	11+00	208.40	196.53	11.9								
		209.56	197.17	12.4	11+38.83							
		209.56	197.22	12.3								
	12+00	209.60	197.45	12.2		4" SCH 40 12+46.8	4" SCH 40 Predeo 11+76.4	2000- 01677	99-01135	4100 Farmstead	4154 Farmstead	7-20-00 9-22-99
		209.50	197.77 out	11.7	12+85.23 = 0+00 L-2							
		209.50	197.87 in	11.6								
	13+00	209.60	198.23	11.4								
	14+00	211.30	200.64	10.7								
		211.45	201.30	10.2	14+27.10							
LINE 2	0+00 L-2	209.50	197.97	11.5	0+00 = 12+85.23 L-1	4" SCH 40 0+34 4" SCH 40 4+62.8		2000- 02220		6303 E 4181 6051 E 4151		10-10-00 3-16-00
	1+00	207.60	198.37	9.2								
		207.15	198.58	8.6	1+51.88			99-01071		6057 E 4151		11-1-99
SANITARY SEWER TO SERVE BEL AIRE PLAZA III												
LINE 1	0+00 L-1	186.07	174.46	11.6	0+00 EXIST							
		186.39	174.69 out	11.7	0+63.2	4" SCH 40 0+97.2		2000- 01874		6334 CRESTMARK		8-25-00
		186.40	174.80 in	11.6								
	1+00	187.10	175.52	11.6								
						4" SCH 40 2+54.9		2000- 01135		6320 CRESTMARK		5-8-00
	2+00	187.10	177.46	9.6								
	3+00	188.90	179.41	9.5								
		188.92	180.61 out	8.3	3+61.9							
		188.92	180.81 in	8.1								
	4+00	189.40	180.98	8.4								
	5+00	190.40	181.42	9.0								
		190.09	181.48	8.6	5+14.2 = 0+00 L-3							
		190.09	181.62	8.5								
	6+00	186.00	182.00	4.0								
	7+00	186.80	182.44	4.4								
	8+00	187.60	182.88	4.7								
	9+00											
		191.93	183.33	8.6	9+03.2		4" SCH 40 4" STUB SE 183.53		3522		6300 E 3774 N	5-20-99
LINE 2	0+00 L-2	186.36	173.31 out	13.1	0+00 EXIST							
		186.36	174.12 in	12.2								
		184.40	174.32	10.1	0+42.5	4" STUB NW 174.65	4" STUB SW 174.65	2000- 02624		6245 Woodlawn		11-30-00
LINE 3	0+00 L-3	189.79	181.62	8.2	0+00 = 5+14.2 L-1							
		190.00	181.87	8.1	0+73.3	4" STUB NW 182.2	4" STUB SW 182.2	2000- 00038	3381	3919 Hillcrest	3885 Hillcrest	1-7-2000 7-6-98