


MAIN 25, WAR INDUSTRIES SEWER
PROJECT NO. 468-82318 (741512)
BUILT BY WILDCAT CONSTRUCTION CO.
BOOKED 6/12/98 PER AS BUILT PLAN

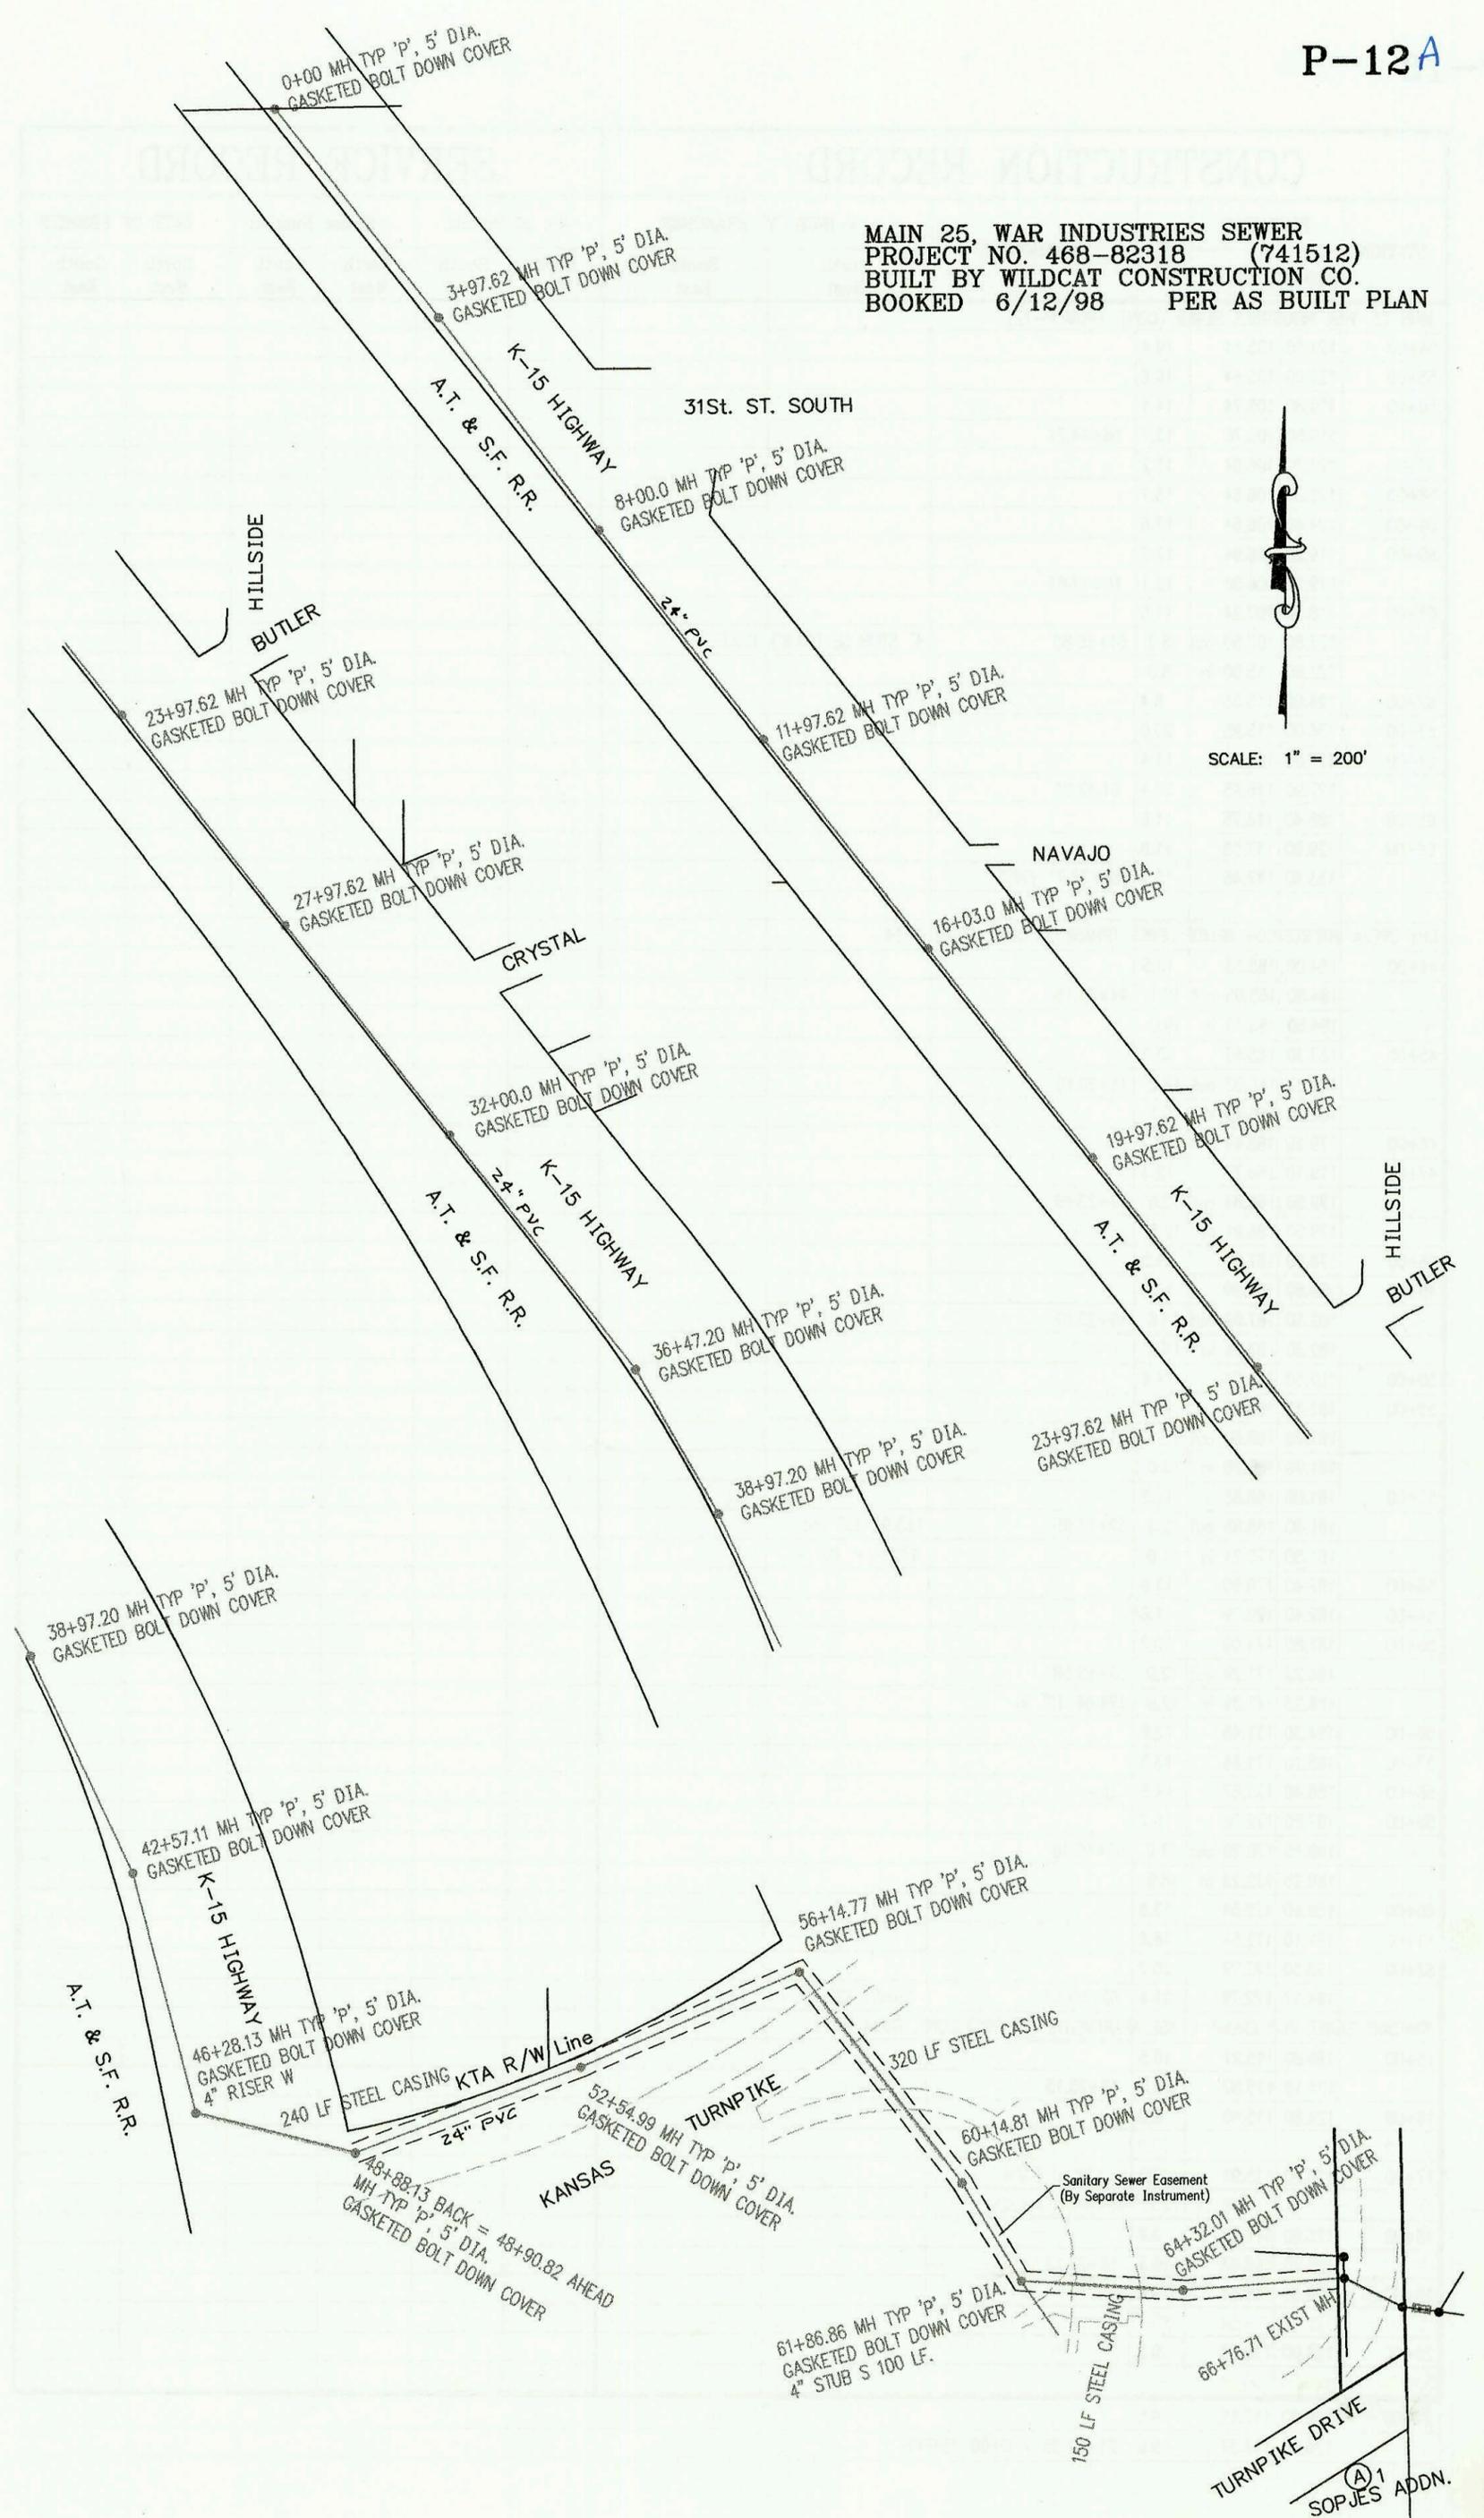

SCALE: 1" = 200'

CONSTRUCTION RECORD					SERVICE RECORD							
STATION	ELEVATION		DEPTH	MANHOLE	4-INCH "Y" BRANCHES		No. of Permit		House Number		DATE OF PERMITS	
	GROUND	GRADE			North West	South East	North West	South East	North West	South East	North West	South East
MAIN 25, WAR INDUSTRIES SEWER												
0+00	91.90	80.89	11.0	0+00 EXIST								
1+00	91.90	81.19	10.7									
2+00	91.90	81.49	10.4									
3+00	92.40	81.79	10.6									
	91.70	82.08	9.6	3+97.62								
4+00												
5+00	92.80	82.39	10.4									
6+00	94.10	82.69	11.4									
7+00	94.60	82.99	11.6									
	93.30	83.28	10.0	8+00								
8+00												
9+00	93.30	84.30	9.0									
10+00	94.10	85.30	8.8									
11+00	94.00	86.30	7.7									
	93.10	87.27	5.8	11+97.62								
12+00												
13+00	94.40	87.58	6.8									
14+00	94.10	87.88	6.2									
15+00	94.40	88.18	6.2									
16+00												
	94.30	88.47	5.8	16+03								
17+00	94.80	88.78	6.0									
18+00	95.30	89.08	6.2									
19+00	95.80	89.38	6.4									
	95.20	89.67	5.5	19+97.62								
20+00												
21+00	96.20	89.98	6.2									
22+00	96.60	90.28	6.3									
23+00	96.80	90.58	6.2									
	96.00	90.87	5.1	23+97.62								
24+00												
25+00	97.80	91.59	6.2									
26+00	99.30	92.29	7.0									
27+00	100.40	92.99	7.4									
	99.90	93.66	6.2	27+97.20								
28+00												
29+00	101.50	94.39	7.1									
30+00	102.60	95.09	7.5									
31+00	105.80	95.79	10.0									
	106.80	96.46 out	10.3	32+00								
	106.80	98.53 in	8.3									
32+00												
33+00	107.40	98.84	8.6									
34+00	108.30	99.14	9.2									
35+00	109.60	99.44	10.2									
36+00	110.90	99.74	11.2									
	110.60	99.88	10.7	36+47.2								
37+00	112.10	100.04	12.1									
38+00	112.10	100.34	11.8									
	113.40	100.63	12.8	38+97.2								
39+00												
40+00	116.20	100.94	15.3									
41+00	116.80	101.24	15.6									
42+00	117.10	101.54	15.6									
	115.90	101.71	14.2	42+57.11								
43+00	117.10	101.84	15.3									
44+00	117.70	102.14	15.6									
45+00	118.10	102.44	15.7									
46+00	118.00	102.74	15.3									
	118.10	102.82	15.3	46+28.13	4" RISER W							
47+00	121.60	103.04	18.6									
48+00	123.10	103.34	19.8									
	116.40	103.57 out	12.8	48+88.13 BACK								
	116.40	103.61 in	12.8	48+90.82 AHEAD								
49+00	117.50	103.64	13.9									
50+00	119.60	103.94	15.7									
51+00	123.80	104.24	19.6									
52+00	125.40	104.54	20.9									
	125.50	104.70	20.8	52+54.99								
53+00	124.50	104.84	19.7									