


MAIN 25, WAR INDUSTRIES SEWER
PROJECT NO. 468-82318 (741512)
BUILT BY WILDCAT CONSTRUCTION CO.
BOOKED 6/12/98 PER AS BUILT PLAN



SCALE: 1" = 200'

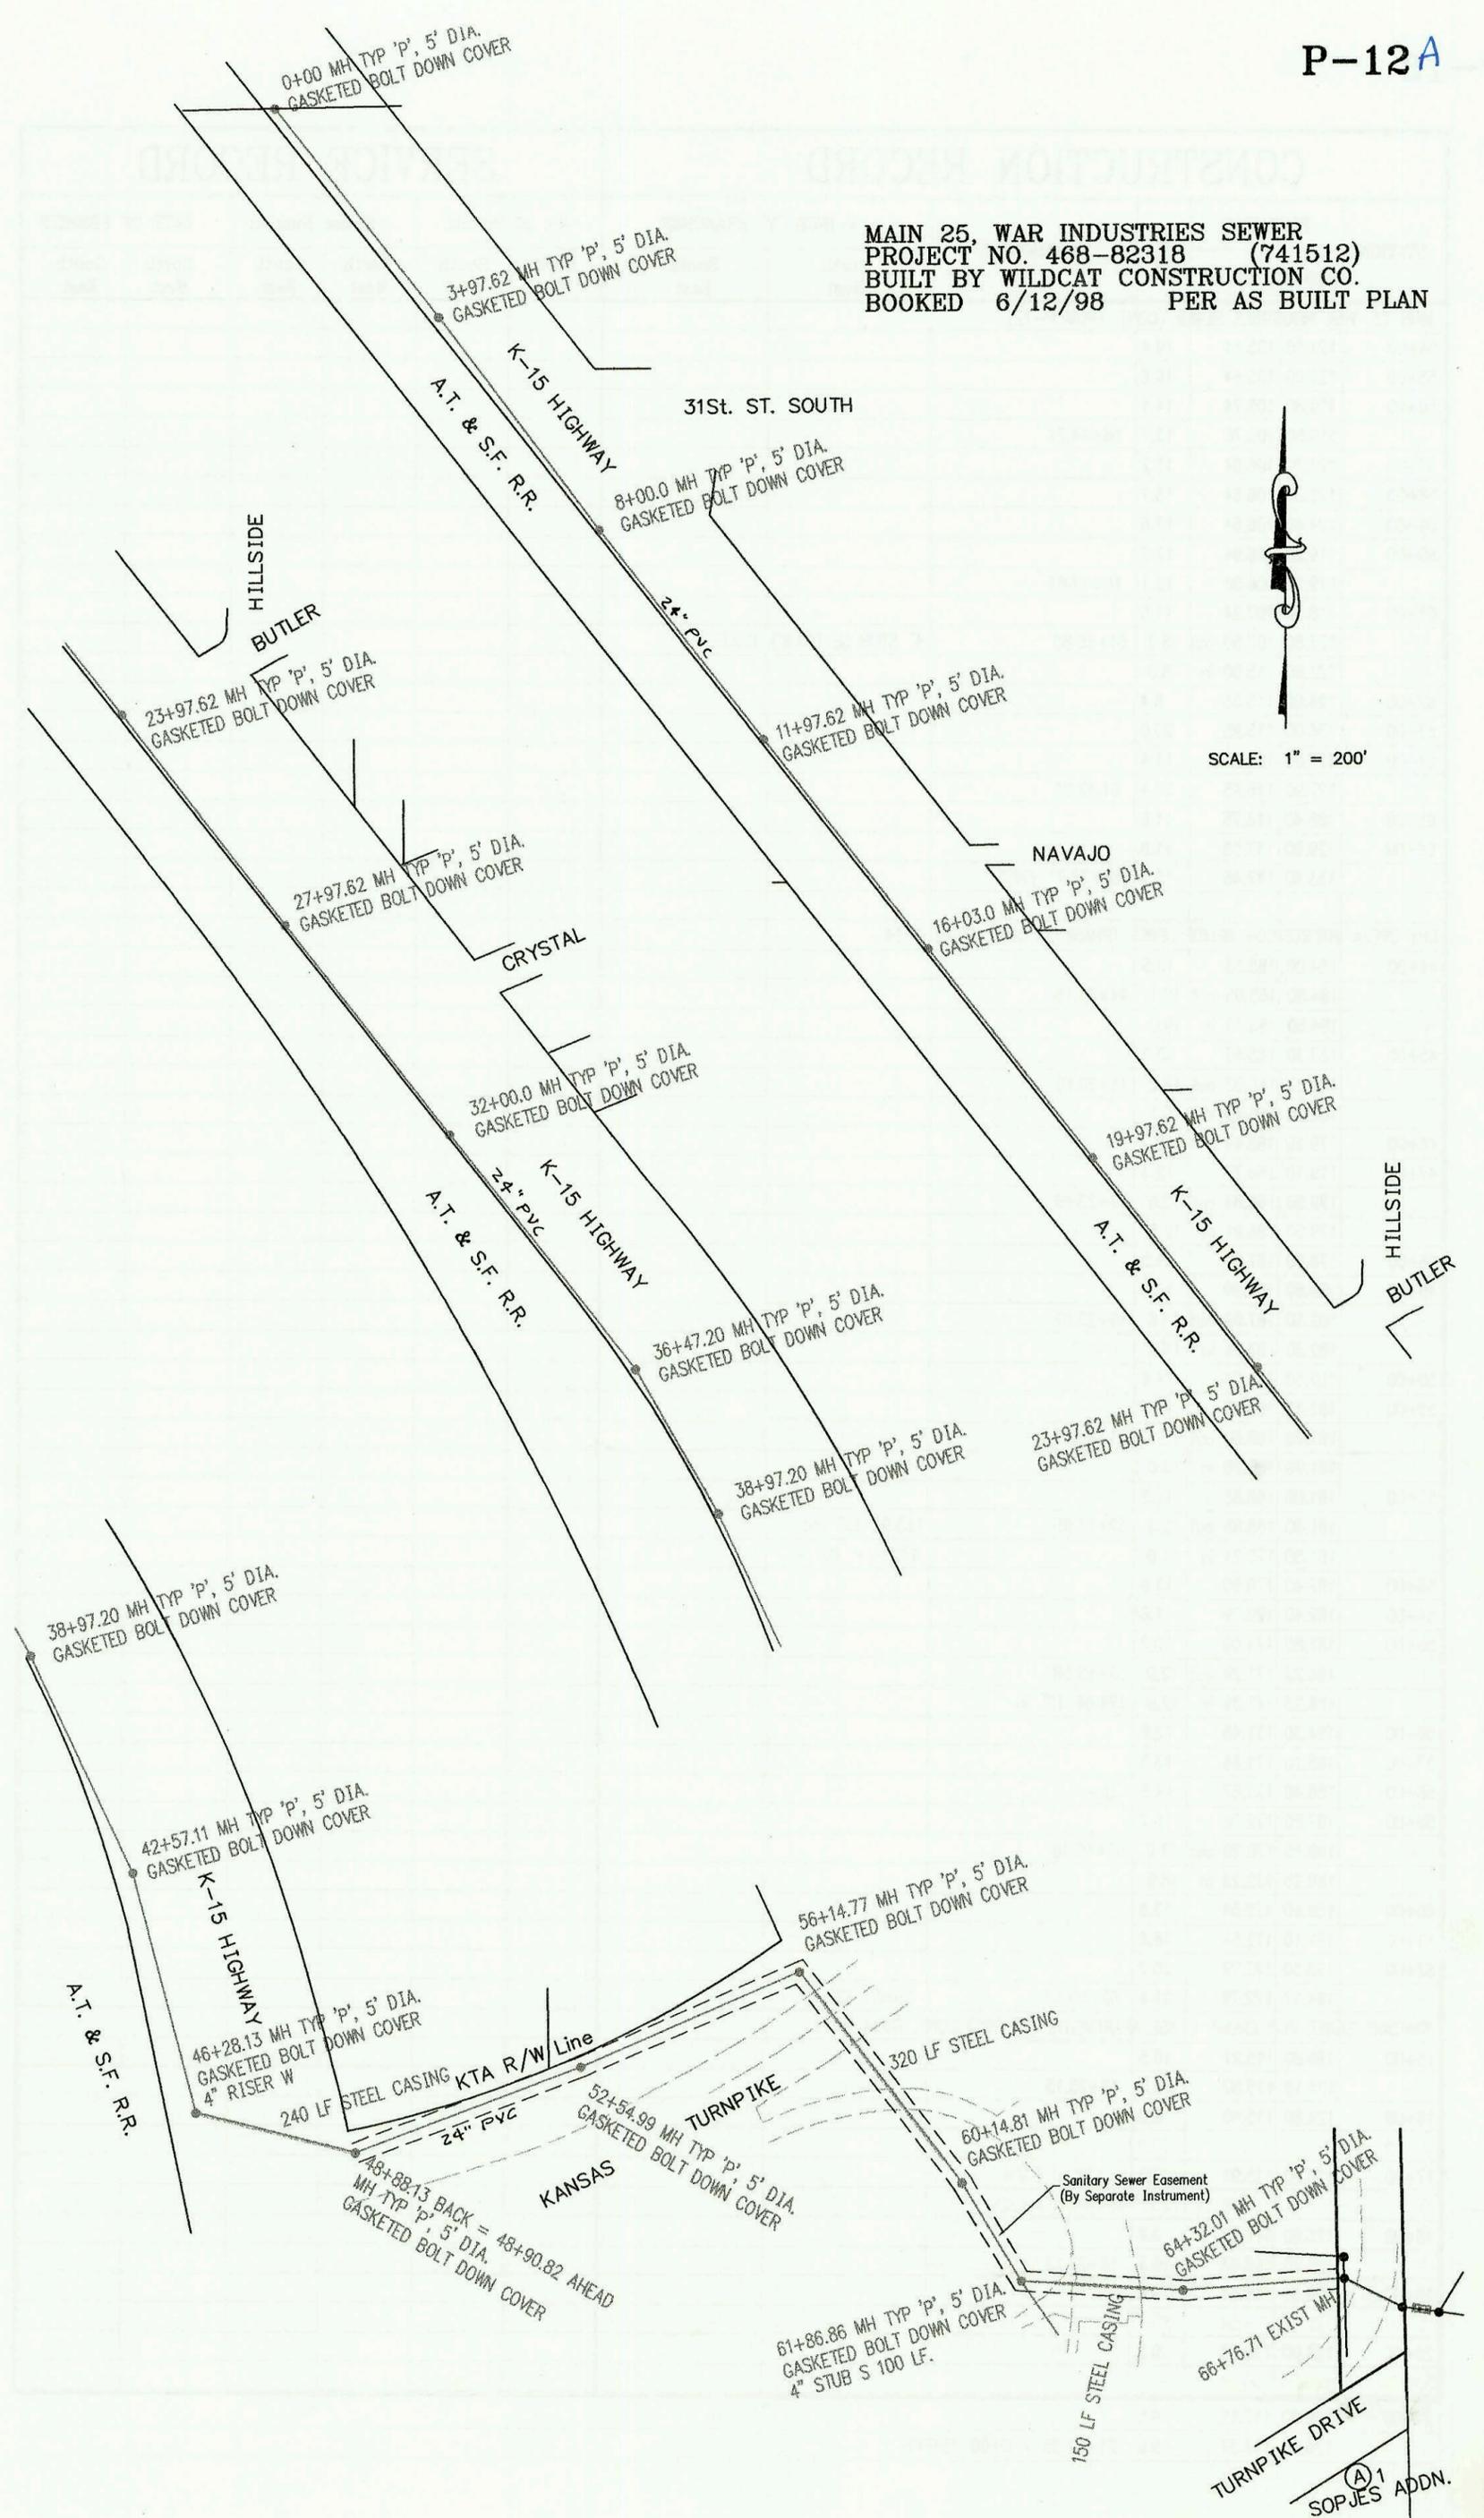