


LATERAL 321, SOUTHWEST INTERCEPTOR SEWER
PROJECT NO. 468-82291 (743336)
BUILT BY MIES CONSTRUCTION CO.
BOOKED 7/30/98 PER PLAN - annexed into City



SCALE: 1" = 100'

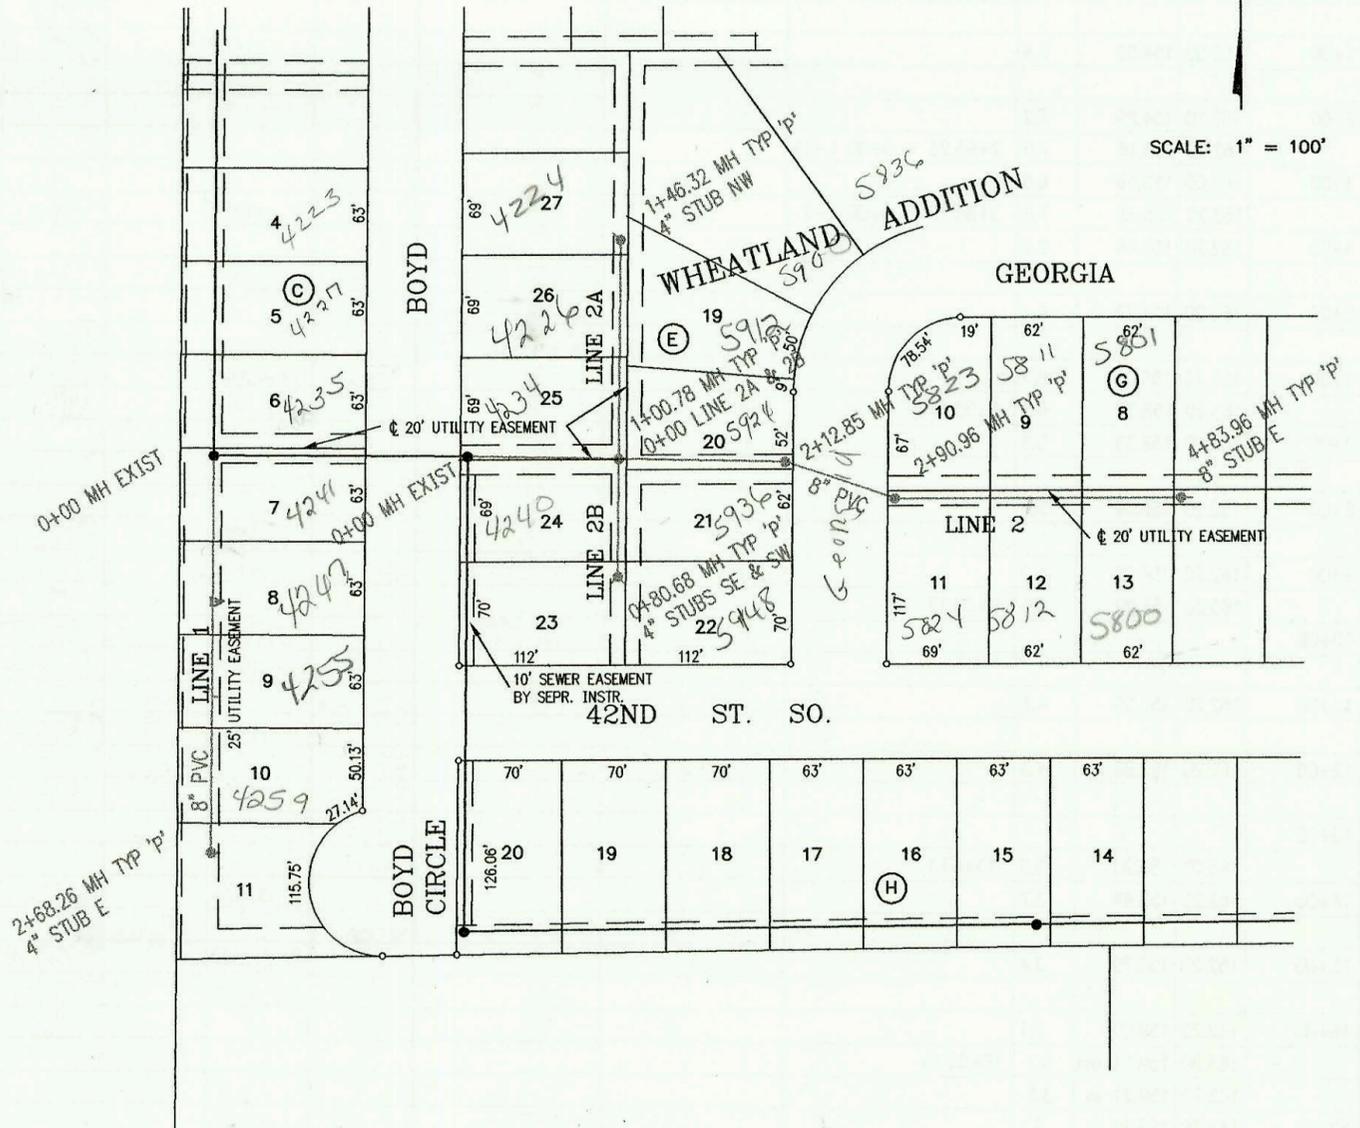

CONSTRUCTION RECORD					SERVICE RECORD							
STATION	ELEVATION		DEPTH	MANHOLE	4-INCH "Y" BRANCHES		No. of Permit		House Number		DATE OF PERMITS	
	GROUND	GRADE			North West	South East	North West	South East	North West	South East	North West	South East
LATERAL 381, SOUTHWEST INTERCEPTOR SEWER (CONT. FROM P-19)												
LINE 6 2+00			13.9		4" SCH 40 2+10 4" W 8V4H		2000-01136		3208 N Lake Ridge			5-8-00
3+00	143.70	138.14	5.6		3+00 4" W 2V4H		2001-02473		3219 Lake Ridge			10-5-01
4+00	143.70	138.44	5.3		4" SCH 40 3+90 4" W 2V4H		2001-00068		3206 N Lake Ridge			1-10-01
	144.10	138.59 out	5.5	4+51.2								
	144.10	138.79 in	5.3									
5+00	150.60	139.38	11.2									
6+00	153.60	140.58	13.0									
	154.50	140.95	13.6	6+30.7								
7+00	155.50	141.16	14.3		6+60 4" N 8V19H 6+50 4" S 8V9H							
					7+45 4" N 11V19H 7+50 4" S 11V9H		2004-05230	9814928-7	3219 Lake Ridge	8114 West Lakes		1-26-04 7-27-98
8+00	157.50	141.46	16.0		8+25 4" N 12V19H 8+20 4" S 12V9H		2004-02221	9814927-7	3223 Lake Ridge	8118 West Lakes		10-14-04 7-27-98
9+00	159.40	141.76	17.6									
	158.50	141.99	16.5	9+77.5				99-3840-7		8122 West Lake		3-3-99
	158.50	142.09	16.4					97-2926-7		8126 West Lake		2-1-91
10+00	157.60	142.16	15.4		10+15 4" W 11V19H		500P 1999-00057		3220 Forest Ridge			6-26-99
								2004-02594		3227 Lake Ridge		11-12-04
11+00	156.30	142.46	13.8		11+10 4" W 10V19H 11+55 4" E 11V9H		9910229-7		3224 Forest Ridge			5-13-99
	158.00	142.67	15.3	11+73.4								
12+00	157.90	142.76	15.1		11+95 4" W 11V19H		99-8947-7		3228 Forest Ridge			4-29-99
					12+75 4" W 8V19H 12+95 4" E 7V9H		99-00382	2004-02859	3302 Forest Ridge	3313 Forest Ridge		8-26-99 11-24-04
13+00	154.60	143.06	11.5		13+55 4" W 9V19H 13+60 4" E 9V9H		99-10910-7	2004-03070	3300 Forest Ridge	3319 Lake Ridge		10-15-99 12-27-04
	156.80	143.26	13.5	13+87.9								
14+00	156.10	143.36	12.7		14+30 4" W 8V19H		99-05203		3310 Forest Ridge			7-15-99
15+00	154.10	143.66	10.4									
	154.30	143.70	10.6	15+12.4	4" STUB NW 143.97 4" STUB NE 143.97		99-3852-7		3314 Forest Ridge			3-9-99
LATERAL 321, SOUTHWEST INTERCEPTOR SEWER												
0+00 L-1	121.10	109.67	11.4	0+00 EXIST	4" SCH 40 0+40			99-01		4241 Boyd		11-23-99
1+00	119.00	109.97	9.0					99-01213		4247 Boyd		11-19-99
					4" SCH 40 1+58.26			2000-0412		4255 Boyd		4-12-00
2+00	118.20	110.27	7.9		4" SCH 40 2+23.26			2005-01721		4259 Boyd		7-28-05
	118.00	110.47	7.5	2+68.26	4" STUB E 110.81							
0+00 L-2	120.20	110.28	9.9	0+00 EXIST								
1+00	121.00	110.58 out	10.4	1+00.78 = 0+00 L-2A & L-2B								
	121.00	110.68 in	10.3									
2+00	121.40	110.98	10.4									
	121.90	110.92 out	11.0	2+12.85								
	121.90	111.02 in	10.9									
	121.80	111.25 out	10.6	2+90.96								
	121.80	111.35 in	10.5									
3+00	121.50	111.38	10.1		4" SCH 40 3+78.96		98-2224-7	99-6533-7	5823 Georgia	5824 W 42nd		10-16-98 4-8-99
							98-21133-7	2005-00507	5811 Georgia	5812 W 42nd		12-10-98 2-25-00
4+00	122.00	111.68	10.3					3329	99-4995-7	5801 Georgia	5800 W 42nd	9-18-98 3-19-99
	122.90	111.93	11.0	4+83.96	8" STUB E 111.93							
0+00 L-2A	121.00	110.68	10.3	0+00 = 1+00.78 L-2	4" SCH 40 0+16	4" SCH 40 0+27	99-00597	2005-00506	4224 Boyd	5924 Georgia		9-3-99 2-25-00
							1999-00238		4226 Boyd			8-13-99
1+00	121.00	110.98	10.0					99-10528-7		5912 Georgia		5-13-99
	121.70	111.12	10.6	1+46.32	4" STUB NW 111.46		99-10695-7		4224 Boyd			5-26-99
0+00 L-2B	121.00	110.68	10.3	0+00 = 1+00.78 L-2	4" SCH 40 0+40	4" SCH 40 0+77	99-01343	2000-01452	4220 Boyd	5936 Georgia		11-30-99 6-9-00
	121.40	110.92	10.5	0+80.68	4" STUB SW 111.26 4" STUB SE 111.26		99-10808		5948 W GEORGIA			9-29-00