



LATERAL 18, MAIN 13, SOUTHWEST INTERCEPTOR SEWER
PROJECT NO. 468-82794 (743427)
BUILT BY W. B. CARTER CONSTRUCTION CO.
BOOKED 8/4/98 PER PLAN

SCALE: 1" = 100'

A. T. & SF. RAILROAD

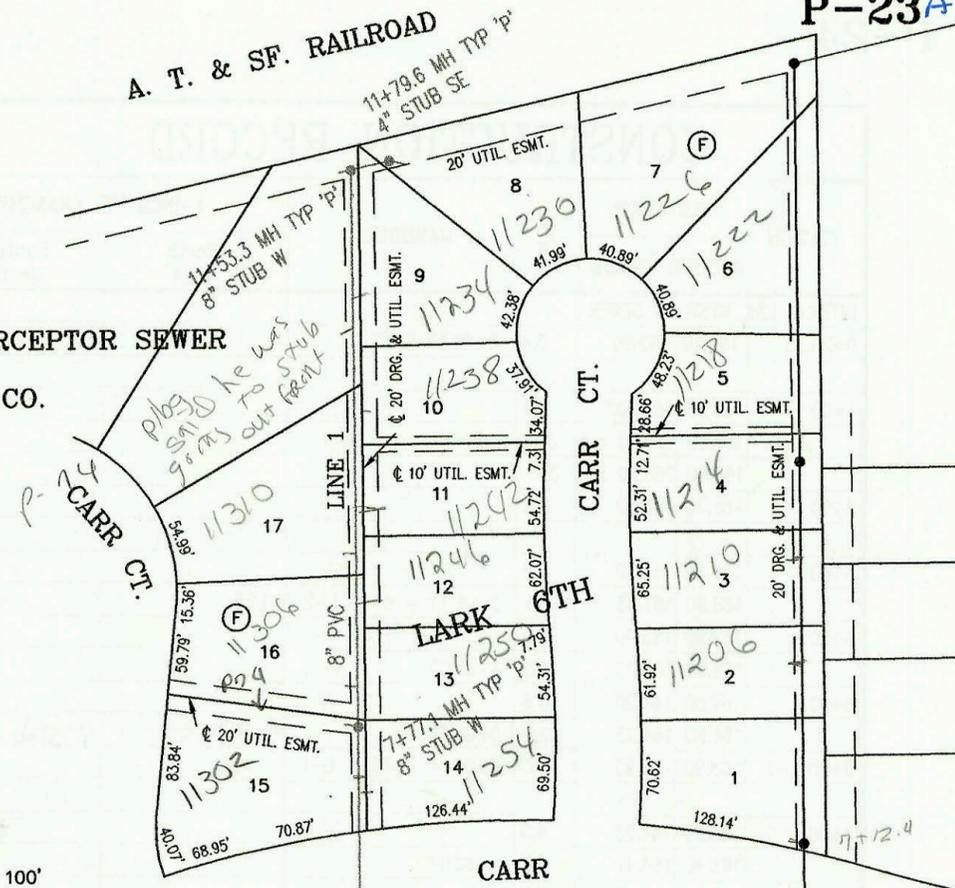


13th St.

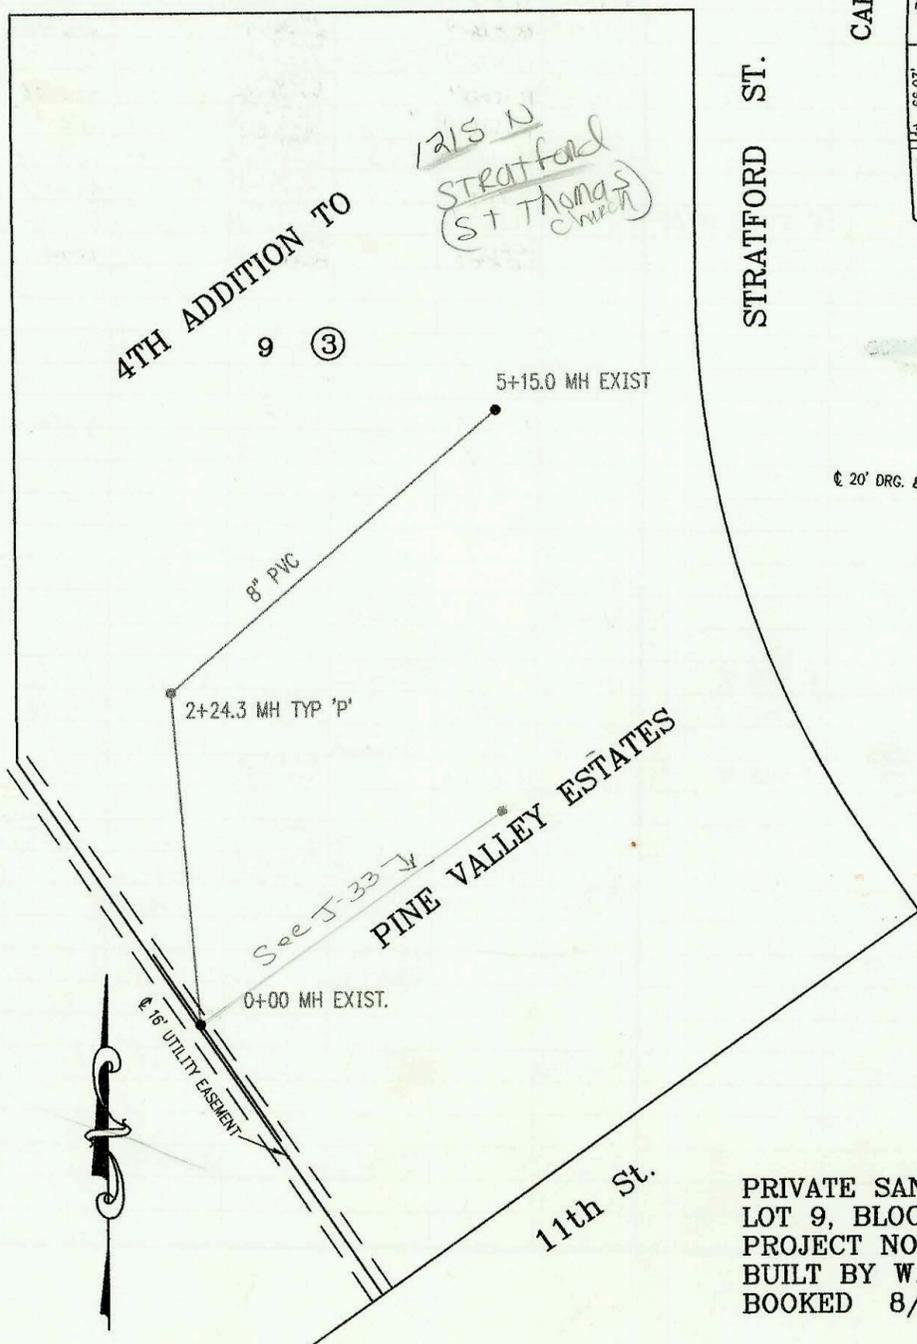

SCALE: 1" = 100'

STRATFORD ST.

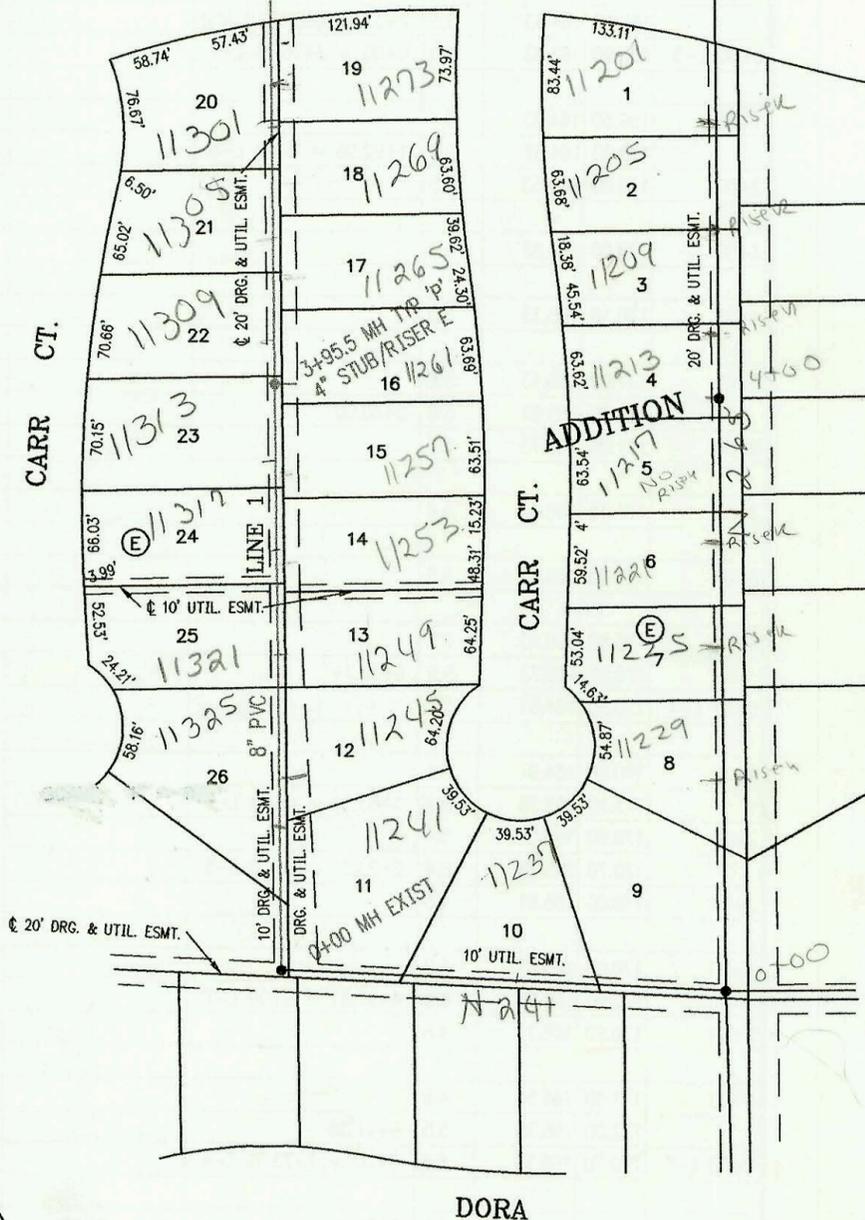

DORA

PRIVATE SANITARY SEWER EXTENSION TO SERVE
LOT 9, BLOCK 3, 4TH ADDITION TO PINE VALLEY ESTATES
PROJECT NO. 644PPS
BUILT BY W. B. CARTER CONSTRUCTION CO.
BOOKED 8/3/98 PER AS BUILT PLAN

