


LATERAL 93, SANITARY SEWER NO. 23
PROJECT NO. 468-82777 (743310)
BUILT BY NOWAK CONSTRUCTION CO.
BOOKED 8/4/98 PER AS BUILT PLAN



SCALE: 1" = 100'

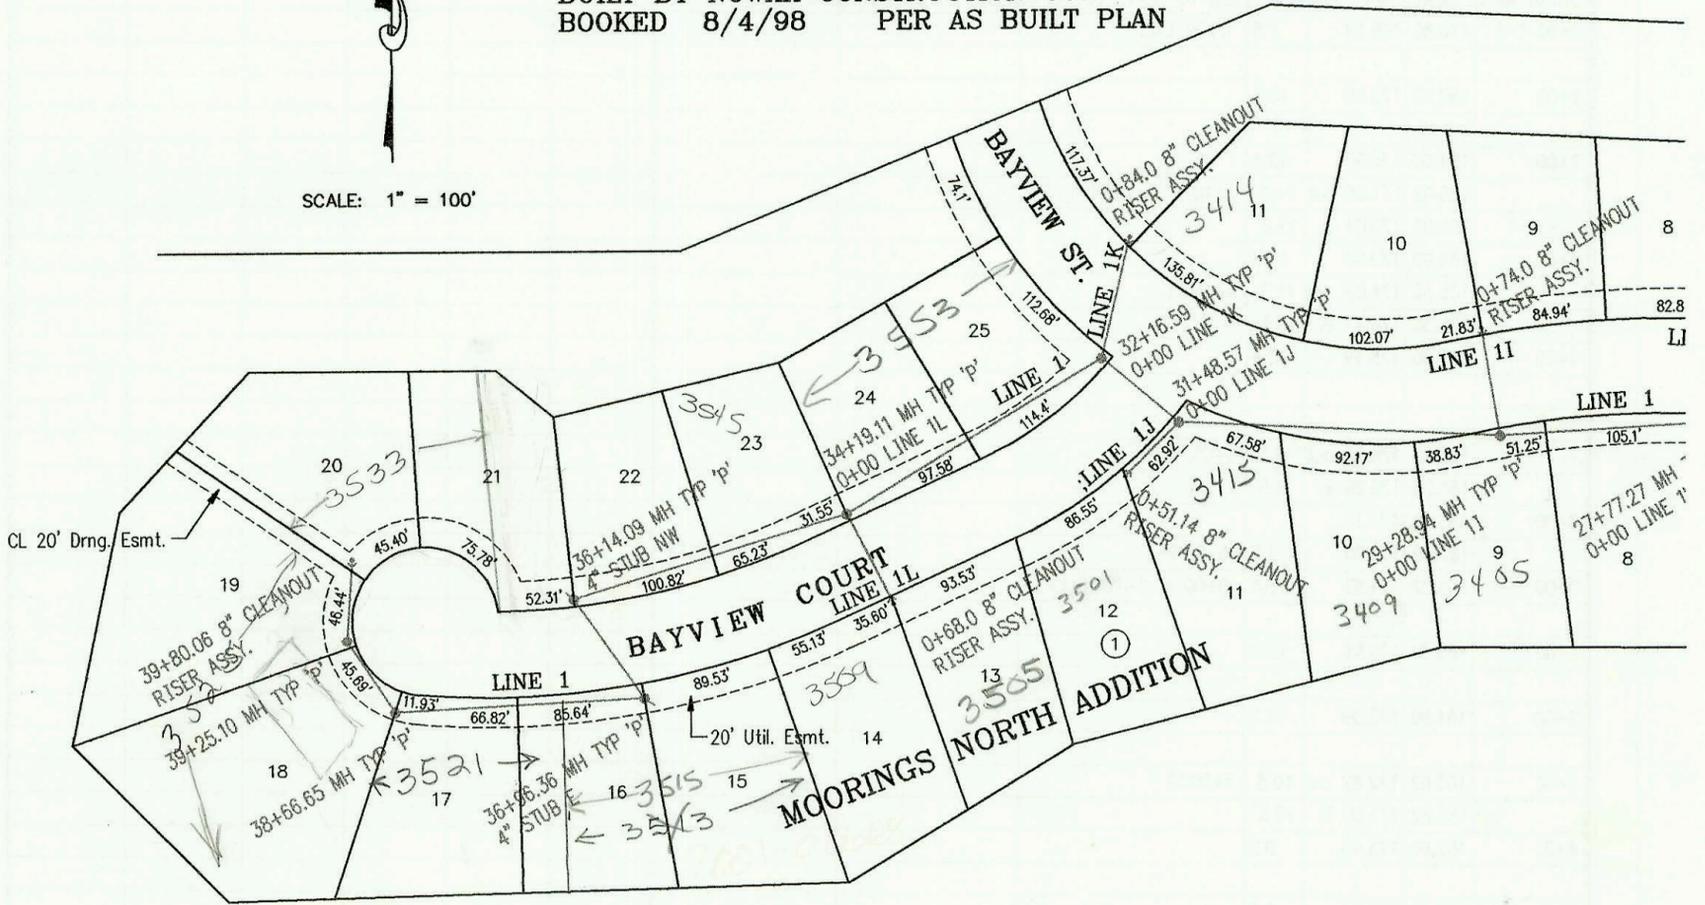

CONSTRUCTION RECORD					SERVICE RECORD							
STATION	ELEVATION		DEPTH	MANHOLE	4-INCH "Y" BRANCHES		No. of Permit		House Number		DATE OF PERMITS	
	GROUND	GRADE			North West	South East	North West	South East	North West	South East	North West	South East
L-3 CONT. LATERAL 93, SANITARY SEWER NO. 23 (CONT. FROM P-29)												
6+00	143.50	134.03	9.5					2003 02630	4933 Sandkey			10-10-03
	143.90	134.07	9.8	6+15.89 Cleanout Riser w/ Si. wye			2005 0125	4929 Sandkey		42602		
0+00 L-3A	144.90	132.41	12.5	0+00 = 2+20.46 L-3				2004 01594	4917 Sandkey			6-2-04
1+00	144.10	132.71	11.4									
	144.30	132.94	11.4	1+56.4								
2+00	143.60	133.11	10.5									
	143.90	133.16	10.7	2+18.11 Cleanout Riser w/ Si. wye	4" sch 40 PVC 10 Riser			2005- 02405	4925 Sandkey			10-7-05
0+00 L-4	145.40	131.64	13.8	0+00 = 3+96.89 L-1								
1+00												
	145.30	132.05 out	13.3	1+02.34								
	145.30	132.15 in	13.2									
2+00	142.00	132.54	9.5		4" sch 40 PVC 2+10.34			2004 02044	4959 Sandkey			11-19-04
3+00	141.60	132.94	8.7									
	140.70	133.21	7.5	3+66.19	4" sch 40 4" STUB NE 133.54			2005- 03023	5005 N Sandkey			12-14-05
0+00 L-5	143.90	132.74	11.2	0+00 = 8+98.97 L-1								
					4" sch 40 PVC 0+27			2004- 00271	5057 N Sandkey			
1+00	144.00	133.14	10.9									
	144.80	133.18	11.6	1+10.16 = 0+00 L-5A								
2+00	144.50	133.54	11.0									
	145.10	133.88	11.2	2+79.01								
3+00	144.30	133.94	10.4		4" sch 40 3+04.14			2005- 02390	5045 Sandkey			10-10-05
	144.40	134.26	10.1	3+80.14				0465027	5017 Sandkey			4-12-99
4+00	143.70	134.34	9.4									
	144.00	134.48	9.5	4+40.01 Cleanout Riser w/ Si. wye	4" sch 40 4+40.01			2000- 0703	5057 Sandkey			3-16-00
0+00 L-5A	144.80	133.28	11.5	0+00 = 1+10.16 L-5	4" sch 40 0+09.34			2004 03133	5017 Sandkey			11-29-04
	145.00	133.59	11.4	0+76.34				160 03353	5057 Sandkey			12-20-02
1+00	144.40	133.68	10.7									
								2002 0398B	5055 Sandkey			3-29-02
2+00	144.40	134.08	10.3									
								9911987	5009 Sandkey			1-22-99
3+00	144.00	134.48	9.5									
	144.70	134.59	10.1	3+26.54		4" STUB SW 134.92		9952917	5033 Sandkey			3-31-99
0+00 L-6	143.50	133.00	10.5	0+00 = 10+27.6 L-1								
1+00	141.60	133.40	8.2									
2+00	141.70	133.80	7.9									
	140.40	134.05	6.3	2+61.57		8" STUB E 134.38						
0+00 L-7	143.10	133.10	10.0	0+00 = 10+61.89 L-1								
1+00	142.00	133.30	8.7									
2+00	142.20	133.50	8.7									
3+00	142.50	133.70	8.8									
	140.80	133.86	6.9	3+82.21		10" STUB N 133.86						