


SANITARY SEWER TO SERVE LOT 1, R. L. HAYES 2ND ADDITION
PROJECT NO. 820PPS
BUILT BY UTILITY CONTRACTOR INC.
BOOKED 11/4/98 PER AS BUILT PLAN

WICHITA-VALLEY CENTER FLOOD CONTROL
CHISHOLM CREEK DIVERSION CASE NO. A-41035

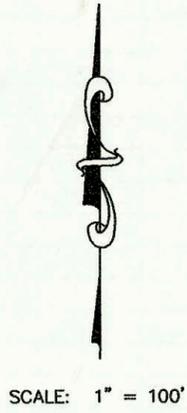

BURLINGTON NORTHERN RAILROAD

R. L. HAYES

1090
New Bldg in
1998

lot 1
8" PVC
7+96.29 MH TYP 'p'
6" STUB W
5+81.82 MH TYP 'p'

2ND ADDITION

PRIO. Maint Lino
by Prop. owner

1090
Bldgs to be
wrecked
6/01

2+79.95 MH TYP 'p'
487.57'

10' Utility Easement
by Sepr. Instr.

20' Utility Easement

0+23.49 MH TYP 'p'
0+00 MH EXIST



37TH ST. NO.

REFLECTION RIDGE

COMMERCIAL 2ND
2243
(Accordily
GRILL)

ADDITION

RIDGE ROAD

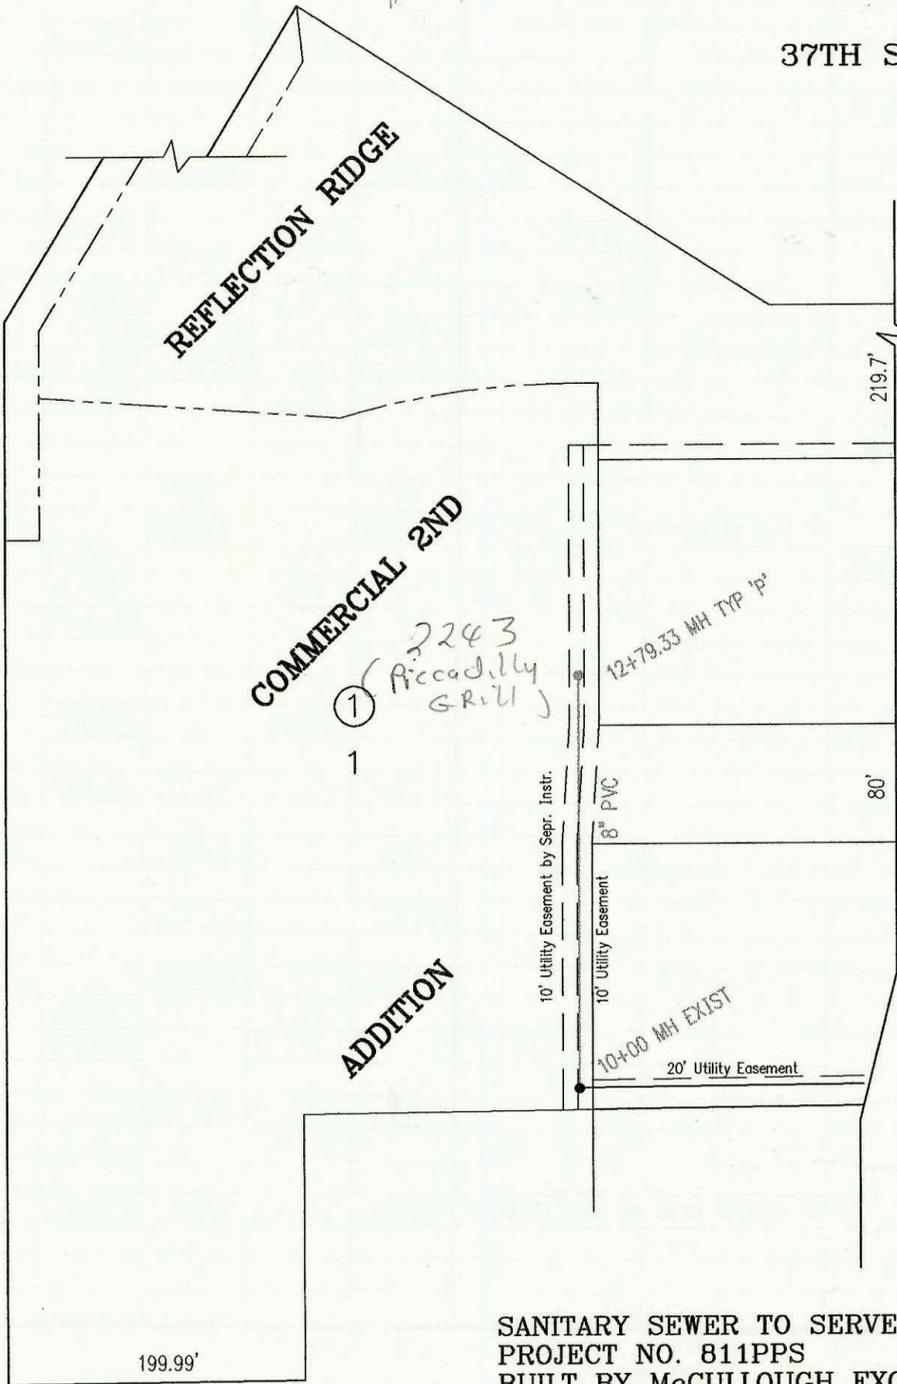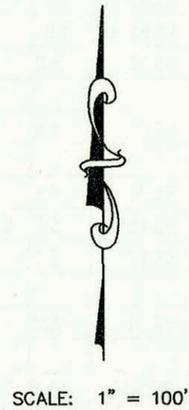

199.99'

21ST ST. N.

SANITARY SEWER TO SERVE REFLECTION RIDGE PLAZA
PROJECT NO. 811PPS
BUILT BY McCULLOUGH EXCAVATION INC.
BOOKED 11/20/98 PER AS BUILT PLAN

