


MAIN 2, COWSKIN INTERCEPTOR SEWER  
 PROJECT NO. 468-82838 (743500)  
 BUILT BY NOWAK CONSTRUCTION CO.  
 11/23/98 PER AS BUILT PLAN



SCALE: 1" = 150'

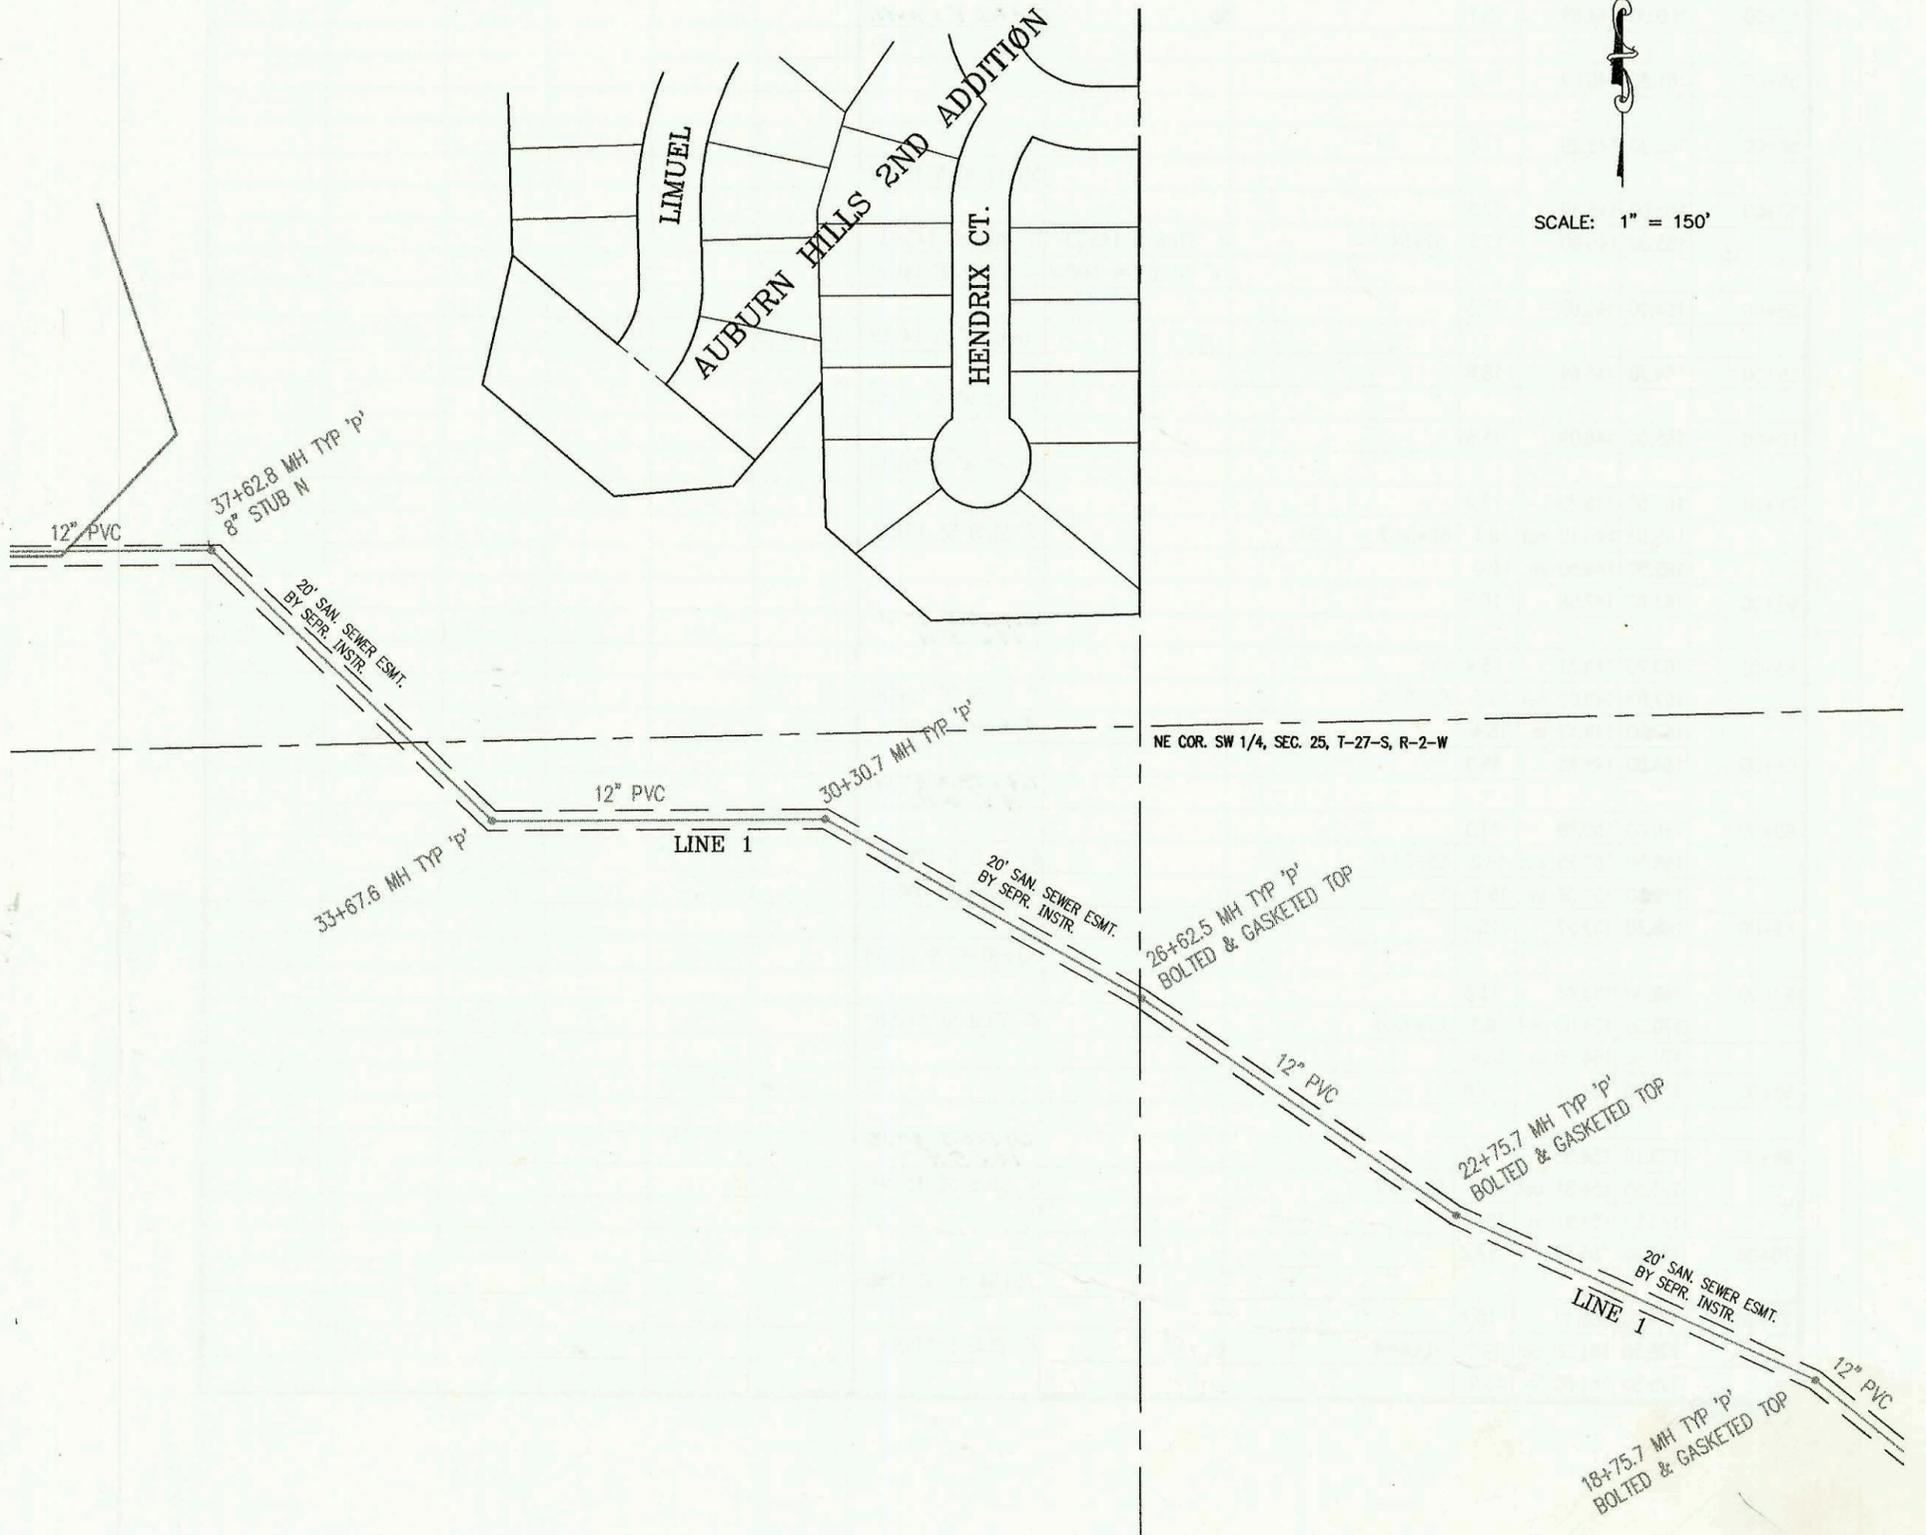

CONSTRUCTION RECORD						SERVICE RECORD						
STATION	ELEVATION		DEPTH	MANHOLE	4-INCH "Y" BRANCHES		No. of Permit		House Number		DATE OF PERMITS	
	GROUND	GRADE			North West	South East	North West	South East	North West	South East	North West	South East
MAIN 2, COWSKIN INTERCEPTOR			SEWER									
0+00 L-1	128.20	116.03 out	12.2	0+00 EXIST								
	128.20	116.70 in	11.5									
1+00	128.70	116.90	11.8									
	129.00	116.91 out	12.1	1+06.8		8" STUB S 117.75						
	129.00	117.01 in	12.0									
2+00	128.00	117.20	10.8									
3+00	127.30	117.40	9.9									
4+00	126.70	117.60	9.1									
5+00	127.00	117.80	9.2									
	127.50	117.81 out	9.7	5+06.8								
	127.50	117.91 in	9.6									
6+00	127.20	118.10	9.1									
7+00	127.50	118.30	9.2									
8+00	127.70	118.50	9.2									
9+00	127.90	118.70	9.2									
	128.50	118.71 out	9.8	9+06.8								
	128.50	118.81 in	9.7									
10+00	128.10	119.00	9.1									
11+00	128.30	119.20	9.1									
12+00	128.20	119.40	8.8									
	129.00	119.43 out	9.6	12+18.6								
	129.00	119.53 in	9.5									
13+00	128.60	119.70	8.9									
14+00	128.50	119.90	8.6									
15+00	129.50	120.09 out	9.4	14+99.9		10" STUB S 120.76						
	129.50	120.19 in	9.3									
16+00	129.30	120.40	8.9									
17+00	129.80	120.60	9.2									
	130.50	120.62 out	9.9	17+16.5		10" STUB S 121.29						
	130.50	121.12 in	9.4									
18+00	129.10	121.29	7.8									
	130.50	121.44	9.1	18+75.7								
	130.50	121.54	9.0									
19+00	129.00	121.59	7.4									
20+00	129.60	121.79	7.8									
21+00	129.50	121.99	7.5									
22+00	129.50	122.19	7.3									
	130.50	123.34 out	7.2	22+75.7								
	130.50	123.44 in	7.1									
23+00	129.50	122.49	7.0									
24+00	129.80	122.69	7.1									
25+00	130.20	122.89	7.3									
26+00	131.00	123.09	7.9									
	132.50	123.21 out	9.3	26+62.5								
	132.50	123.21 in	9.3									
27+00	132.00	123.54	8.5									
28+00	132.20	124.17	8.0									
29+00	133.20	124.80	8.4									
30+00	134.30	125.42	8.9									
	<del>136.60</del>	125.62 out	<del>11.0</del>	30+30.7								
	<del>136.60</del>	125.72 in	<del>10.9</del>									
31+00	135.40	126.15	9.2									
32+00	136.10	126.78	9.3									
33+00	137.00	127.40	9.6									
	137.50	127.83 out	9.7	33+67.6								
	137.50	127.93 in	9.8									
34+00	137.60	128.13	9.5									
35+00	138.70	128.75	9.9									
36+00	140.00	129.38	10.6									
37+00	140.90	130.01	10.9									
	148.00	130.40 out	17.6	37+62.8								
	148.00	130.50 in	17.5									
38+00	143.30	131.20	12.1									
39+00	146.60	133.09	13.5									
40+00	148.30	134.97	13.3									
	150.50	136.20 out	14.3	40+65.1	4" STUB NE 9V5H							
	150.50	136.30 in	14.2									
41+00	150.30	136.40	13.9		4" SCH 40 41+00 4" NE 10V5H 41+90 4" NE 10V5H							
						2002-01376		13117 Hayden			5-16-02	
						2000-2003 2001-00469		13111 Hayden 13115 Hayden			1-20-2000 3-5-01	