


NW COR. SW 1/4, SEC. 25, T-27-S, R-2-W

MAIN 2, COWSKIN INTERCEPTOR SEWER  
 PROJECT NO. 468-82838 (743500)  
 BUILT BY NOWAK CONSTRUCTION CO.  
 11/23/98 PER AS BUILT PLAN

SCALE: 1" = 150'

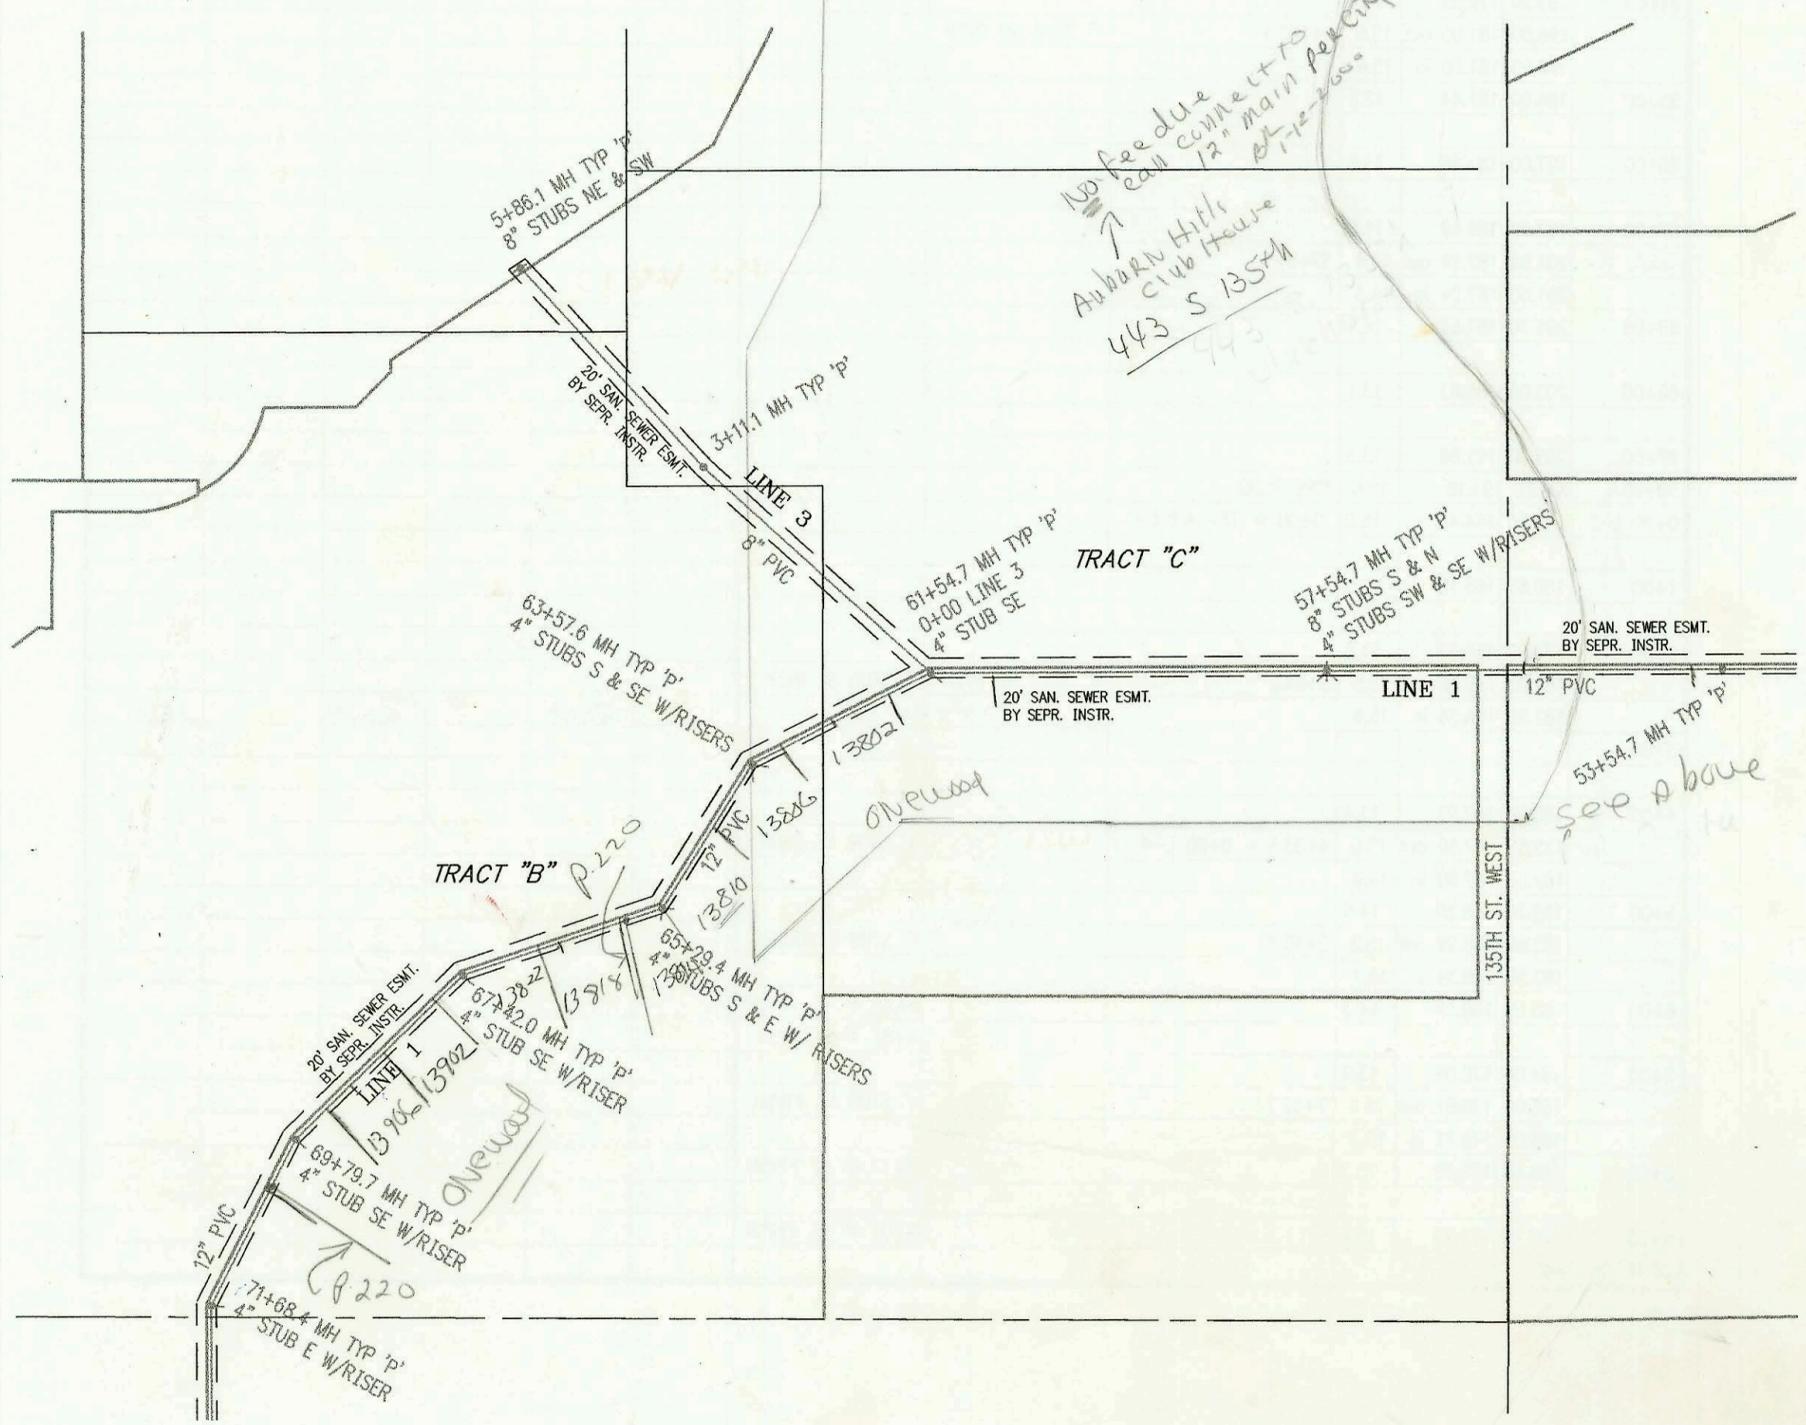

CONSTRUCTION RECORD						SERVICE RECORD						
STATION	ELEVATION		DEPTH	MANHOLE	4-INCH "Y" BRANCHES		No. of Permit		House Number		DATE OF PERMITS	
	GROUND	GRADE			North West	South East	North West	South East	North West	South East	North West	South East
MAIN 2, CIS	(CONT. FROM P-37)											
42+00	151.70	136.70	15.0		42+80 4" NE 11V5H		2000-02396		13201 W Hayden		10-30-00	
43+00	152.60	137.00	15.6									
44+00	153.40	137.30	16.1									
	153.40	137.42	16.0	44+39.8	8" STUB NE 137.85							
	153.40	137.52	15.9		4" STUB N 13V7H	4" STUB E 13V7H	2001-02817	2002-01657	13209 W Hayden	13205 W Hayden	4-9-01	6-14-02
45+00	153.00	138.48	14.5									
					45+60 4" NE 12V5H		2001-03156		13213 W Hayden		12-12-01	
46+00	153.50	140.06	13.4									
					46+50 4" NE 11V5H		2002-02682		13393 W Hayden		10-14-03	
47+00	153.80	141.65	12.2									
					47+40 4" NE 9V5H		2002-01960		13307 W HAYDEN		7-17-02	
48+00	154.20	143.24	11.0									
	153.80	143.53 out	10.3	48+18.3	8" STUB N 143.96							
	153.80	143.63 in	10.2		4" STUB NE 13V5H							
49+00	156.00	143.79	12.2									
50+00	156.10	143.99	12.1									
51+00	156.40	144.19	12.2									
	157.00	144.39 out	12.6	51+98.6								
	157.00	144.49 in	12.5									
52+00												
					52+36.6 4" S 11V5H →							
53+00	159.50	144.69	14.8		52+98.6 4" S 10V5H →							
	160.00	144.80	15.2	53+54.7								
54+00	160.00	144.89	15.1		53+96.6 4" S 10V5H		2005-02296		13413 W Links		6-16-05	
55+00	161.30	145.09	16.2									
56+00	162.30	145.29	17.0									
57+00	163.00	145.49	17.5									
	163.50	145.60	17.9	57+54.7	8" STUB N 145.93	8" STUB S 145.93						
					4" STUB SW 14V5H	4" STUB SE 14V5H						
58+00	164.00	145.69	18.3									
					58+81.7	58+67 4" S 14V5H	2005-01275		443 1325TH S HAYDEN		5-24-00	
59+00	164.70	145.89	18.8									
60+00	165.00	146.09	18.9									
61+00	163.50	146.29	17.2									
	165.50	146.40 out	19.1	61+54.7 = L-3								
	165.50	146.50 in	19.0									
62+00	163.60	147.06	16.5									
63+00	163.70	148.31	15.4									
	167.50	149.02 out	18.5	63+57.6								
	167.50	149.12 in	18.4									
64+00	164.80	149.65	15.2									
65+00	168.00	150.89	17.1									
	169.50	151.26 out	18.2	65+29.4								
	169.50	151.36 in	18.1									
66+00	168.30	152.23	16.1									
67+00	169.30	153.48	15.8									
	170.50	154.00 out	16.5	67+42.0								
	170.50	154.10 in	16.4									
68+00	172.00	154.17	17.8									
69+00	173.10	154.57	18.5									
	173.50	154.81 out	18.7	69+79.7								
	173.50	154.91 in	18.6									
70+00	173.40	155.62	17.8									
71+00	174.50	159.11	15.4									
	175.50	161.50 out	14.0	71+68.4								
	175.50	161.60 in	13.9									