


SCALE: 1" = 100'

MAIN 3, WAR INDUSTRIES SEWER
RELOCATION IN FABRIQUE ST.
PROJECT NO. 468-82785 (623314)
BUILT BY H. D. MILLS
BOOKED 12/4/98 PER PLAN

LATERAL 51, MAIN 7, SANITARY SEWER NO. 23
PROJECT NO. 468-82852 (743591)
BUILT BY K. C. EXCAVATING, INC.
BOOKED 12/4/98 PER PLAN

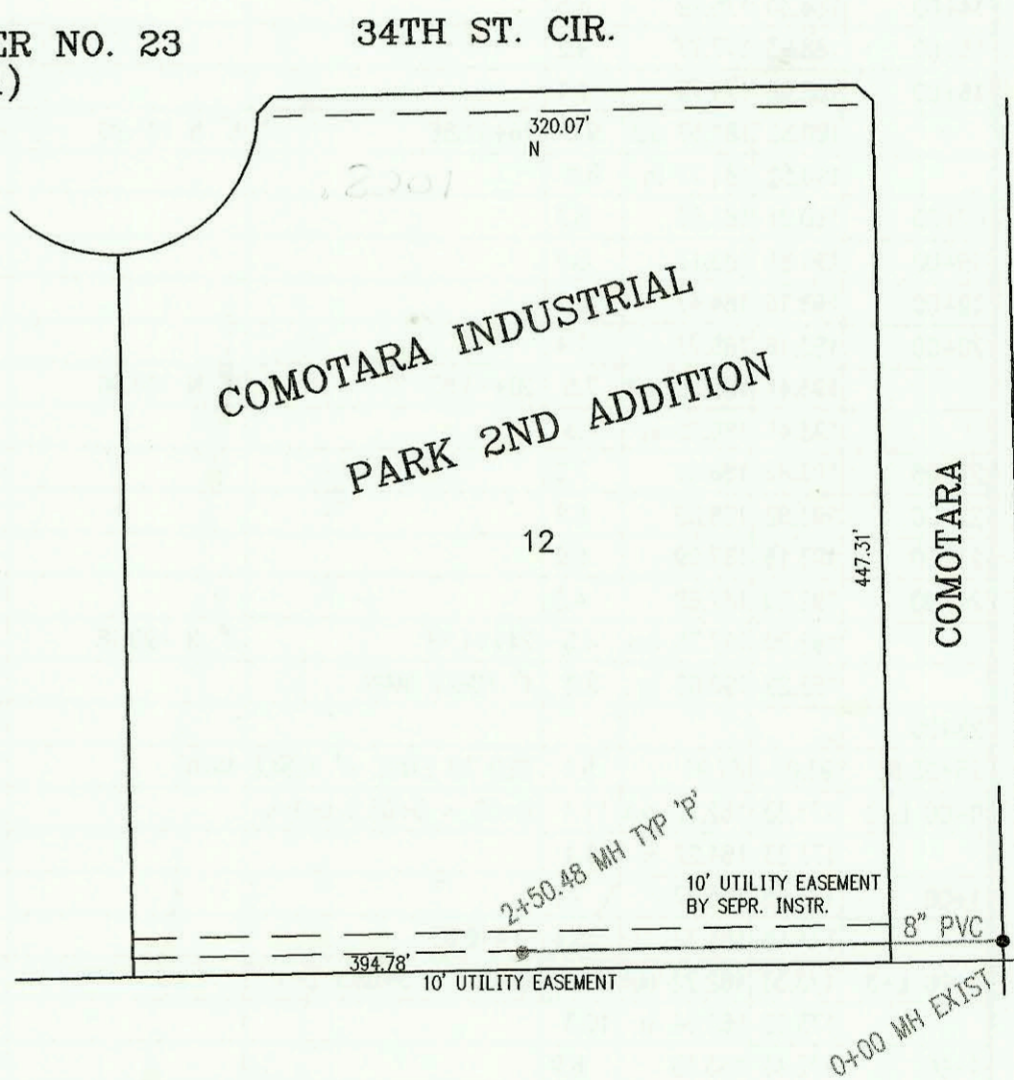

SCALE: 1" = 100'

K-96 HIGHWAY

