


SANITARY SEWER TO SERVE GLENWOOD ADDITION
 PROJECT NO. 782PPS
 BUILT BY W.B. CARTER CONSTRUCTION CO.
 BOOKED 1/25/99 PER AS BUILT PLAN

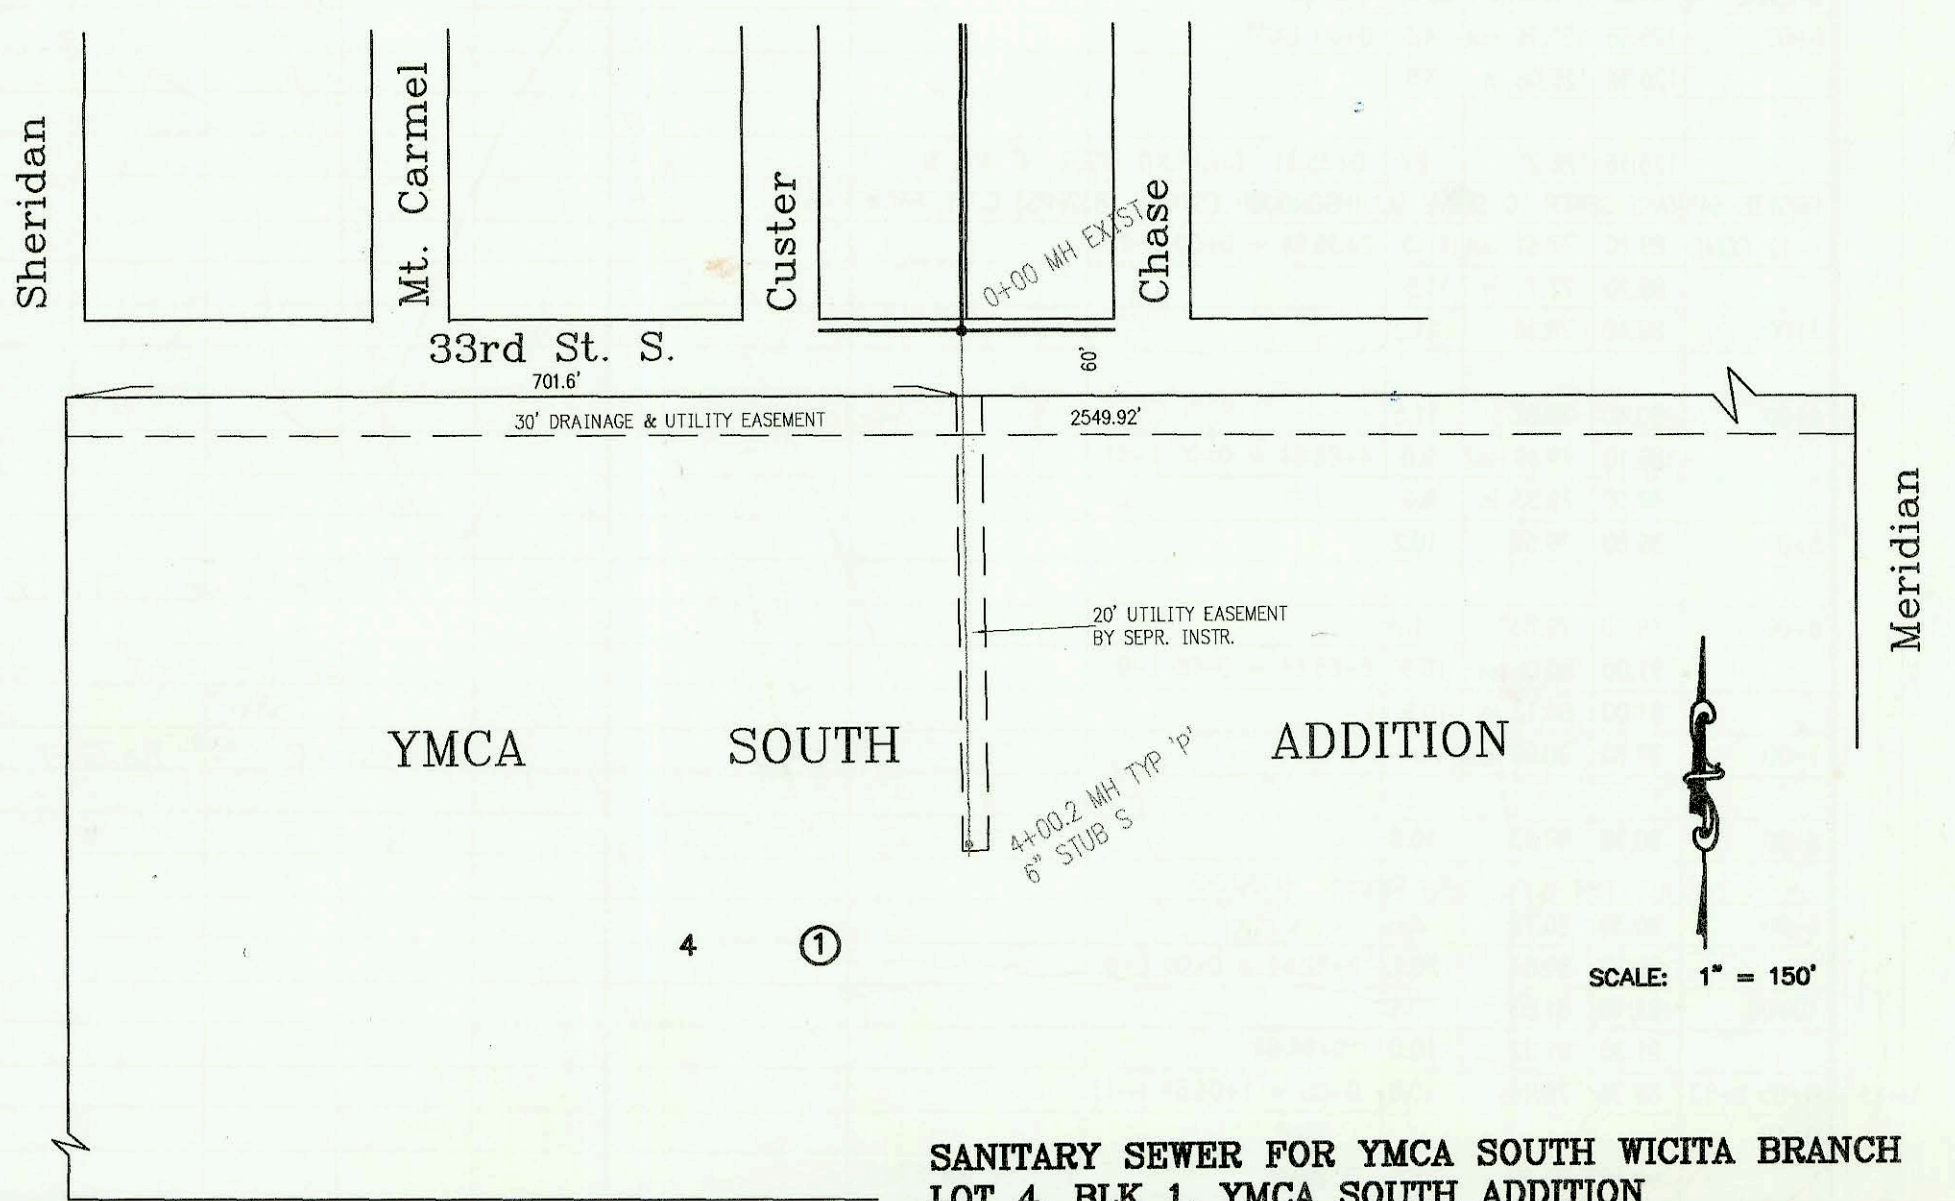

SANITARY SEWER FOR YMCA SOUTH WICITA BRANCH
 LOT 4, BLK 1, YMCA SOUTH ADDITION
 PROJECT NO. 865PPS
 BUILT BY W. B. CARTER CONSTRUCTION CO.
 2/8/99 PER AS BUILT PLAN

