


47TH ST. S.

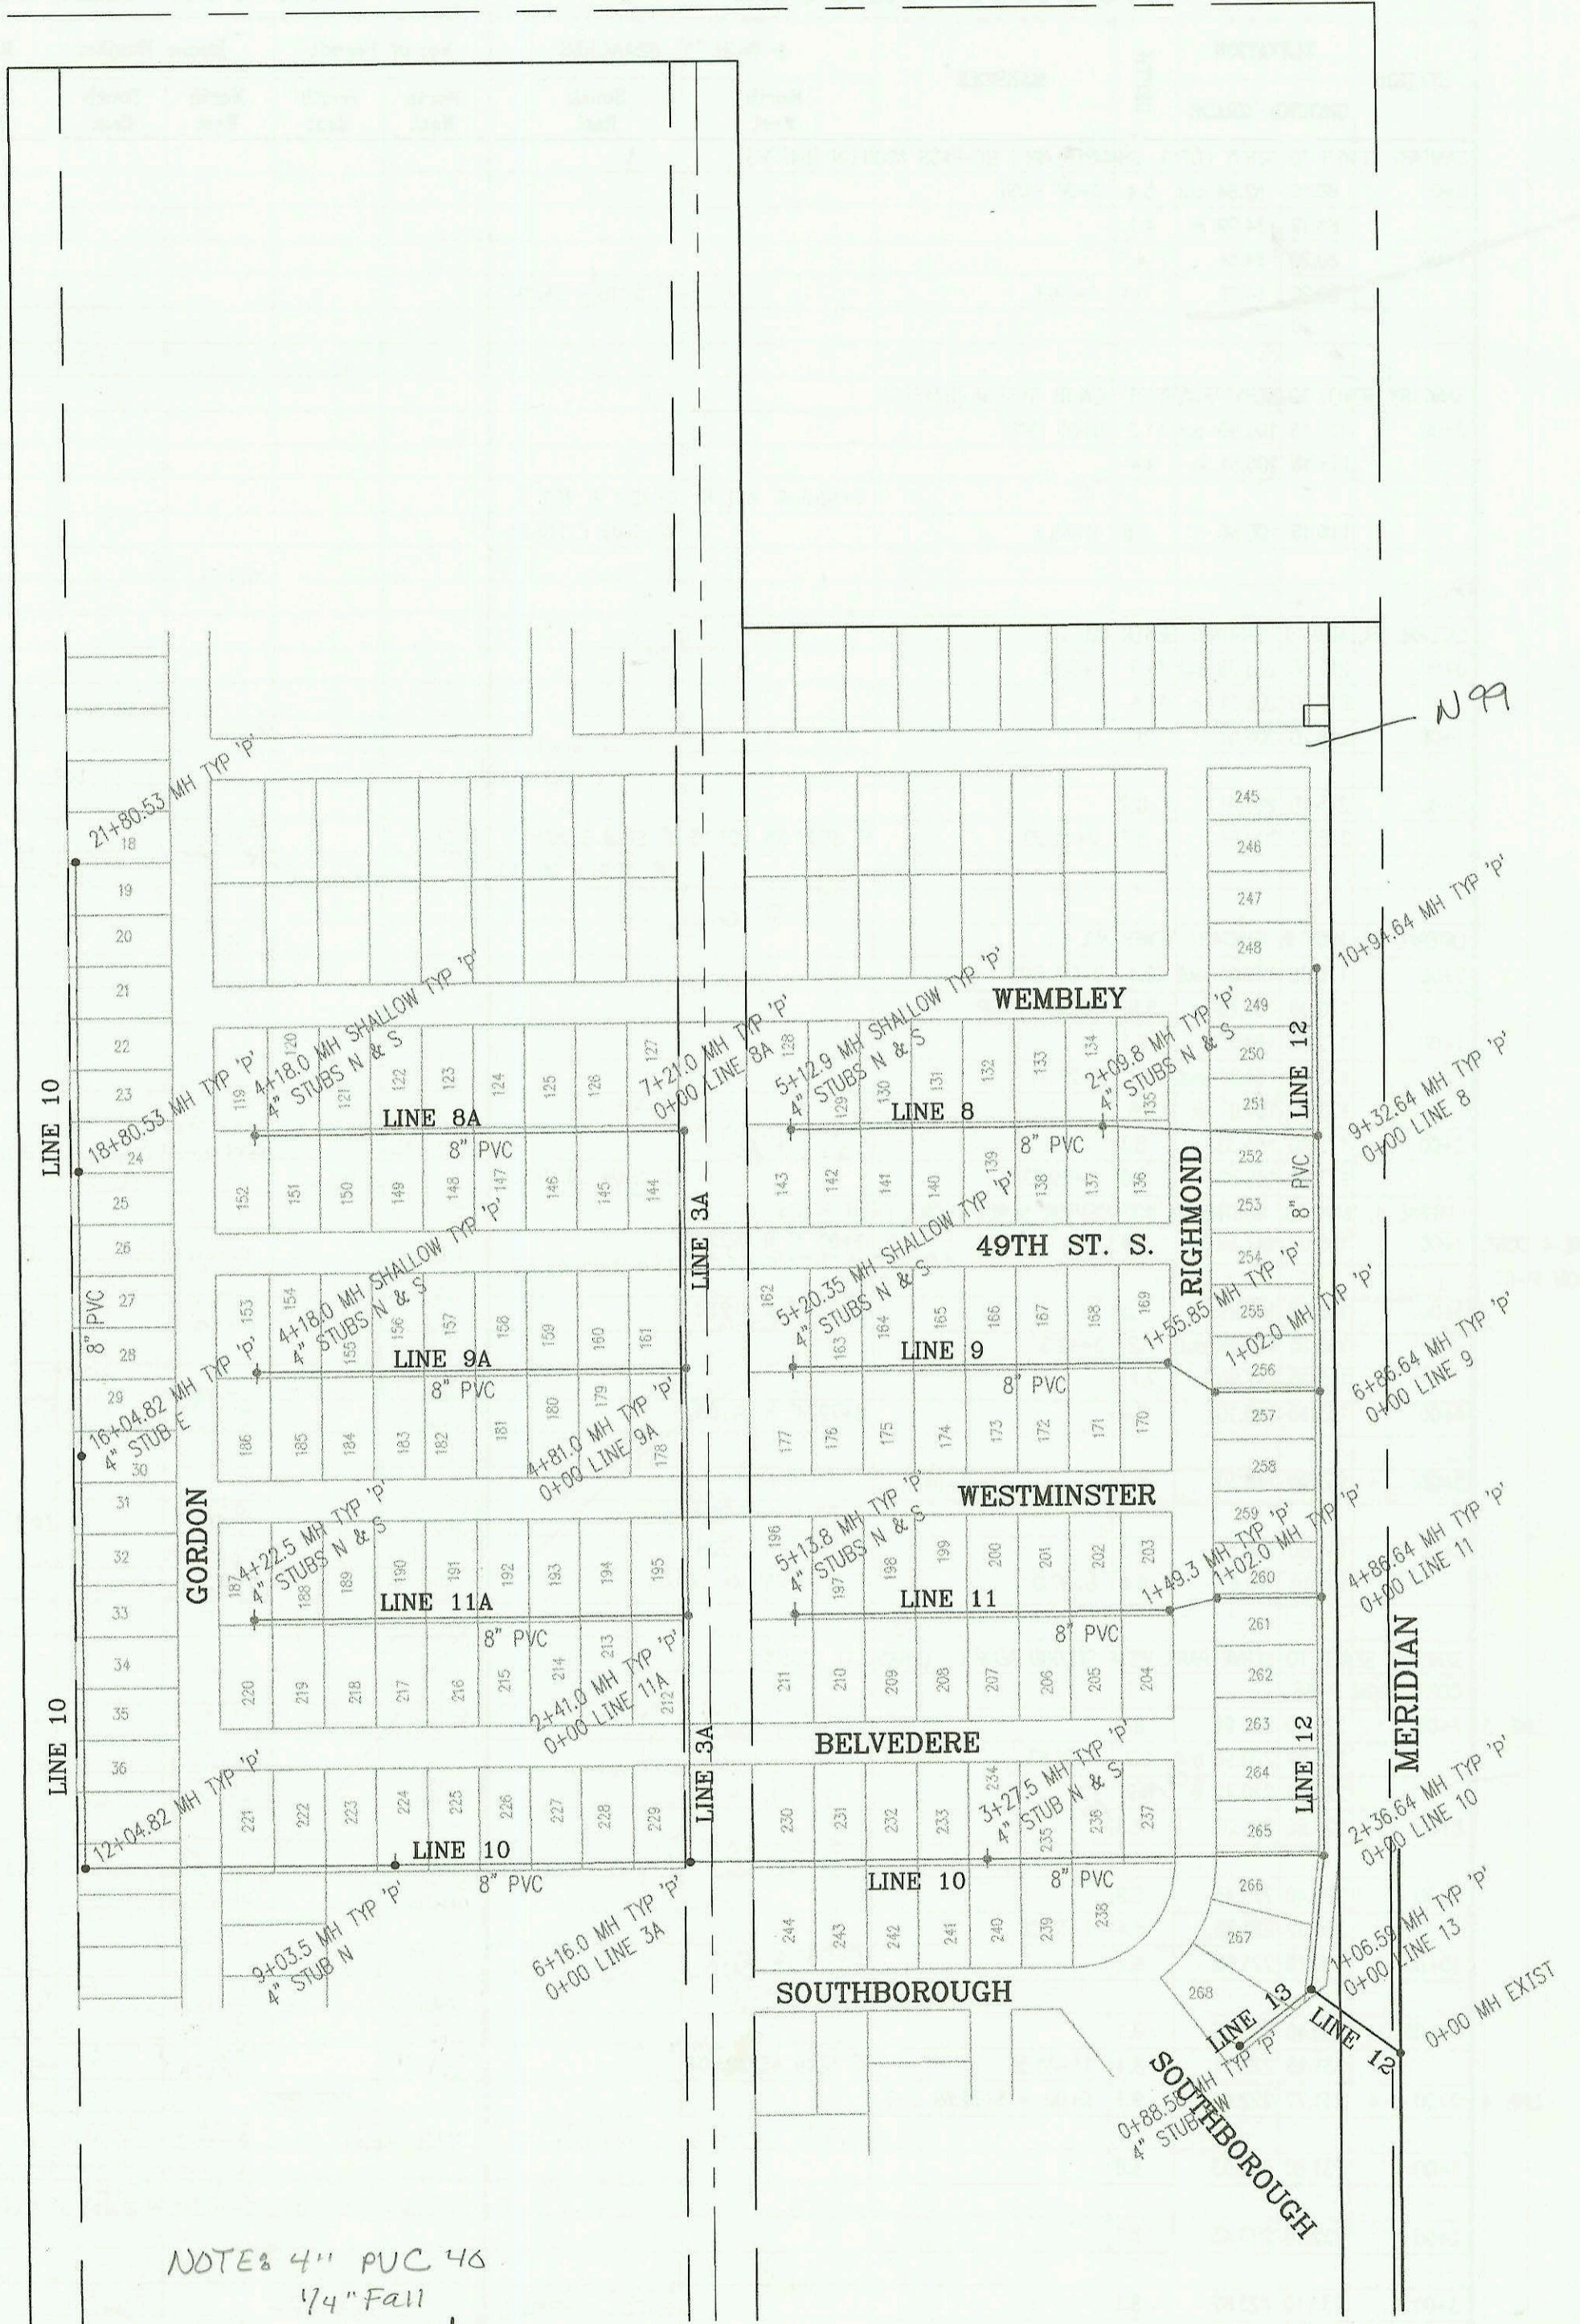

NOTE: 4" PVC 46  
 1/4" Fall  
 Lots 18 thru 268

PRIVATE SANITARY SEWER TO SERVE  
 SOUTHBOROUGH ESTATES  
 PROJECT NO. 832PPS  
 BUILT BY MIES CONSTRUCTION CO.  
 2/25/99 PER AS BUILT PLAN

SCALE: 1" = 150'

48

CONSTRUCTION RECORD						SERVICE RECORD						
STATION	ELEVATION		DEPTH	MANHOLE	4-INCH "Y" BRANCHES		No. of Permit		House Number		DATE OF PERMITS	
	GROUND	GRADE			North West	South East	North West	South East	North West	South East	North West	South East
PRIVATE SANITARY SEWER TO SERVE SOUTHBOROUGH ESTATES (852PPS) CONT. FROM P-64												
L-10 CONT.	88.40	78.69	9.7	3+27.5	4" STUB N 85.40	4" STUB S 85.40						
4+00	87.90	78.91	9.0									
5+00	87.20	79.21	8.0									
6+00	86.80	79.51	7.3									
	87.20	79.56	7.6	6+16.0 = 0+00 L-3A								
7+00	87.30	79.81	7.5									
8+00	87.80	80.11	7.7									
9+00												
	88.80	80.42	8.4	9+03.5	4" STUB N 85.80							
10+00	88.60	80.71	7.9									
11+00	88.10	81.01	7.1									
12+00												
	88.10	81.32 out	6.8	12+04.82								
	88.10	81.42 in	6.7									
13+00	87.60	81.71	5.9									
14+00	87.60	82.01	5.6									
15+00	88.10	82.31	5.8									
16+00												
	88.40	82.62	5.8	16+04.82		4" STUB E 85.10						
17+00	88.00	83.11	4.9									
18+00	87.80	83.21	4.6									
	88.40	83.15	5.3	18+80.53								
19+00	88.30	83.21	5.1									
20+00	88.80	83.51	5.3									
21+00	88.60	83.81	4.8									
	88.60	84.05	4.6	21+80.53								
L-11 0+00 L-11	89.10	79.58	9.5	0+00 = 4+86.64 L-12								
1+00												
	89.60	81.45 out	8.2	1+02.0								
	89.60	81.55 in	8.1									
	89.50	81.74 out	7.8	1+49.3								
	89.50	81.84 in	7.7									
2+00	89.50	82.04	7.5									
3+00	88.80	82.44	6.4									
4+00	88.20	82.84	5.4									
5+00	87.60	83.24	4.4									
	87.80	83.30	4.5	5+13.8	4" STUB N 83.63	4" STUB S 83.63						
L-11A 0+00 L-11A	87.60	81.97	5.6	0+00 = 2+41.0 L-3A								
1+00	88.00	82.50	5.5									
2+00	88.60	83.03	5.6									
3+00	89.10	83.55	5.6									
4+00	88.80	84.08	4.7									
	88.70	84.20	4.5	4+22.5	4" STUB N 84.53	4" STUB S 84.53						
L-12 0+00 L-12	89.10	73.32 out	15.8	0+00 EXIST								
	89.10	76.72 in	12.4									
1+00												
	89.70	77.04 out	12.7	1+06.59 = 0+00 L-13								
	89.70	77.14 in	12.6									
1+16.59				TRAP								
2+00	91.00	77.42	13.6									

*Installed*  
 2/23/99  
 LOT #S 18 to 36  
 TRAP INSTALLED AT MAIN  
 Permit 99-3063-7  
 Lot #S 221 to 244

*installed 2/23/99*  
 Lot #S 196 to 211  
 Permit #99-3065-7

*installed 2/23/99*  
 Lot #S 187 to 195  
 and  
 Lot #S 212 to 220  
 Permit 99-3066-7