


47TH ST. S.

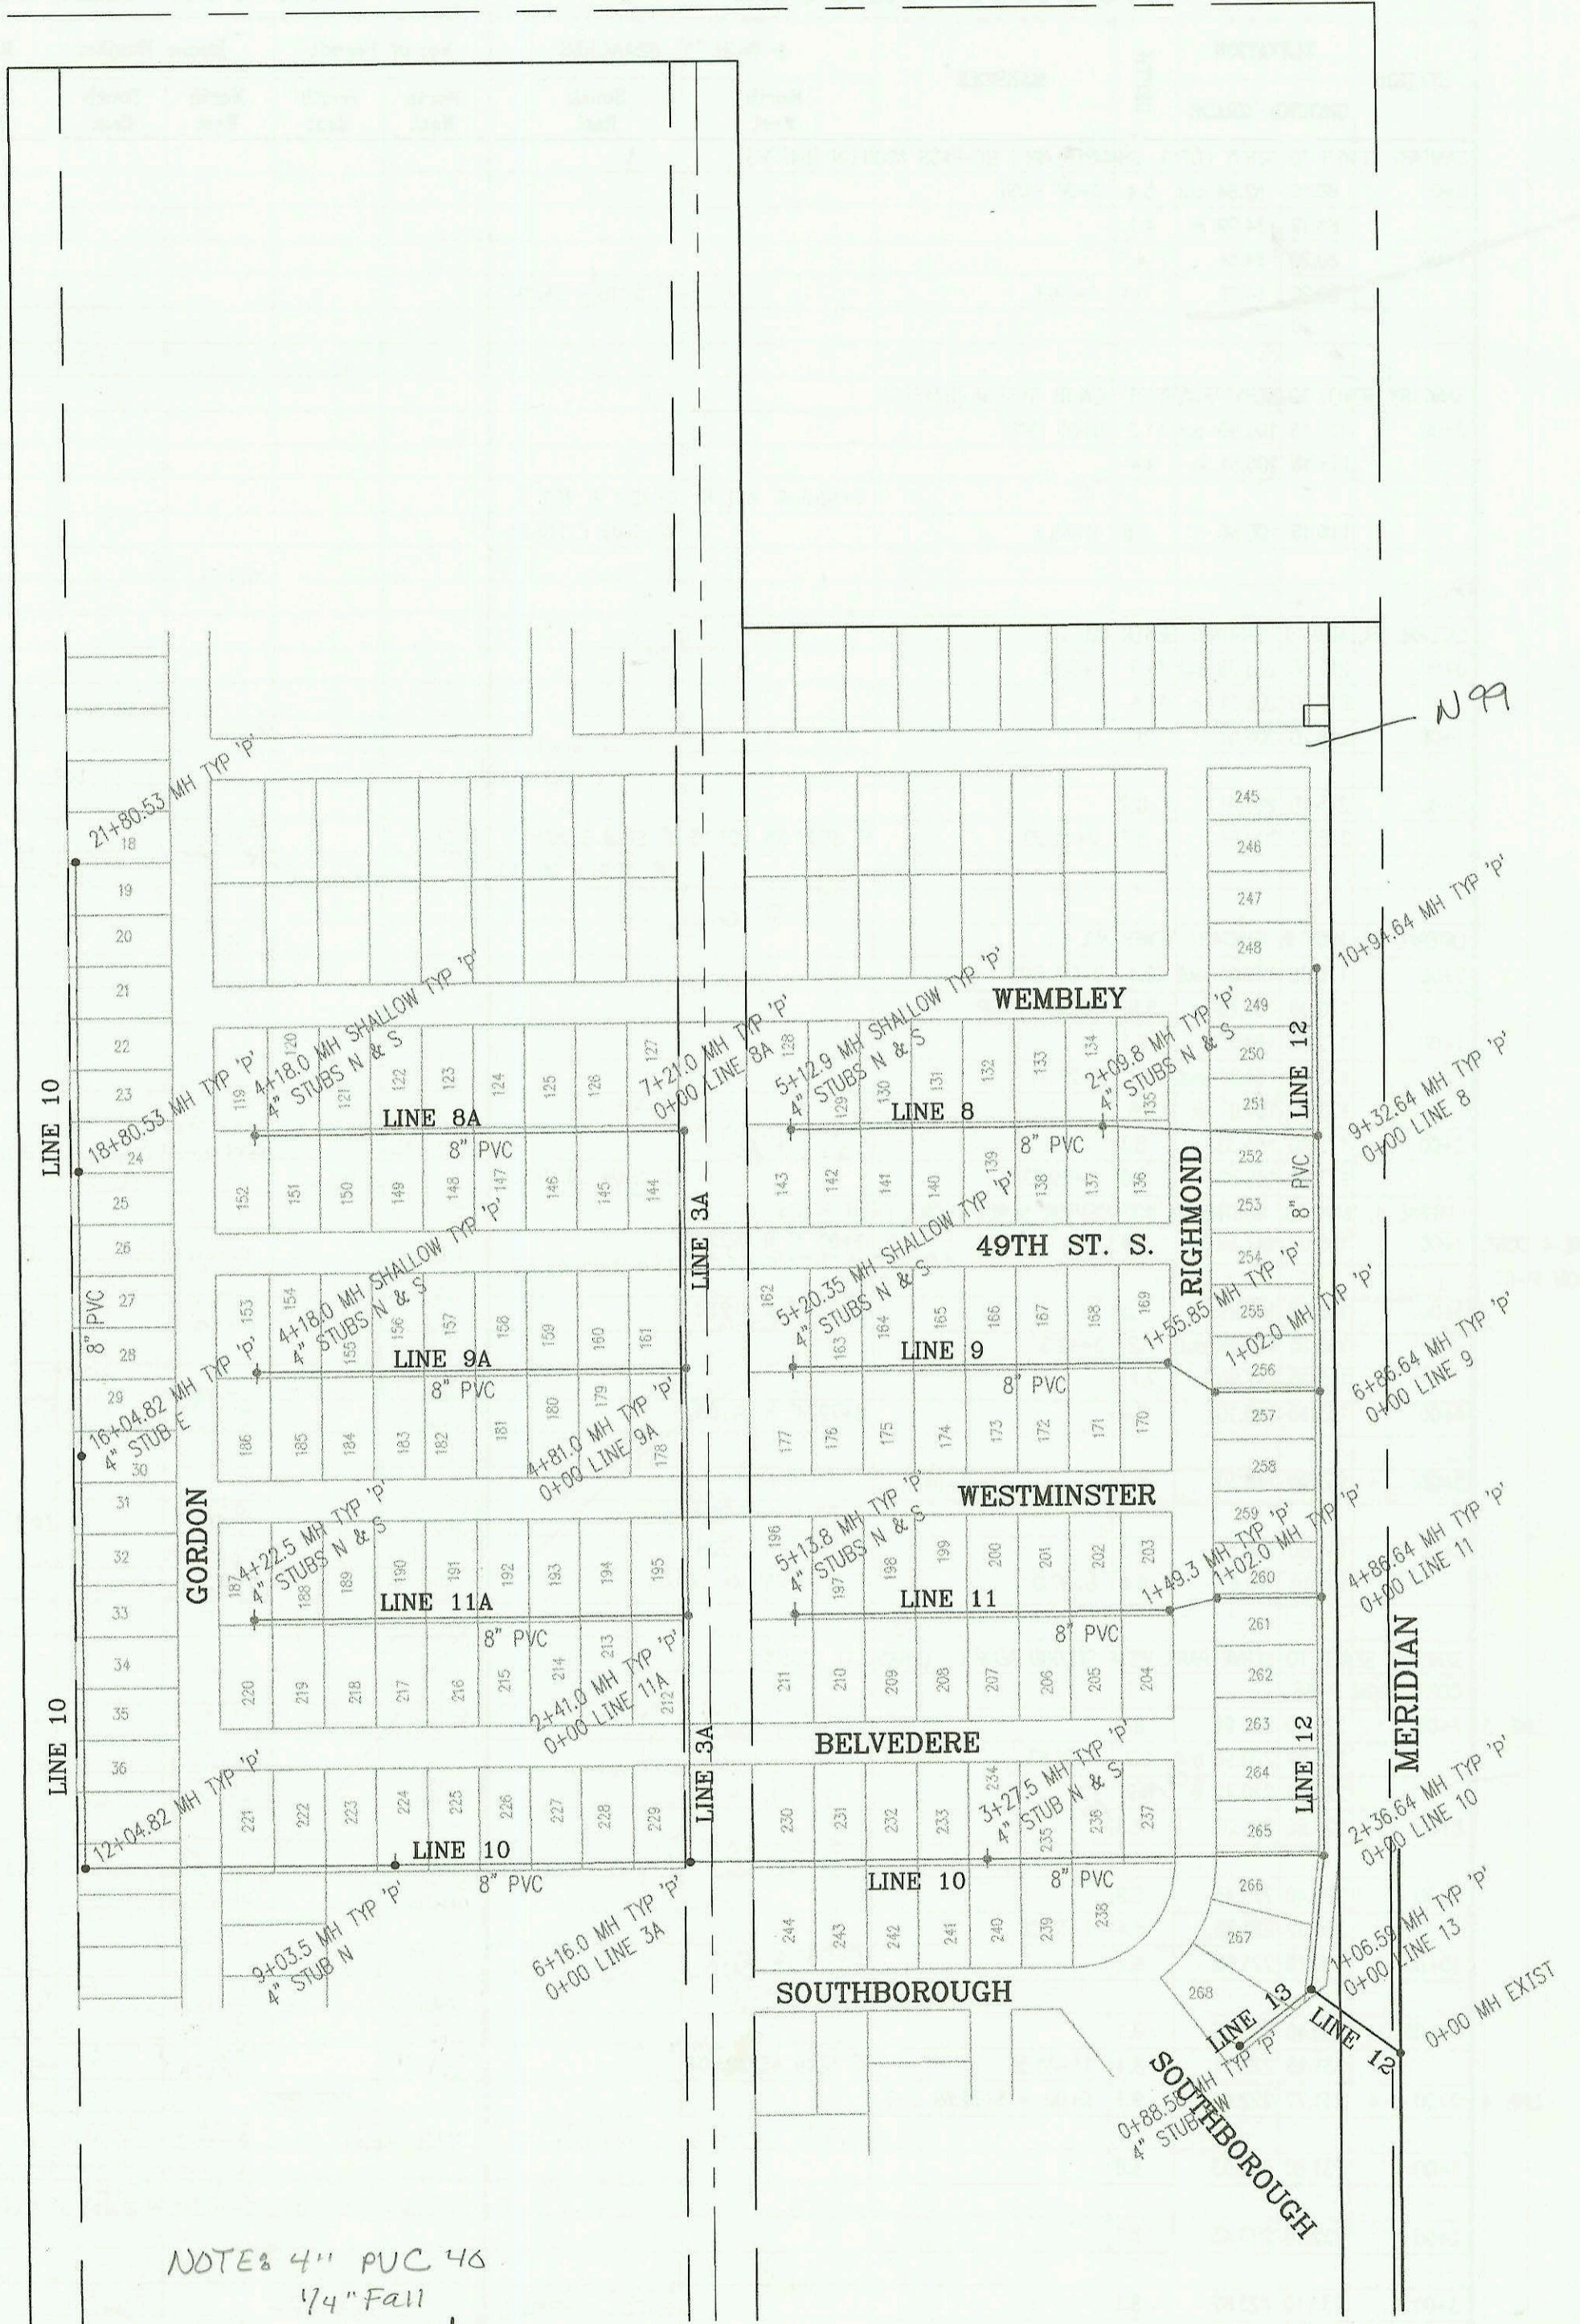

NOTE: 4" PVC 46  
 1/4" Fall  
 Lots 18 thru 268

PRIVATE SANITARY SEWER TO SERVE  
 SOUTHBOROUGH ESTATES  
 PROJECT NO. 832PPS  
 BUILT BY MIES CONSTRUCTION CO.  
 2/25/99 PER AS BUILT PLAN

SCALE: 1" = 150'

48

CONSTRUCTION RECORD						SERVICE RECORD						
STATION	ELEVATION		DEPTH	MANHOLE	4-INCH "Y" BRANCHES		No. of Permit		House Number		DATE OF PERMITS	
	GROUND	GRADE			North West	South East	North West	South East	North West	South East	North West	South East
PRIVATE SANITARY SEWER TO SERVE SOUTHBOROUGH ESTATES (832PPS)												
L-3A	0+00 L-3A	87.20	79.66	7.5	0+00 L-3A = 6+16.0 L-10							
	1+00	88.10	80.58	7.5								
	2+00	87.90	81.49	6.4								
		87.70	81.87	5.8	2+41.0 = 0+00 L-11A							
	3+00	88.10	82.05	6.1								
	4+00	88.80	82.35	6.4								
		88.30	82.59	5.7	4+81.0 = 0+00 L-9A							
	5+00	88.30	82.65	5.6								
	6+00	89.10	82.95	6.2								
	7+00	88.70	83.25	5.4								
		88.80	83.31	5.5	7+21.0 = 0+00 L-8A							
L-8	0+00 L-8	90.90	80.93	10.0	0+00 = 9+32.64 L-12							
	1+00	90.80	82.01	8.8								
	2+00	90.60	84.08	6.5								
		90.80	83.19	7.6	2+09.8	4" STUB N 83.52	4" STUB S 83.52					
	3+00	90.00	83.55	6.5								
	4+00	89.40	83.95	5.5								
	5+00	88.80	84.35	4.4								
		88.90	84.40	4.5	5+12.9	4" STUB N 84.73	4" STUB S 84.73					
L-8A	0+00 L-8A	88.80	83.41	5.4	0+00 = 7+21.0 L-3A							
	1+00	89.10	83.81	5.3								
	2+00	89.60	84.21	5.4								
	3+00	90.20	84.61	5.6								
	4+00	89.60	85.01	4.6								
		89.60	85.08	4.5	4+18.0	4" STUB N 85.41	4" STUB S 85.41					
L-9	0+00 L-9	91.00	80.27	10.7	0+00 = 6+86.64 L-12							
	1+00											
		90.30	81.92 out	8.4	1+02.0							
		90.30	82.02 in	8.3								
		90.30	82.24 out	8.1	1+55.85							
		90.30	82.34 in	8.0								
	2+00	89.90	82.51	7.4								
	3+00	89.20	82.91	6.3								
	4+00	88.60	83.31	5.3								
	5+00	88.10	83.71	4.4								
		88.30	83.79	4.5	5+20.35	4" STUB N 85.30	4" STUB S 85.30					
L-9A	0+00 L-9A	88.10	82.69	5.4	0+00 = 4+81.0 L-3A							
	1+00	88.60	83.15	5.4								
	2+00	89.10	83.60	5.5								
	3+00	89.10	84.06	5.0								
	4+00	89.00	84.52	4.5								
		89.10	84.60	4.5	4+18.0	4" STUB N 84.93	4" STUB S 84.93					
L-10	0+00 L-10	89.10	77.71	11.4	0+00 = 2+36.64 L-12							
	1+00	89.20	78.01	11.2								
	2+00	89.10	78.31	10.8								
	3+00	88.60	78.61	10.0								

Installed 2-23-99  
 Lots 102 to 112  
 Permit # 99-3073-7

Installed 2/23/00  
 Lot #s 128 to 143  
 Permit # 99-3069-7

Installed 2/23/00  
 Lot #s 119 to 127 and  
 Lot #s 144 to 152  
 Permit # 99-3071-7

Installed 2/23/99  
 Lots 162 to 177  
 Permit # 99-3067-7

Installed 2/23/99  
 Lot #s 153 to 161 and  
 Lot #s 178 to 186  
 Permit # 99-3068-7

Installed 2/23/00  
 99-3063-7 and  
 99-3064-7