



**SANITARY SEWER TO SERVE BURGER KING
AT 47TH ST. S. & BROADWAY
PROJECT NO. 891PPS
BUILT BY McCULLOUGH EXCAVATION
BOOKED 4/1/99 PER AS BUILT PLAN**

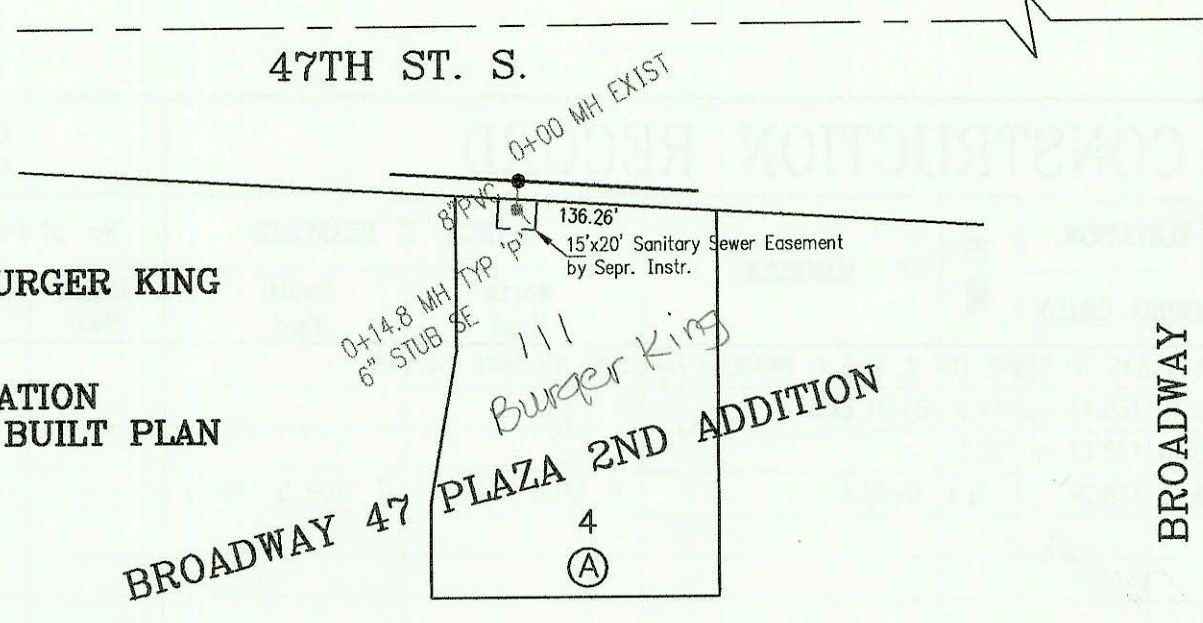


SCALE: 1" = 100'

**SANITARY SEWER TO SERVE LOT 1, BLK 1,
COMOTARA POWER CENTER 2ND ADDITION
PROJECT NO. 885PPS
BUILT BY McCULLOUGH EXCAVATION
BOOKED 4/5/99 PER AS BUILT PLAN**

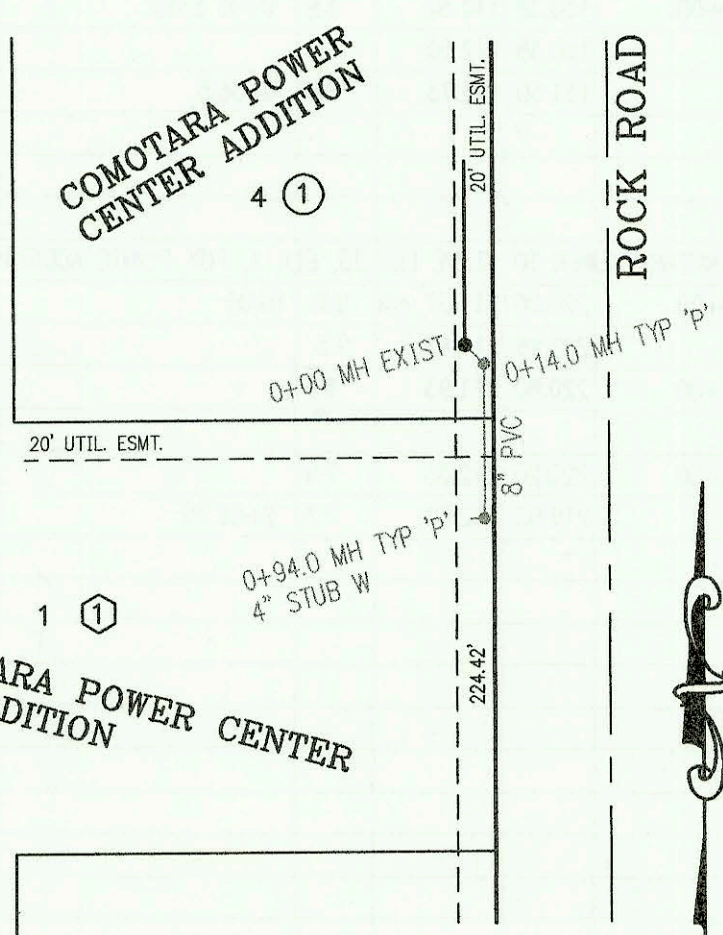


SCALE: 1" = 100'

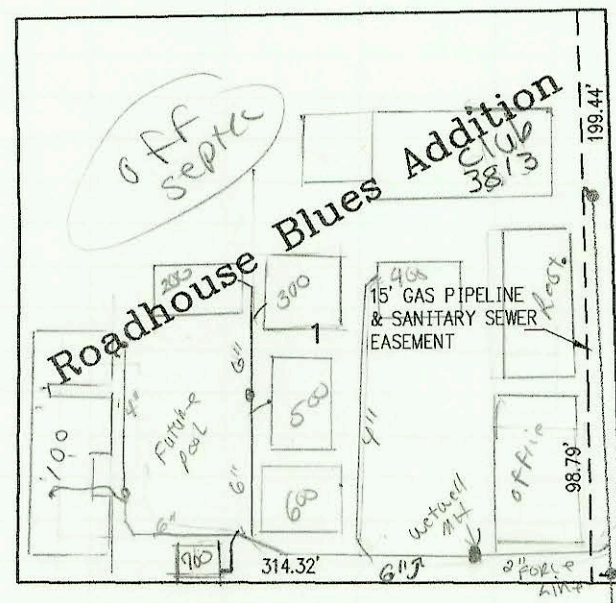

SCALE: 1" = 100'


NOTE 2" Pipe Line, wet well MH, 6" TRUNK line is private line to serve Bldg 100, 200, 300, 400, 500, 600 & 700. Each Bldg to have 4" conn to TRUNK line. BR 6/27/00

**SANITARY SEWER TO SERVE LOT 1,
ROADHOUSE BLUES ADDITION
PROJECT NO. 886PPS
MIES CONSTRUCTION INC.
BOOKED 4/9/99 PER AS BUILT PLAN**

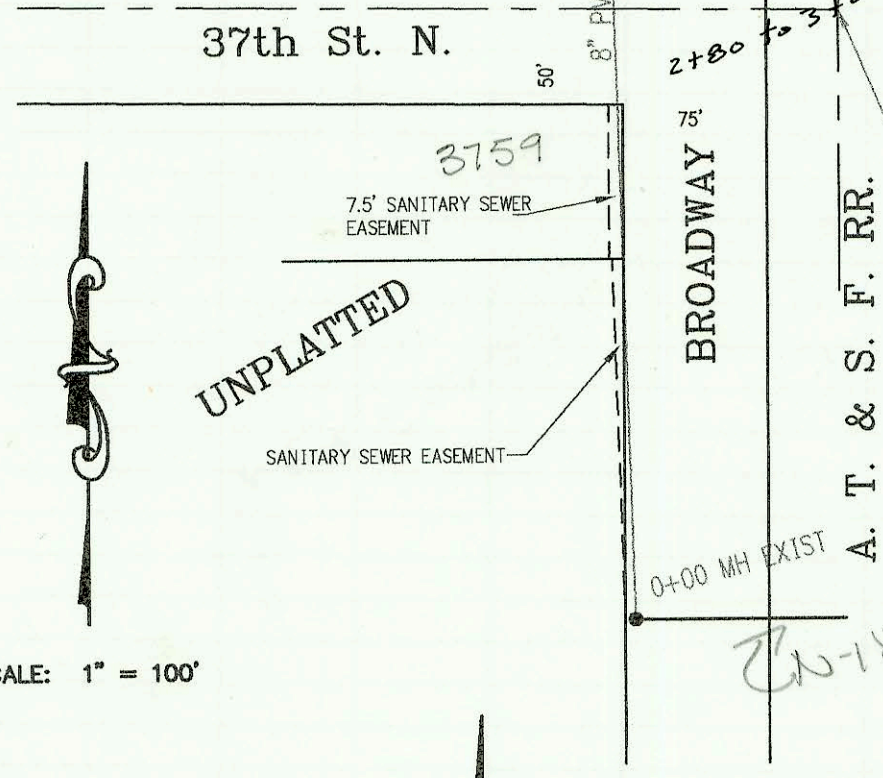

SCALE: 1" = 100'

**SANITARY SEWER TO SERVE LOT 3
WEST KELLOGG POWER CENTER ADDITION
PROJECT NO. 883PPS
BUILT BY MIES CONSTRUCTION
BOOKED 4/9/99 PER AS BUILT PLAN**

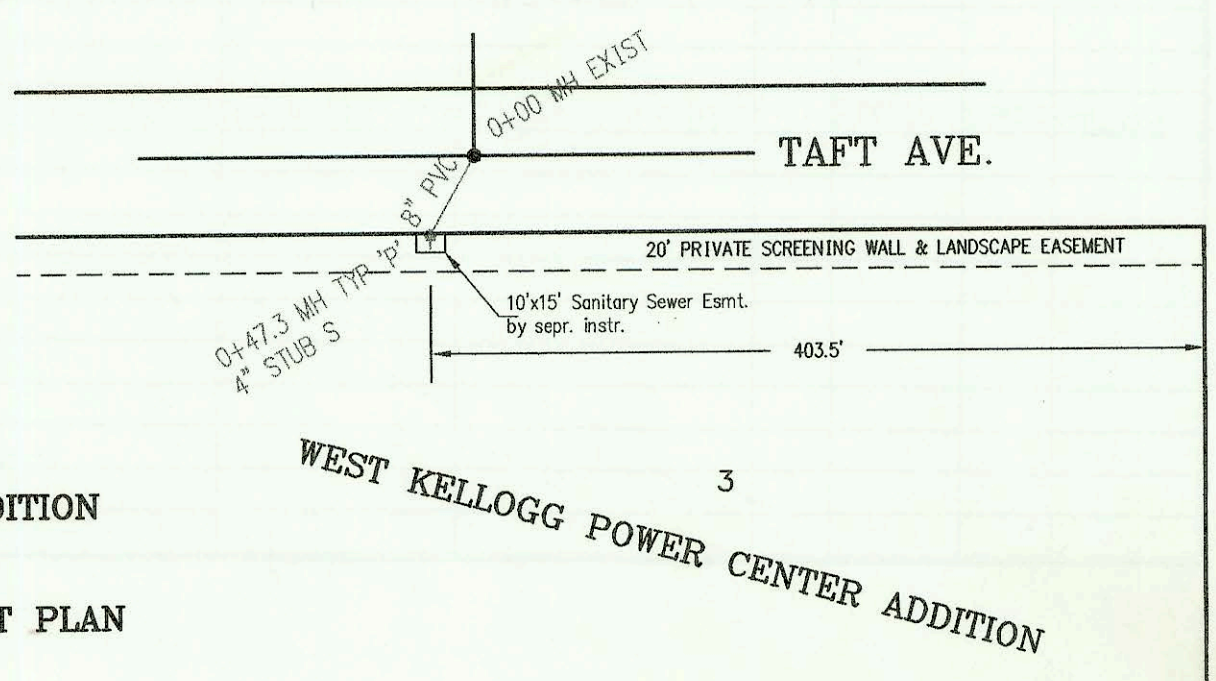

HOOVER

CONSTRUCTION RECORD						SERVICE RECORD						
STATION	ELEVATION		DEPTH	MANHOLE	4-INCH "Y" BRANCHES		No. of Permit		House Number		DATE OF PERMITS	
	GROUND	GRADE			North West	South East	North West	South East	North West	South East	North West	South East
SANITARY SEWER TO SERVE BURGER KING AT 47TH ST. S. AND BROADWAY												
0+00	86.83	72.68 out	14.2	0+00 EXIST								
	86.83	74.58 in	12.3									
	87.60	75.22	12.4	0+14.8	6" STUB SE 76.58		99-03150-7		111 W 47th ST S	* see below		2-25-99
SANITARY SEWER TO SERVE LOT 1, BLK 1, COMOTARA POWER CENTER 2ND ADDITON												
0+00	99.40	88.76 out	10.6	0+00 EXIST								
	99.40	88.86 in	10.5									
	100.90	89.00 out	11.9	0+14.0								
	100.90	89.10 in	11.8									
	100.42	89.40	11.0	0+94.0	4" STUB W 89.73							
SANITARY SEWER TO SERVE LOT 1, ROADHOUSE BLUES ADDITION												
0+00	132.05	126.00 out	6.1	0+00 EXIST								
	132.05	126.10 in	6.0									
1+00	133.00	127.06	5.9									
2+00	133.80	128.02	5.8									
3+00	134.70	128.98	5.7		2" Fireline 3+47.7		2000-0513		3801 Broadway	see below		6-27-00
	135.20	129.53	5.7	3+57.7	8" STUB W 129.63							
4+00	135.00	129.70	5.3				2002-03017		3801 (Office) Broadway			11-7-02
5+00	135.00	130.13	4.9		4" SCH W PVC		98-21749-70		3813 Broadway (Club)			2/26/99
	135.00	130.32	4.7	5+54.39	4" STUB N 130.65							
SANITARY SEWER TO SERVE LOT 3, WEST KELLOGG POWER CENTER ADDITION												
0+00	117.30	103.63 out	13.7	0+00 EXIST								
	117.30	106.10 in	11.2									
	116.44	106.59	9.9	0+47.3	4" STUB S 108.23							
<p>2000-01519-3/9/00-Mies Const-Bldg#700-4" SCH40-Connects to 6" Private main-1TWAIN CO, 2H45</p> <p>2000-01518-3/9/00-Mies Const-Bldg#600-4" SCH40-Connects to 6x4 WYE to private main-1H45, 1TWAIN CO</p> <p>2000-01517-3/9/00-Mies Const-Bldg#500-4" SCH40-Connects to 6x4 WYE-1TWAIN CO</p> <p>2000-01516-3/9/00-Mies Const-Bldg#400-4" SCH40-Connects to 6x4 WYE to Private Main-1H45, 2TWAIN CO</p> <p>2000-01515-3/9/00-Mies Const-Bldg#300-4" SCH40 connects to 6x4 WYE-1TWAIN CO,</p> <p>2000-01514-3/9/00-Mies Const-Bldg#200-4" SCH40 CONNECTS TO 6x4x4 WYE-1TWAIN CO, 1H45</p> <p>2000-01520-3/9/00-Mies Const-Bldg#100-4" SCH40 connects to 6x4x4 WYE-1TWAIN CO, 2H45</p> <p>2000-01521-3/9/00-Mies Const-Bldg#100-4" SCH40 connects to 6x4x4 WYE-1TWAIN CO, 1H45</p> <p>2000-01513-6/27/00-Mies Const-2" SCH40 from MH on Priv. Prop. Tap 10' N of MH - PVC Saddle - 1H45 - wet well MH & priv 6" SCH40 line to serve Bldgs 100-700.</p> <p>* 99-03150-7- 111 W 47th ST. S. (Burger King) Singletary PCB-Grease Intceptor Installab</p>												

3801 N Broadway - 6" Private Line - taps to Private wet well MH & discharges thru 2" PM to City main