


21ST ST.


SANITARY SEWER & SWS EXTENSION FOR  
LOT 2, BLK 1, BRADLEY FAIR 3RD ADDITION  
PROJECT NO. 812PPS  
BUILT BY MIES CONSTRUCTION CO.  
BOOKED 4/12/99 PER AS BUILT PLAN

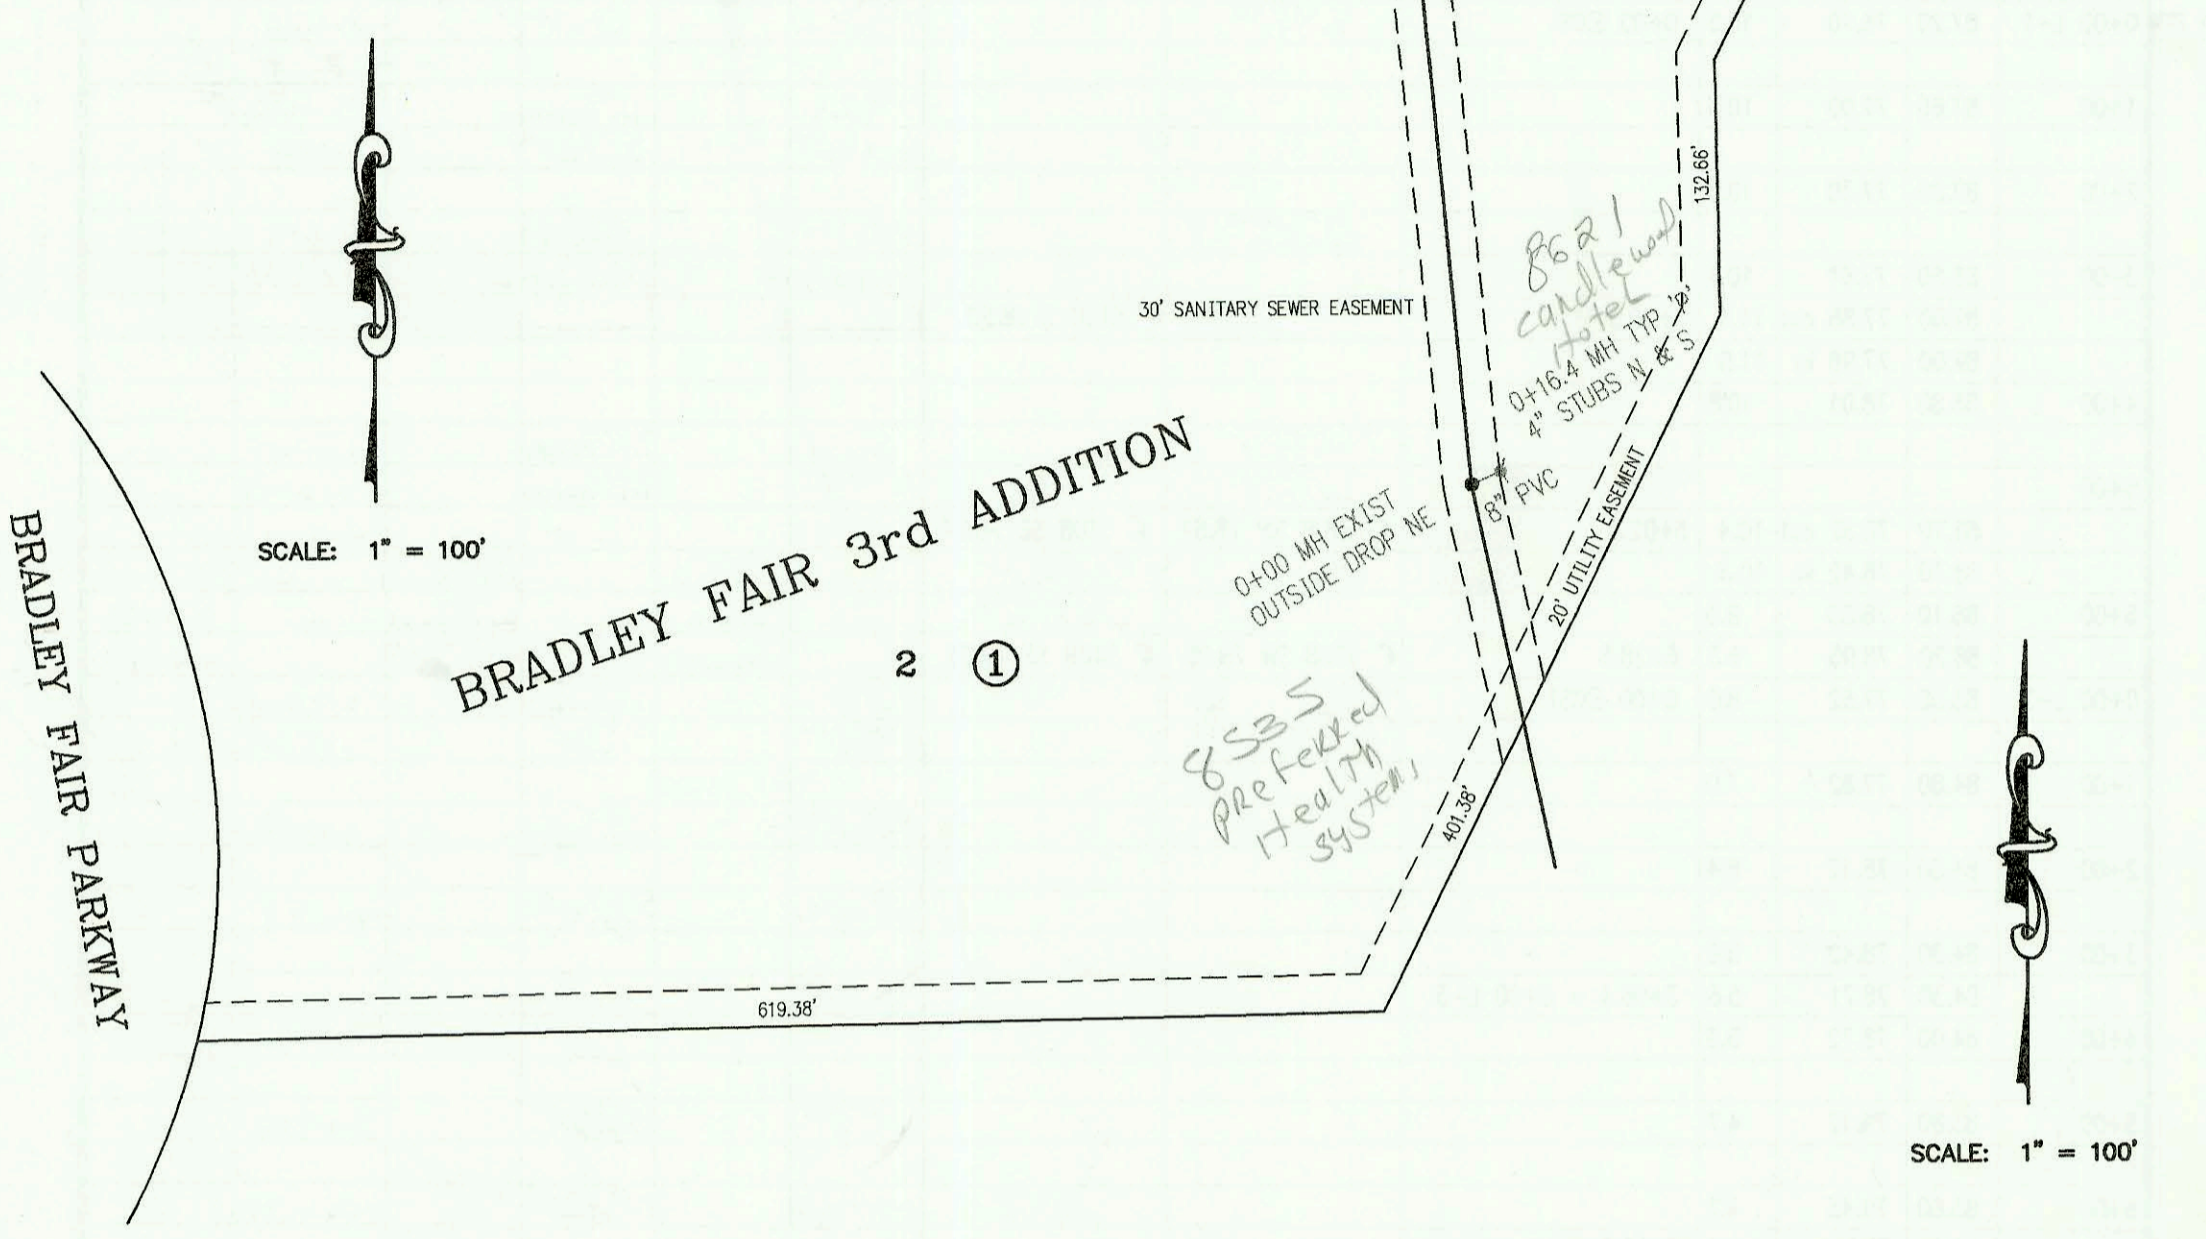

SANITARY SEWER TO SERVE LOT 1,  
ROCKWOOD SOUTH 3RD ADDITION  
PROJECT NO. 873PPS  
BUILT BY McCULLOUGH EXCAVATION INC.  
BOOKED 4/12/99 PER AS BUILT PLAN

*Permissible to tie sewer for 359 into sewer line for 353 ready 8/12/03*

SANITARY SEWER TO SERVE  
LOT 23, BLK 1, FOX POINTE ADDITION  
PROJECT NO. 863PPS  
BUILT BY MIES CONSTRUCTION CO.  
BOOKED 4/12/99 PER AS BUILT PLAN

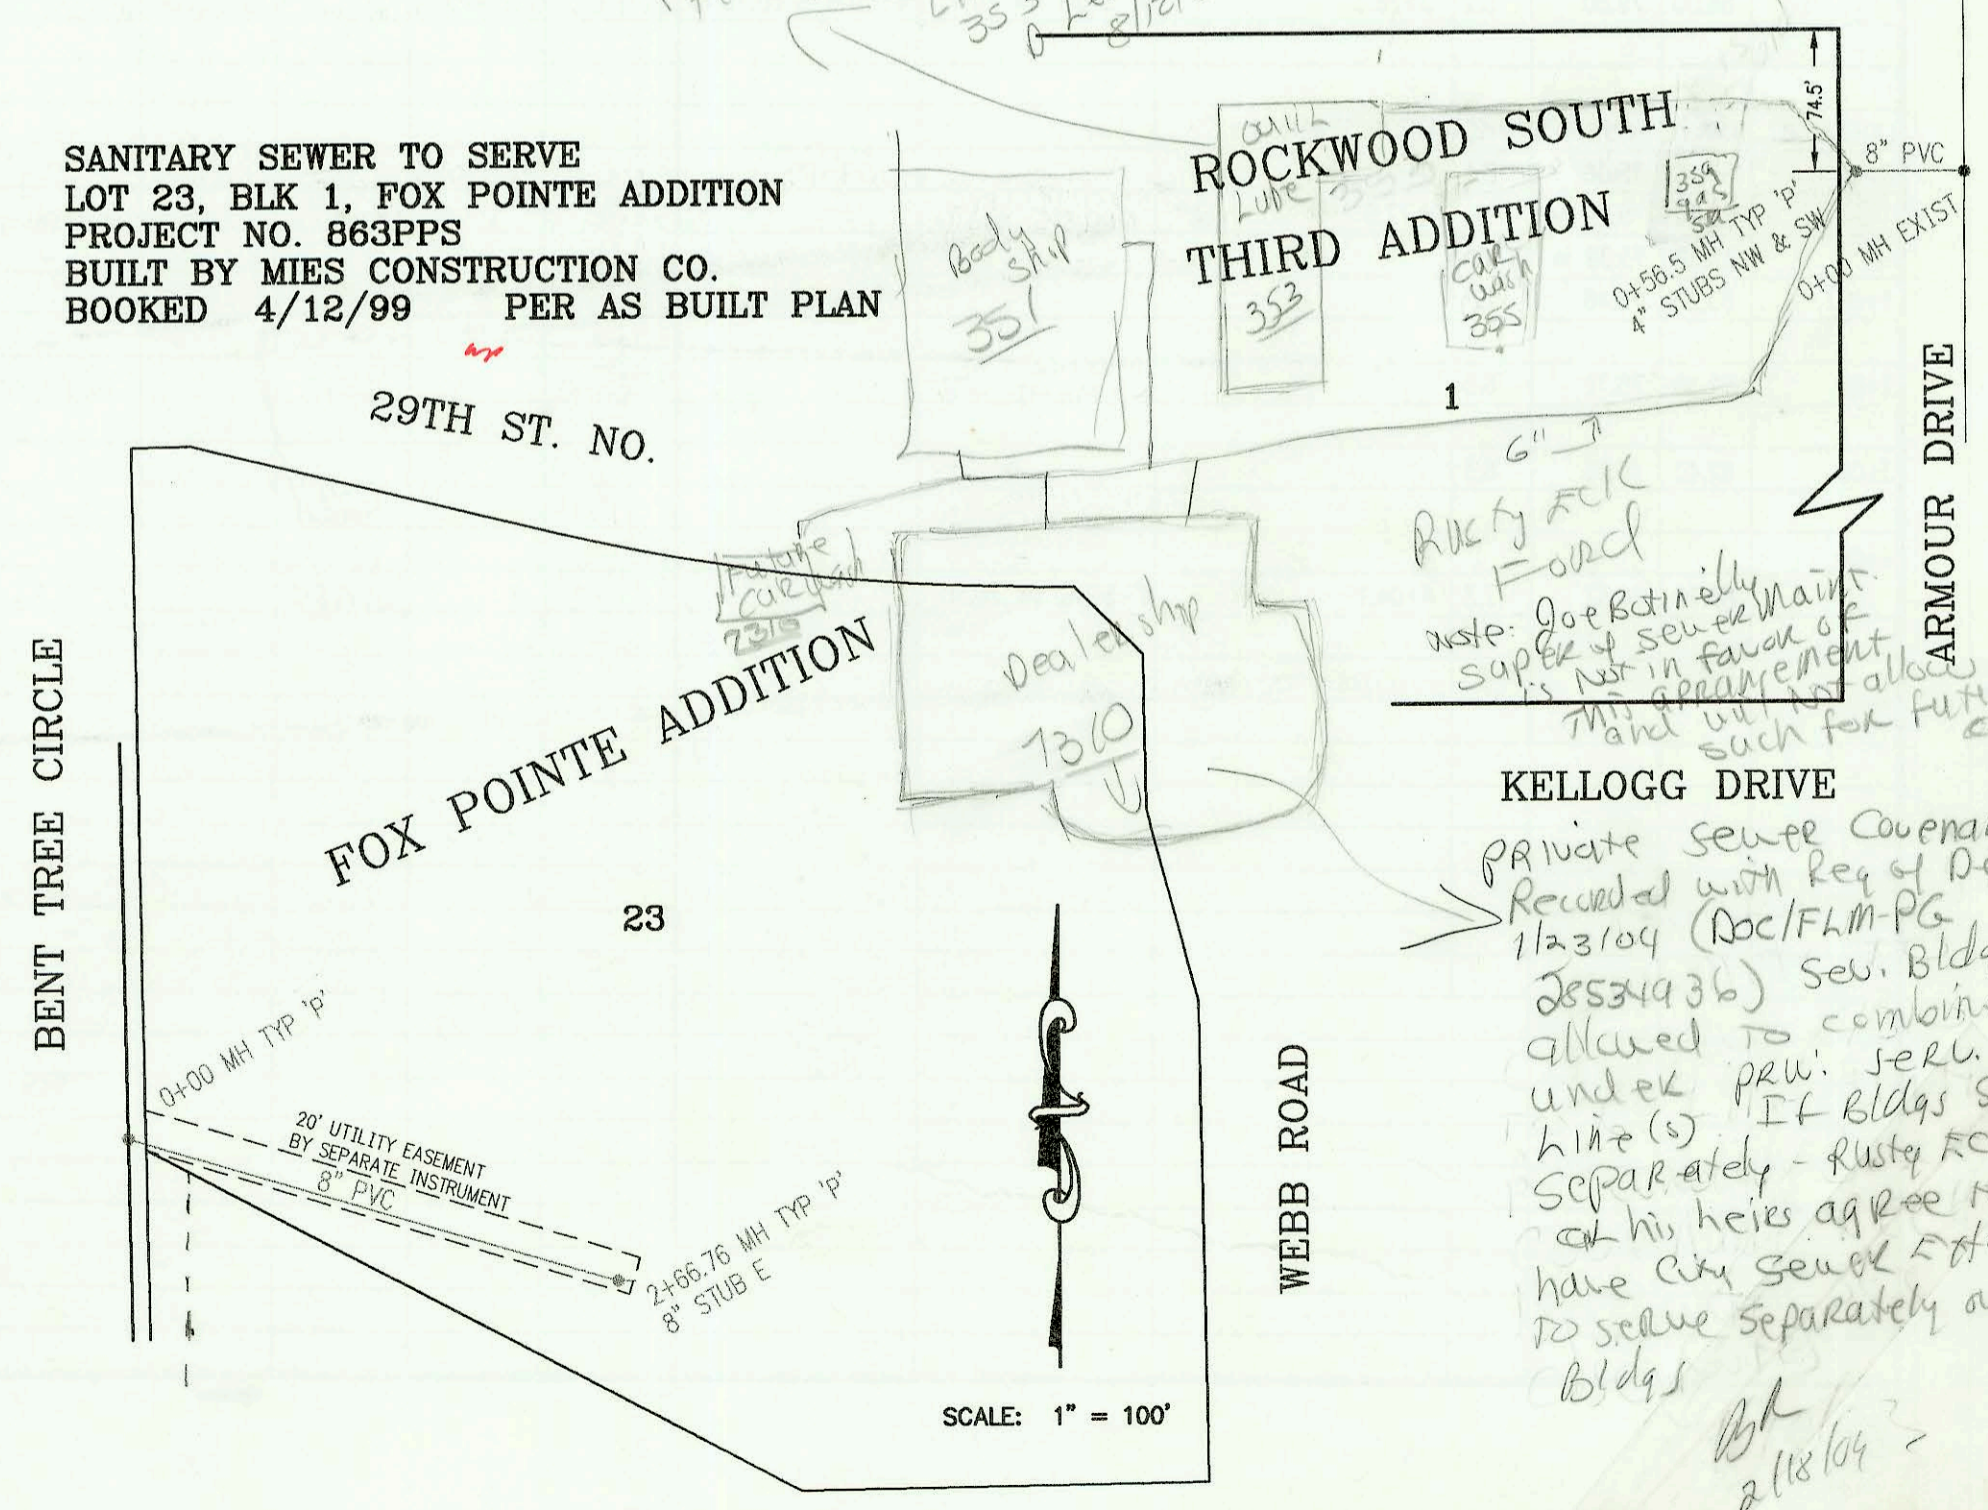

Private Sewer Covenant Recorded with Reg of Deeds 1123104 (Doc/FLM-PG 28534936) Sew. Bldgs allowed to combine under PRU: serv. line(s) If Bldgs sold separately - Rusty Fick or his heirs agree to have city sewer extended to serve separately owned Bldgs

