
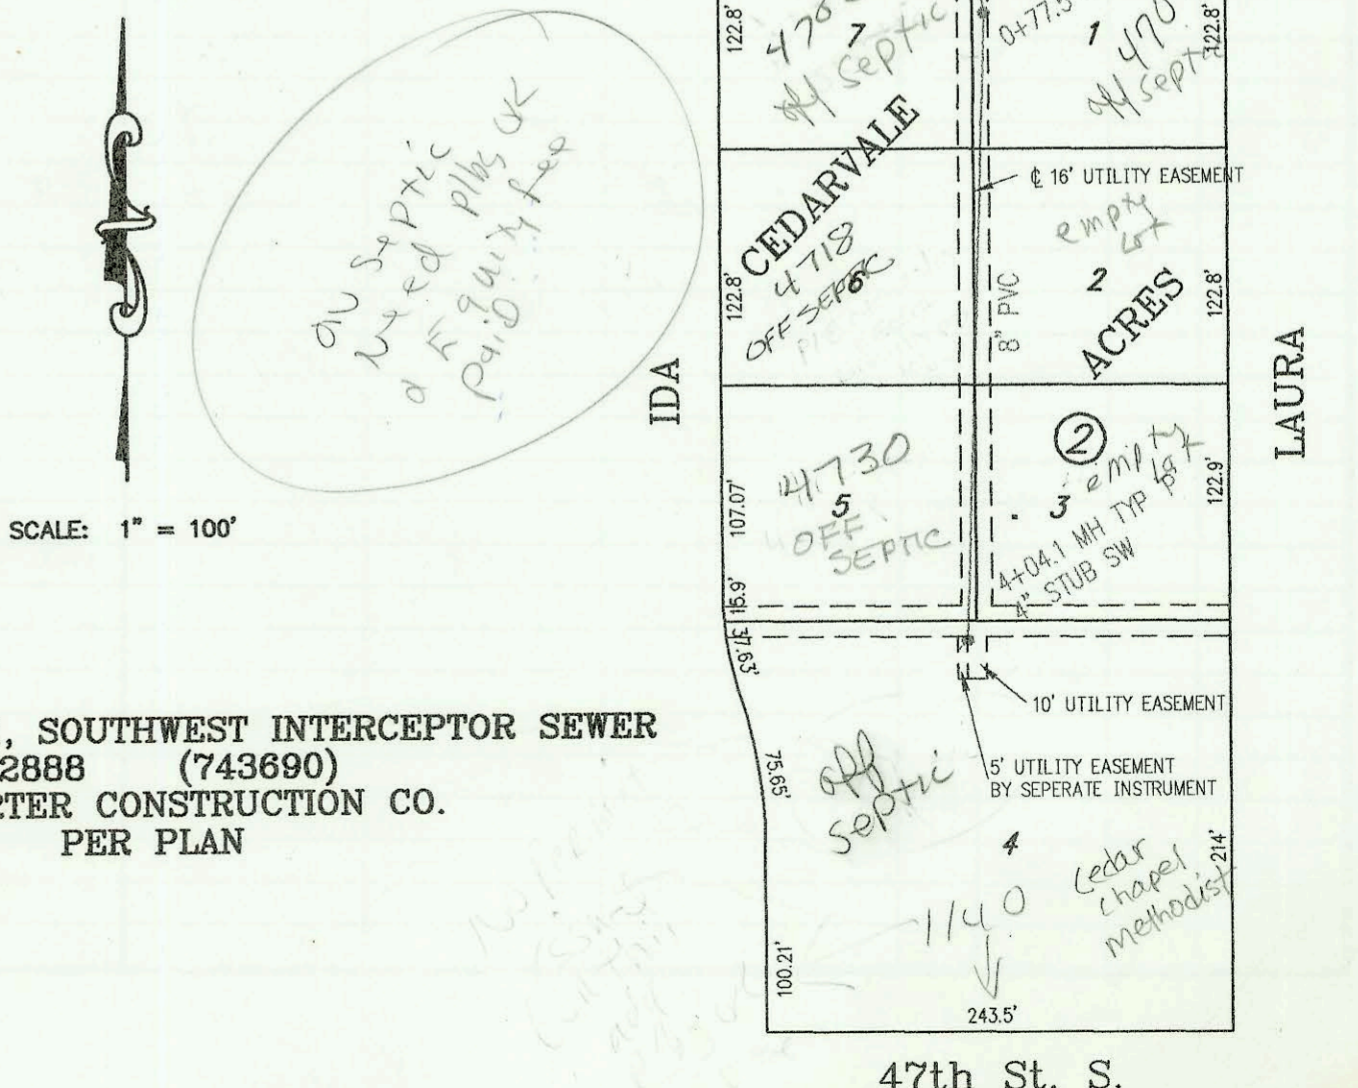


LATERAL 391, SOUTHWEST INTERCEPTOR SEWER  
 PROJECT NO. 468-82800 (743609)  
 BUILT BY W. B. CARTER CONSTRUCTION CO.  
 BOOKED 4/27/99 PER PLAN

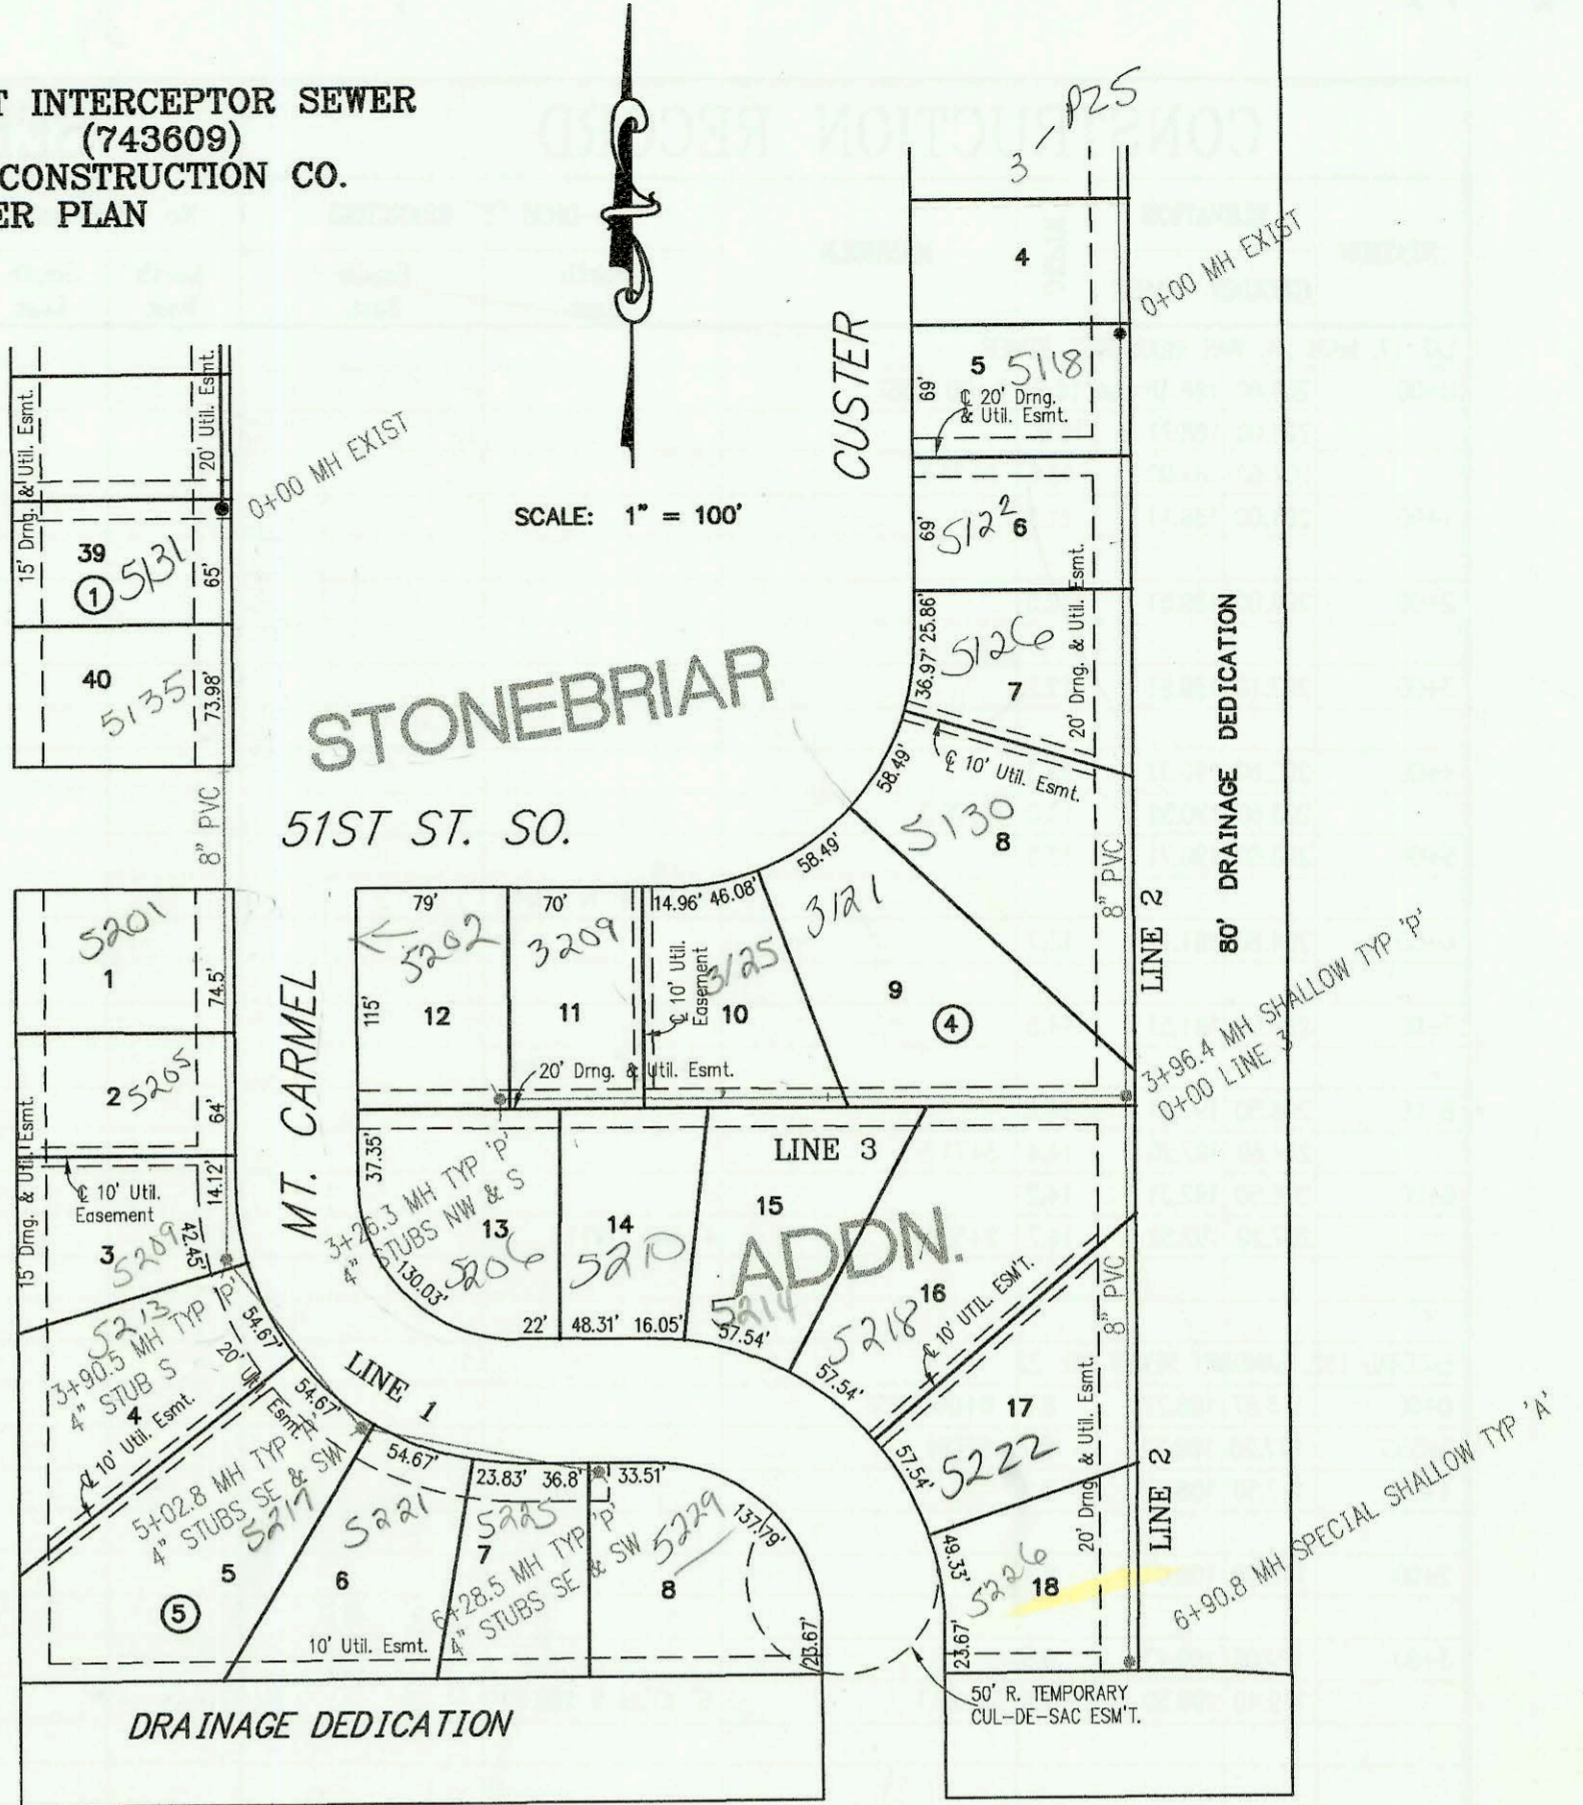

LATERAL 87, MAIN 1, SOUTHWEST INTERCEPTOR SEWER  
 PROJECT NO. 468-82888 (743690)  
 BUILT BY W. B. CARTER CONSTRUCTION CO.  
 BOOKED 5/17/99 PER PLAN

CONSTRUCTION RECORD						SERVICE RECORD						
STATION	ELEVATION		DEPTH	MANHOLE	4-INCH "Y" BRANCHES		No. of Permit		House Number		DATE OF PERMITS	
	GROUND	GRADE			North West	South East	North West	South East	North West	South East	North West	South East
LATERAL 391	SOUTHWEST INTERCEPTOR			SEWER								
0+00 L-1	87.20	76.70	10.5	0+00 EXIST	4" SCH 40 0+09		09-005105		5131 MTCARME		9-1-99	
1+00	87.60	77.00	10.6				2000-01117 1999-00279		5135 MTCARME 5201 MTCARME		5-4-00 7-28-99	
2+00	87.80	77.30	10.5									
3+00	88.50	77.61	10.9		4" SCH 40 2+88.5		1999-00500 1999-01502		5205 MTCARME 5251 MTCARME		8-25-99 8-25-99	
	89.00	77.88 out	11.1	3+90.5		4" STUB S 78.23						
	89.00	77.98 in	11.0									
4+00	88.80	78.01	10.8									
5+00					4" SCH 40 4+38.9 4" SCH 40 4+59.8		1999-01275 99-01387		5213 MTCARME 5217 MTCARME		11-20-99 12-2-99	
	88.70	78.32 out	10.4	5+02.8	4" STUB SW 78.67	4" STUB SE 78.67						
	88.70	78.42 in	10.3				2000-00713 99-00523		5221 MTCARME 5225 MTCARME 5229 MTCARME		3-17-00 8-25-99	
6+00	88.10	78.83	9.3									
	88.20	78.95	9.3	6+28.5	4" STUB SW 79.25	4" STUB SE 79.25	1999-00343				8-6-99	
0+00 L-2	85.50	77.52	8.0	0+00 EXIST	4" SCH 40 0+24 4" SCH 40 1+12		2000-01290 2000-00712		5118 CUSTER 5125 CUSTER		5-25-00 3-17-00	
1+00	84.80	77.82	7.0				2000-00596		5126 CUSTER		3-3-00	
2+00	84.50	78.12	6.4									
3+00	84.30	78.42	5.9									
	84.30	78.71	5.6	3+96.4 = 0+00 L-3								
4+00	84.00	78.72	5.3									
5+00	83.80	79.12	4.7				2000-00280		5222 MTCARME		2-1-2000	
6+00	83.60	79.43	4.2			4" SCH 40 6+60.8	1999-00509		5206 MTCARME		8-25-99	
0+00 L-3	84.30	78.81	5.5	0+00 = 3+96.4								
1+00	85.20	79.11	6.1		4" SCH 40 0+93	4" SCH 40 0+53	1999-0367 99-01274	3121 W 5125	5218 MTCARME		8-6-99 11-20-99	
2+00	86.20	79.42	6.8		4" SCH 40 2+11.3 4" SCH 40 2+97.3	4" SCH 40 1+55.3	2000-00985 99-00564	3125 W 5127 3209 W 5127	5214 MTCARME		4-21-00 8-11-99	
3+00	87.30	79.72	7.6									
	88.00	79.80	8.2	3+26.3	4" SCH 40 4" STUB NW 80.15	4" STUB S 80.15	1999-00505 99-00799	5202 MTCARME	5206 MTCARME		8-25-99 9-28-99	
LATERAL 87, MAIN 1,	SOUTHWEST INTERCEPTOR			SEWER								
0+00	83.15	75.06	8.1	0+00 EXIST		4" SCH 40 0+48		99-00593	4700 S IDA	4701 Laura		7-2-99
	83.20	75.29 out	7.9	0+77.5	4" SCH 40 0+98.5 PVC Saddle.		2000-02401				11-2-00	
	83.20	75.39 in	7.8									
1+00	83.20	75.46	7.7									
2+00	82.30	75.76	6.5		4" SCH 40 NO MSMT TAP		2000-02234		4718 S IDA		10-12-00	
3+00	82.40	76.06	6.3									
4+00					4" SCH 40 2+36.5		2000-01546		4730 IDA		7-5-00	
	83.70	76.37	7.3	4+04.1	4" STUB SW 76.70		2000-02593		4740 S IDA		3-10-03	