


21ST ST. N.

Replat
see also
P-223

P131
↑
9211
Need
Main
EXT
BR
2-14-00

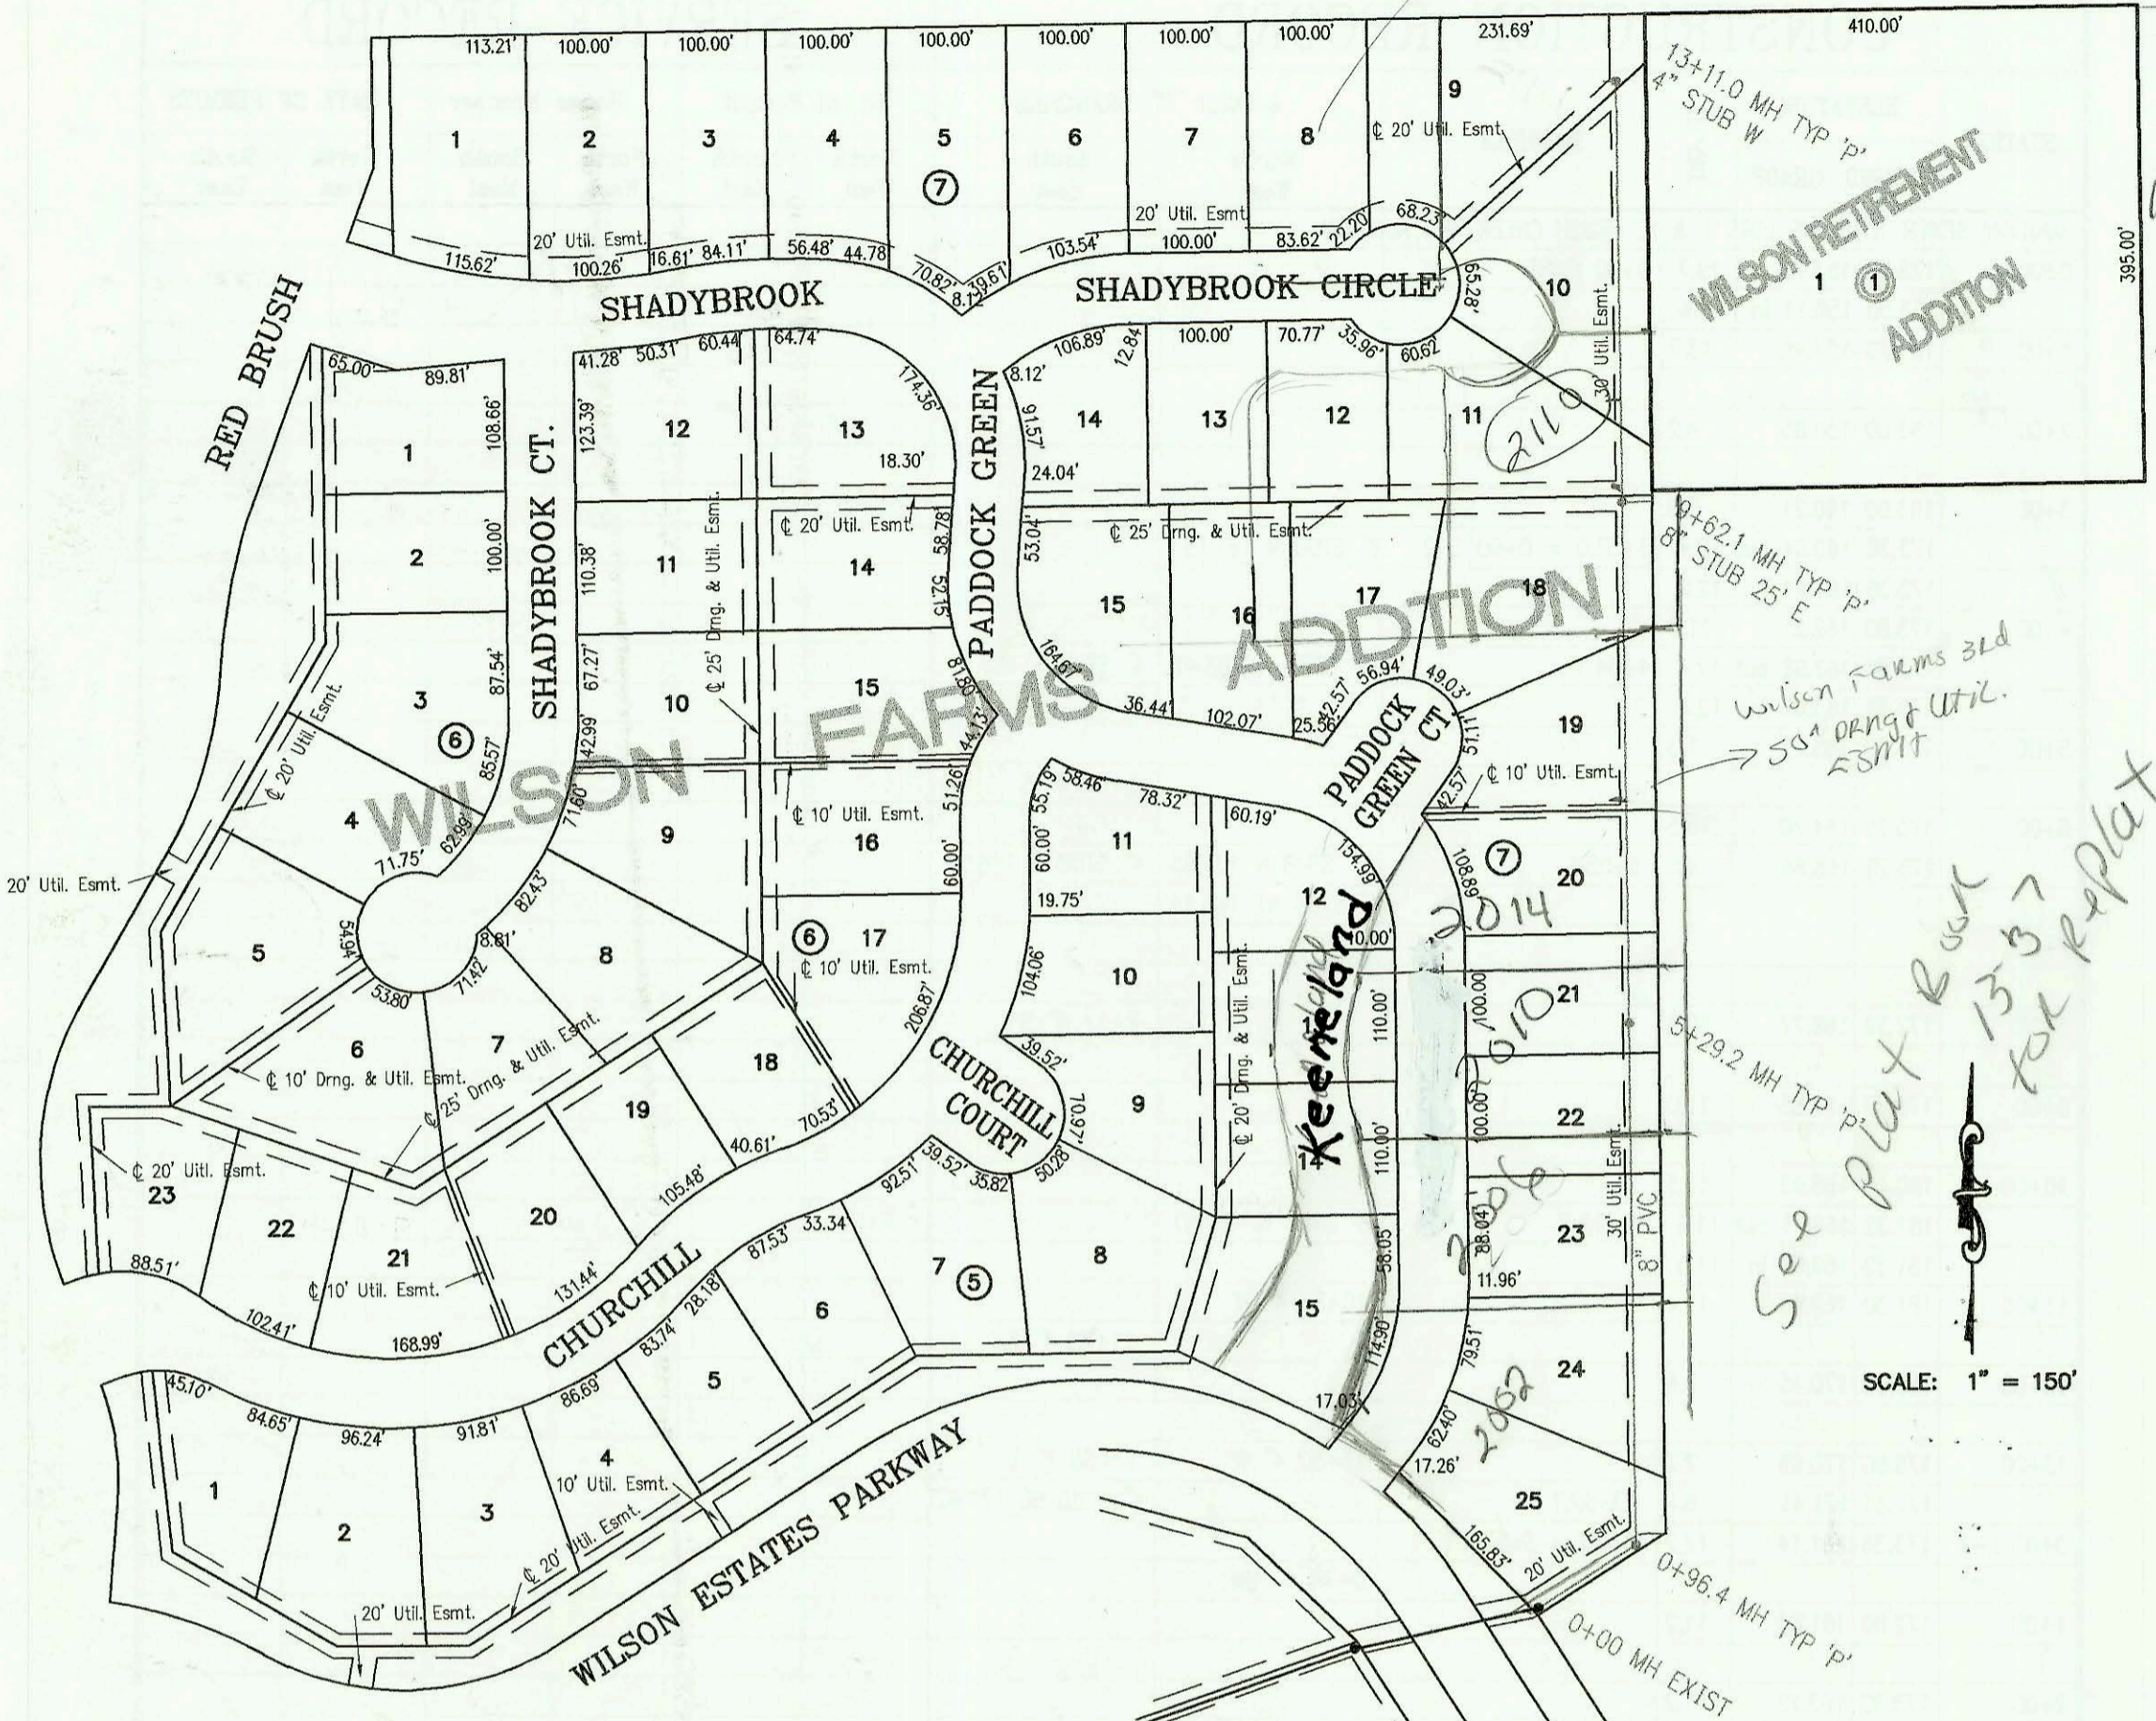


LATERAL 75, MAIN 22, WAR INDUSTRIES SEWER
 PROJECT NO. 468-82855 (743732)
 BUILT BY MIES CONSTRUCTION CO.
 BOOKED 4/28/99 PER PLAN

Wilson Farms old
 → 50" DRNG & UTIL.
 ESMT

See Plat Book
 13337
 for replat

U.S. HIGHWAY 54

LATERAL 29, MAIN 1, COWSKIN INTERCEPTOR SEWER
 PROJECT NO. 468-82933 (743782)
 BUILT BY W. B. CARTER CONSTRUCTION CO.
 BOOKED 5/10/99 PER PLAN

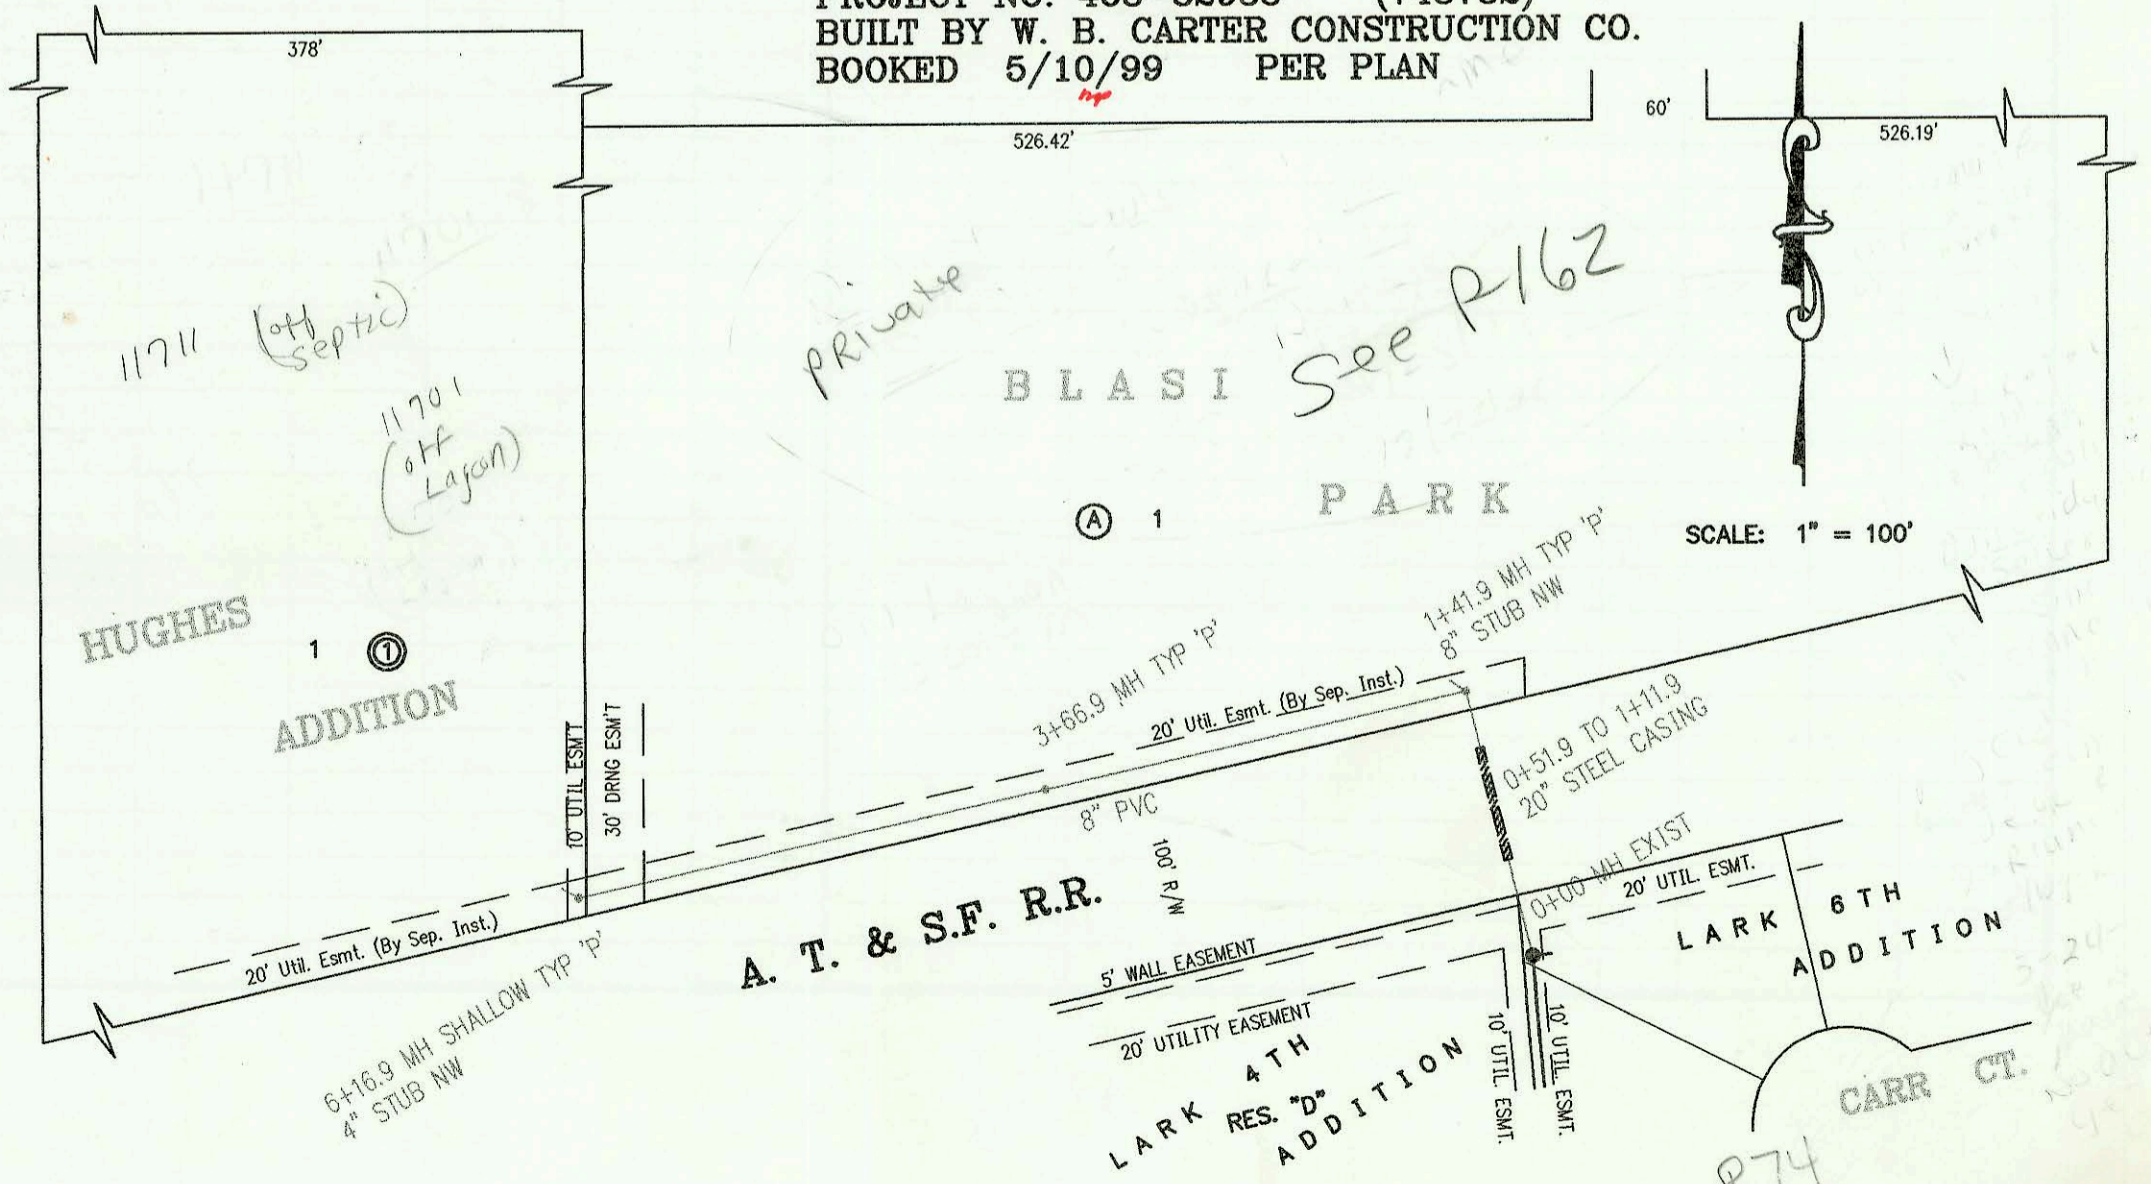

11711 (off septic)
 11701 (off Lagoon)

Private
 See P162

SCALE: 1" = 100'

P74

