


LATERAL 70, MAIN 5, SANITARY SEWER NO. 23
PROJECT NO. 468-82592 (743724)
BUILT BY KC EXCAVATING INC.
BOOKED 6/2/99 PER AS BUILT PLAN



SCALE: 1" = 100'

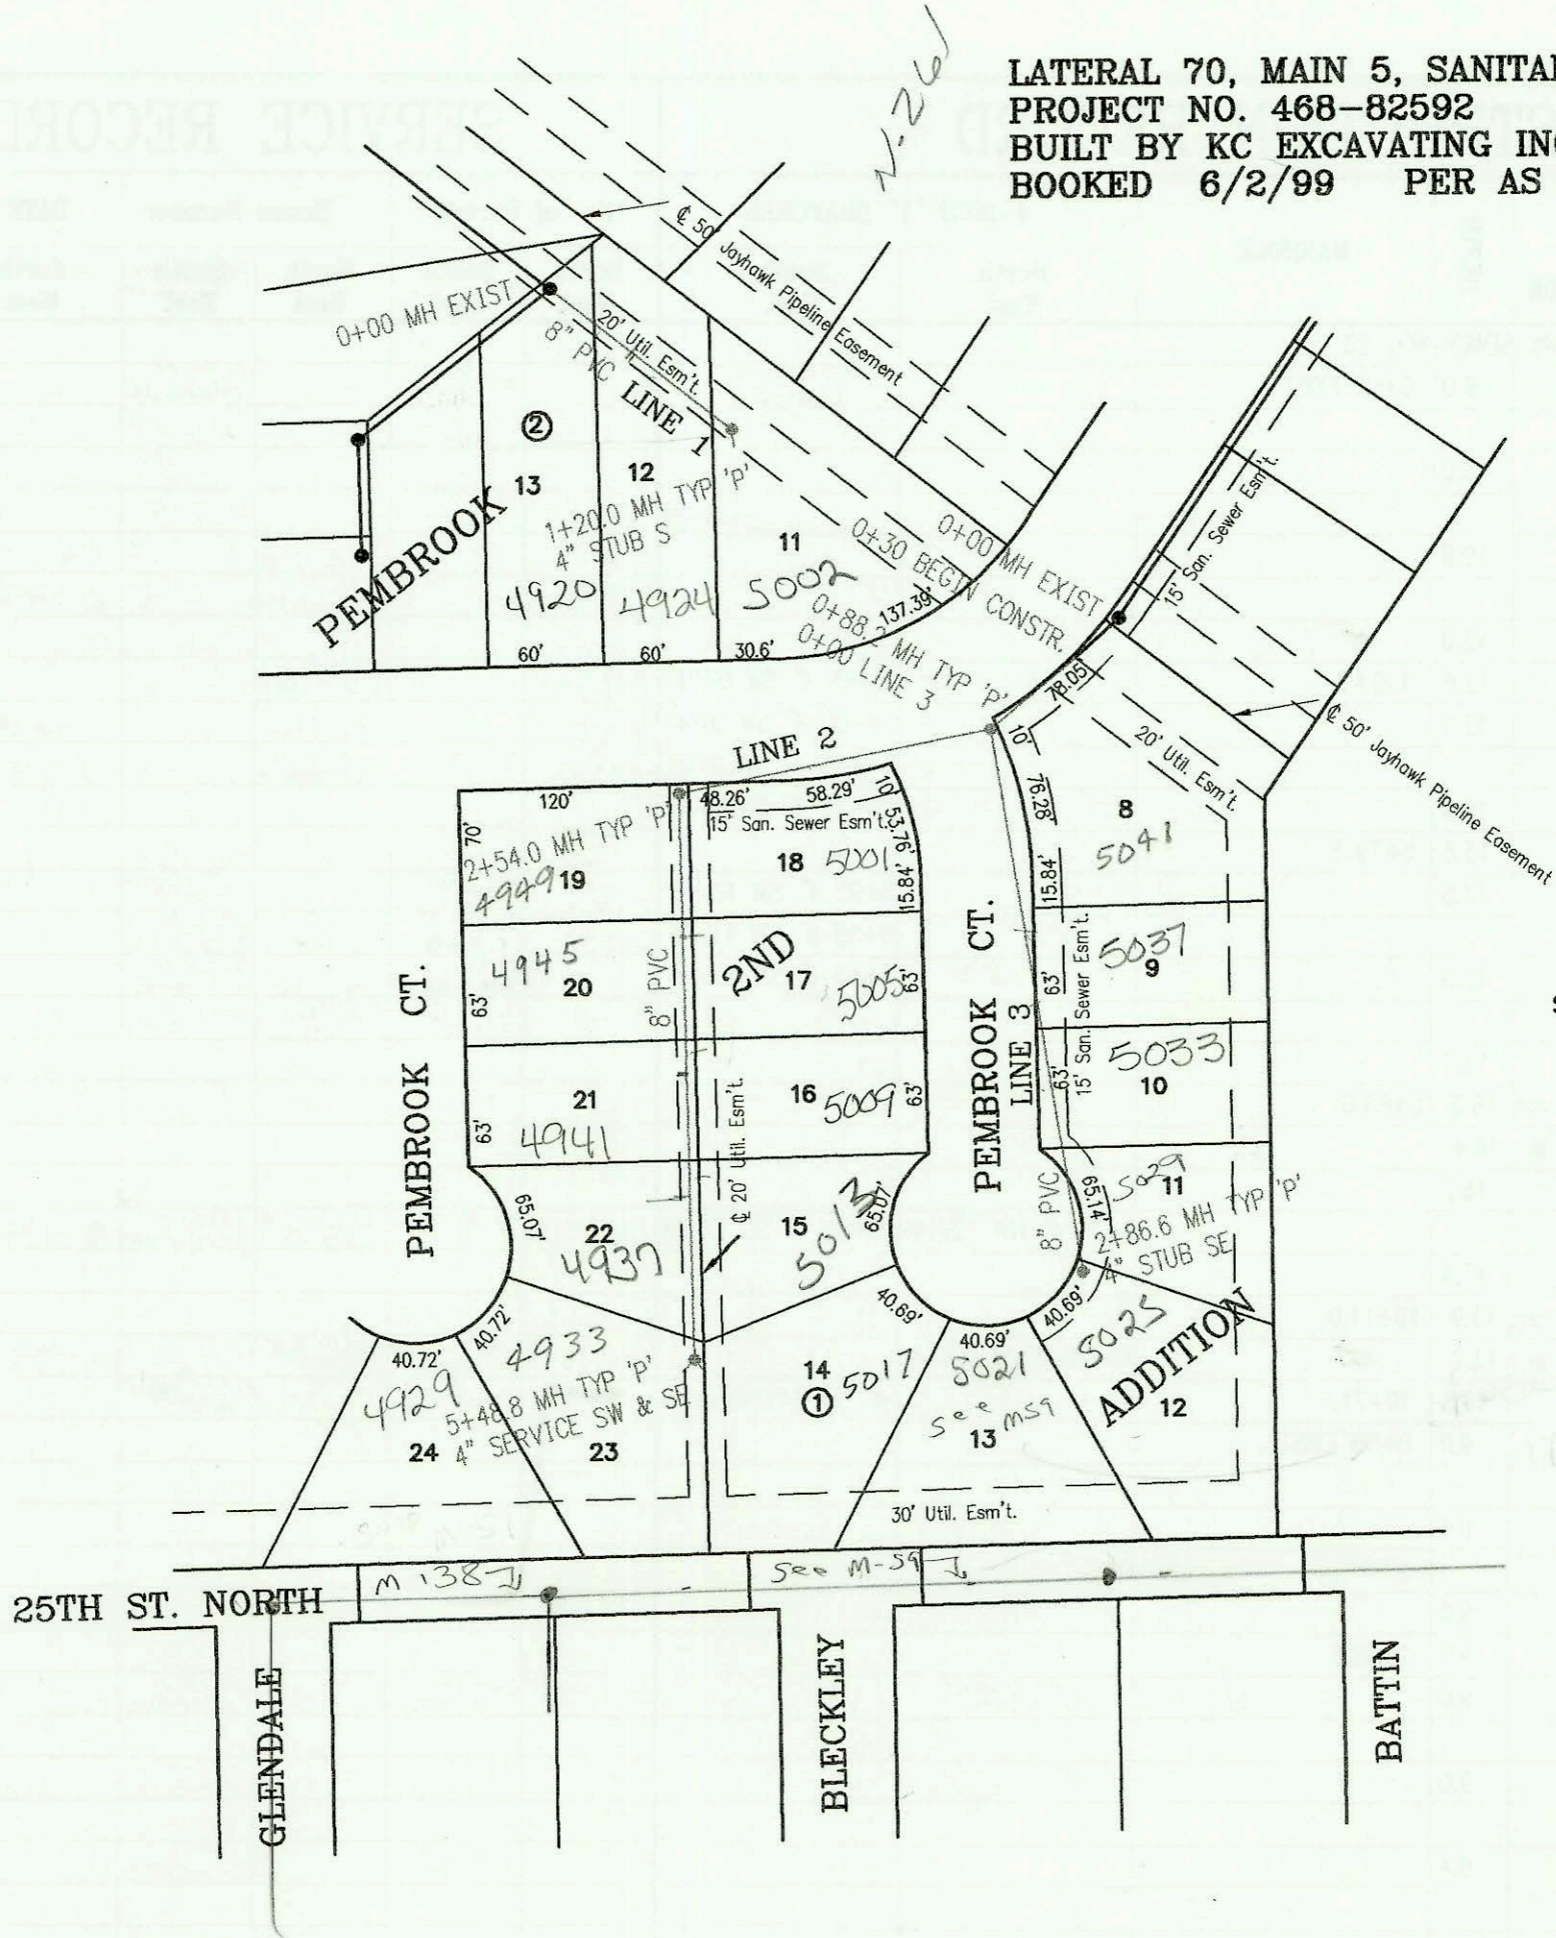