



LATERAL 423, SOUTHWEST INTERCEPTOR SEWER
 PROJECT NO. 468-82958 (743787)
 BUILT BY DONDLINGER & SONS CONSTRUCTION CO.
 BOOKED 7/7/99 PER AS BUILT PLAN

P-87A

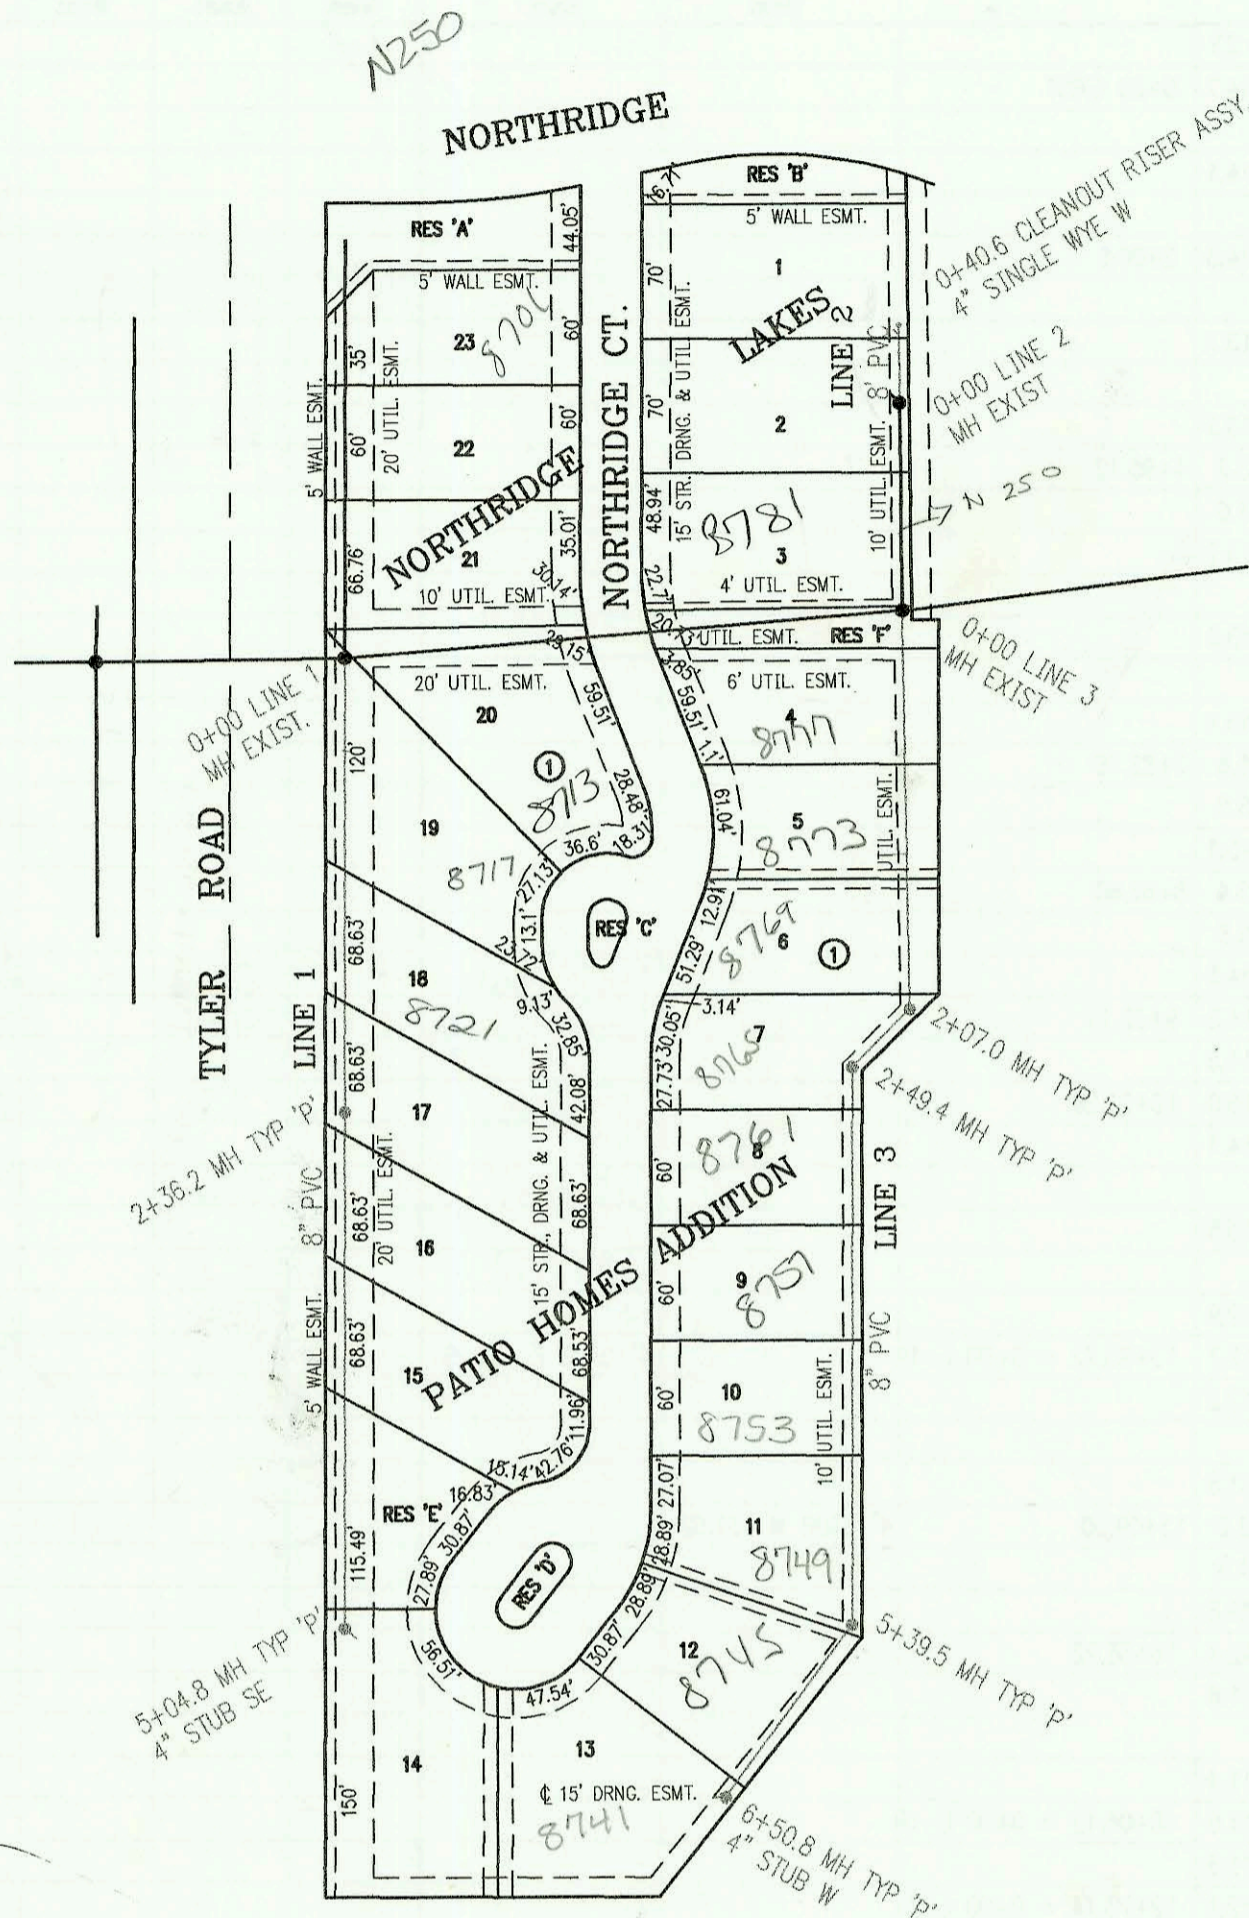

SCALE: 1" = 100'

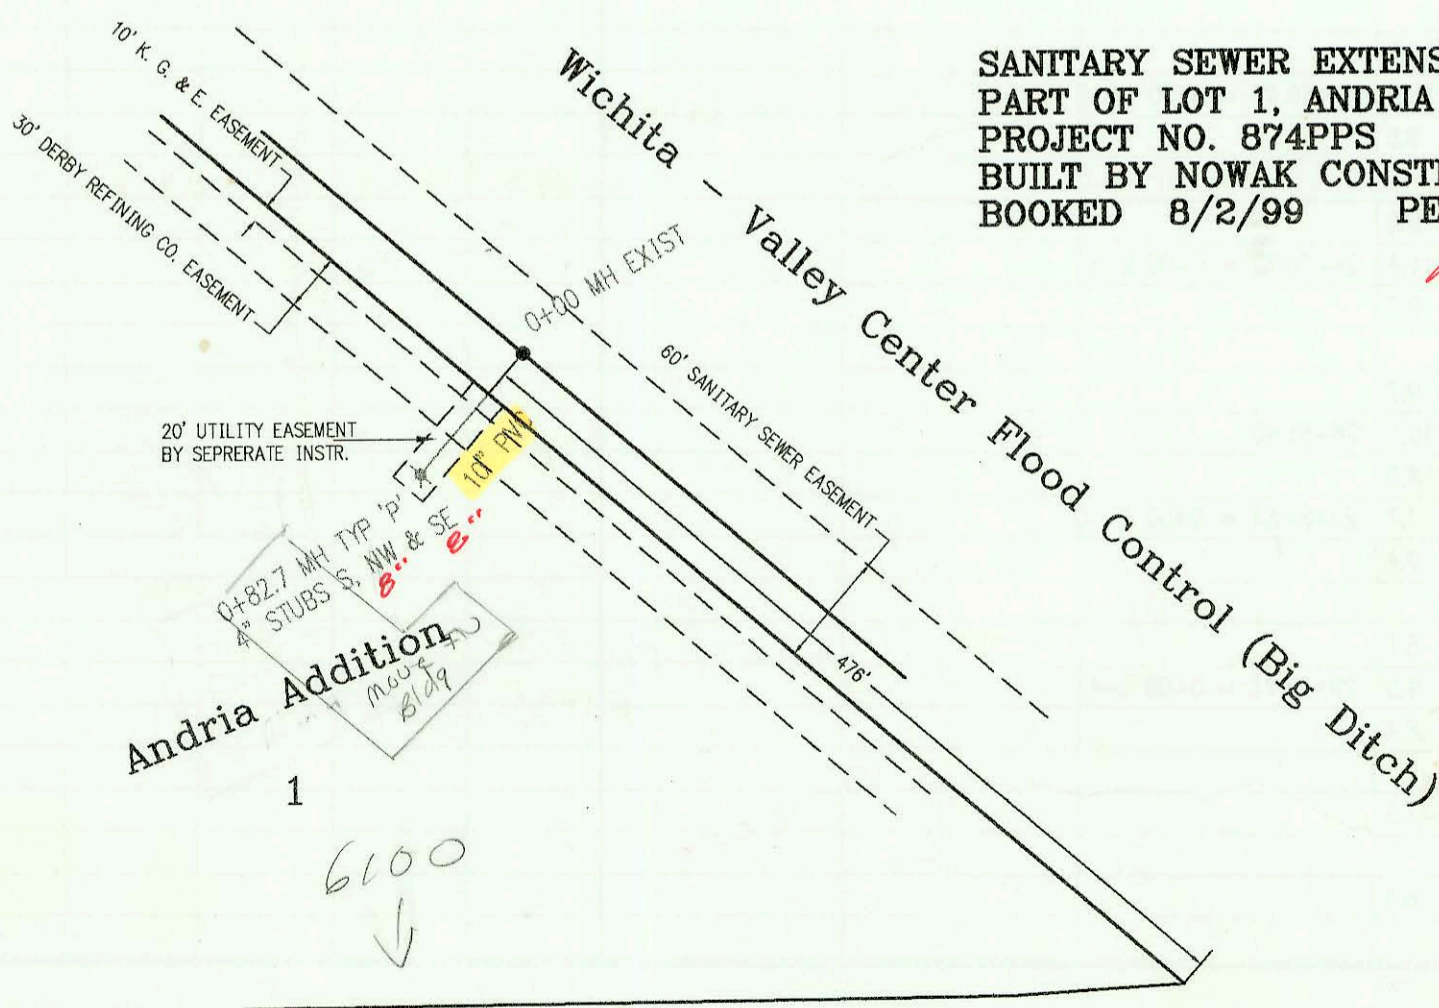

SCALE: 1" = 100'

Maple St.

CONSTRUCTION RECORD						SERVICE RECORD						
STATION	ELEVATION		DEPTH	MANHOLE	4-INCH "Y" BRANCHES		No. of Permit		House Number		DATE OF PERMITS	
	GROUND	GRADE			North West	South East	North West	South East	North West	South East	North West	South East
LATERAL 423	SOUTHWEST INTERCEPTOR			SEWER								
0+00 L-1	169.33	156.31 out	13.0	0+00 EXIST		4" SCH 40 0+48 saddle		2001- 00981		8717 W Northridge Ct		4-24-01
	169.33	156.50 in	12.8									
1+00	169.00	156.80	12.2			4" SCH 40 1+51.6		2005- 01391		8721 Northwind		6-9-05
2+00	170.00	157.10	12.9									
	170.89	157.21	13.7	2+36.2								
3+00	170.00	157.40	12.6									
4+00	170.00	157.70	12.3									
5+00												
	170.65	158.01	12.6	5+04.8		4" STUB SE 158.34						
0+00 L-2	169.82	158.10	11.7	0+00 EXIST								
	170.50	158.22	12.3	0+40.6 CLEANOUT RISER		ASSY. (SINGLE WYE W)						
0+00 L-3	167.55	157.23 out	10.3	0+00 EXIST								
	167.55	157.40 in	10.2			4" SCH 40 0+37		1997-02117 1997- 00544		4777 Northridge Ct		7-20-99
1+00	166.00	157.70	8.3			4" SCH 40 0+82				8773 Northridge		11-8-99
2+00	165.10	158.00	7.1					2000-02080 2000- 02019		8764 Northridge		10-14-03
	165.60	158.02 out	7.6	2+07.0		4" SCH 40 2+34.0				8765 Northridge		9-12-00
	165.60	158.12 in	7.5									
	166.30	158.25 out	8.1	2+49.4				2003- 01694		8761 Northridge		6-27-03
	166.30	158.35 in	7.9									
3+00	166.00	158.50	7.5									
4+00	166.00	158.80	7.2			3176.5 4" SCH 40		2004- 02971		8757 Northridge		11-9-04
5+00	166.20	159.10	7.1									
	166.90	159.22 out	7.7	5+39.5		4" SCH 40 4+37.5		2000-02021 2000- 01255		8753 W Northridge		5-23-00
	166.90	159.32 in	7.6			4" SCH 40 4+93.5		2003- 01910		8745 Northridge		7-22-03
6+00	166.10	159.50	6.6									
	166.90	159.65	7.3	6+50.8		4" STUB W 159.96		2000- 01511		8741 W NORTH RIDGE		6-27-00
LATERAL 96, SANITARY SEWER NO. 23 (CONT. FROM P-89)												
LINE 3 4+00	142.00	134.71	7.3					2003- 03270		8123 Harborlight		12-4-02
	141.80	135.01 out	6.8	4+74.42								
	141.80	135.11 in	6.7					2003- 01010		2129 Harborlight		4-16-03
5+00	141.30	135.21	6.1									
	141.60	135.36 out	6.2	5+36.95		4" STUB SE 135.69		2004- 03430		2125 Harborlight		12-30-04
LINE 3A 0+00 L-3A	143.40	133.93	9.5	0+00 = 1+79.19 L-3								
	143.30	134.21	9.1	0+71.07 CLEANOUT RISER W/DB WYE		4" SCH 40		2004- 02032		2109 Harborlight		10-20-04
LINE 3B 0+00 L-3B	142.50	134.75	7.8	0+00 = 4+74.42 L-3								
	142.10	135.06	7.0	0+78.36 CLEANOUT RISER W/DB WYE				2003- 01903	2002- 02410	2113 Harborlight	2117 W Harborlight	7-22-03 8-30-02
	142.10	135.16										
1+00	141.50	135.24										
	141.20	135.51	5.7	1+64.85		4" STUB SE 135.84		2000- 02162		2131 Harborlight		1-19-2000
LINE 4 0+00 L-4	143.10	134.23	8.9	0+00 = 29+23.11 L-1								
						4" SCH 40 1+02		2005- 01081		2017 W Harborlight		5-26-05
1+00	141.70	134.63	7.1									
2+00	141.60	135.03	6.6									
	142.00	135.24	6.8	2+53.02 = 0+00 L-4A								
3+00	141.10	135.43	5.7					2004- 03151		2009 Harborlight		11-30-04
	141.40	135.47	5.9	3+11.47		4" STUB SW 135.80		2001- 01913		2005 Harborlight		7-11-02
LINE 4A 0+00 L-4A	142.00	135.34	6.7	0+00 = 2+53.02 L-4								
1+00	140.20	135.74	4.5									
	141.60	135.78 out	5.8	1+10.90		4" STUB NE 136.21		2000- 02419		1989 Harborlight		3-31-04
	141.60	135.88 in	5.7					2005- 02111		1993 Harborlight		2-14-00
	141.40	136.17	5.2	1+84.38		4" STUB S 136.50		2004- 02065		2001 Harborlight		4-5-04
SANITARY SEWER EXTENSION TO SERVE PART OF LOT 1, ANDRIA ADDITION (874 PPS)												
0+00	119.00	102.76 out	16.2	0+00 EXIST								
	119.00	104.48 in	14.5									
	121.26	106.08	15.2	0+82.7		8" STUB NW 106.53 8" STUB SE 106.53						
						4" STUB S 106.73		99-00 888		6100 Maple	(MUSE FW BILL)	10-12-99