

CEDAR RIDGE MOBILE HOME PARK

Private Maint system by PARK


IDLEWILD

PRIVATE SANITARY SEWER EXTENSION FOR  
 CEDAR RIDGE MOBILE HOME PARK  
 PROJECT NO. 762PPS  
 BUILT BY NOWAK CONSTRUCTION CO. & ALAN'S EXCAVATING INC.  
 BOOKED 8/11/99 PER AS BUILT PLAN



SCALE: 1" = 100'

CEDAR RIDGE MOBILE HOME PARK

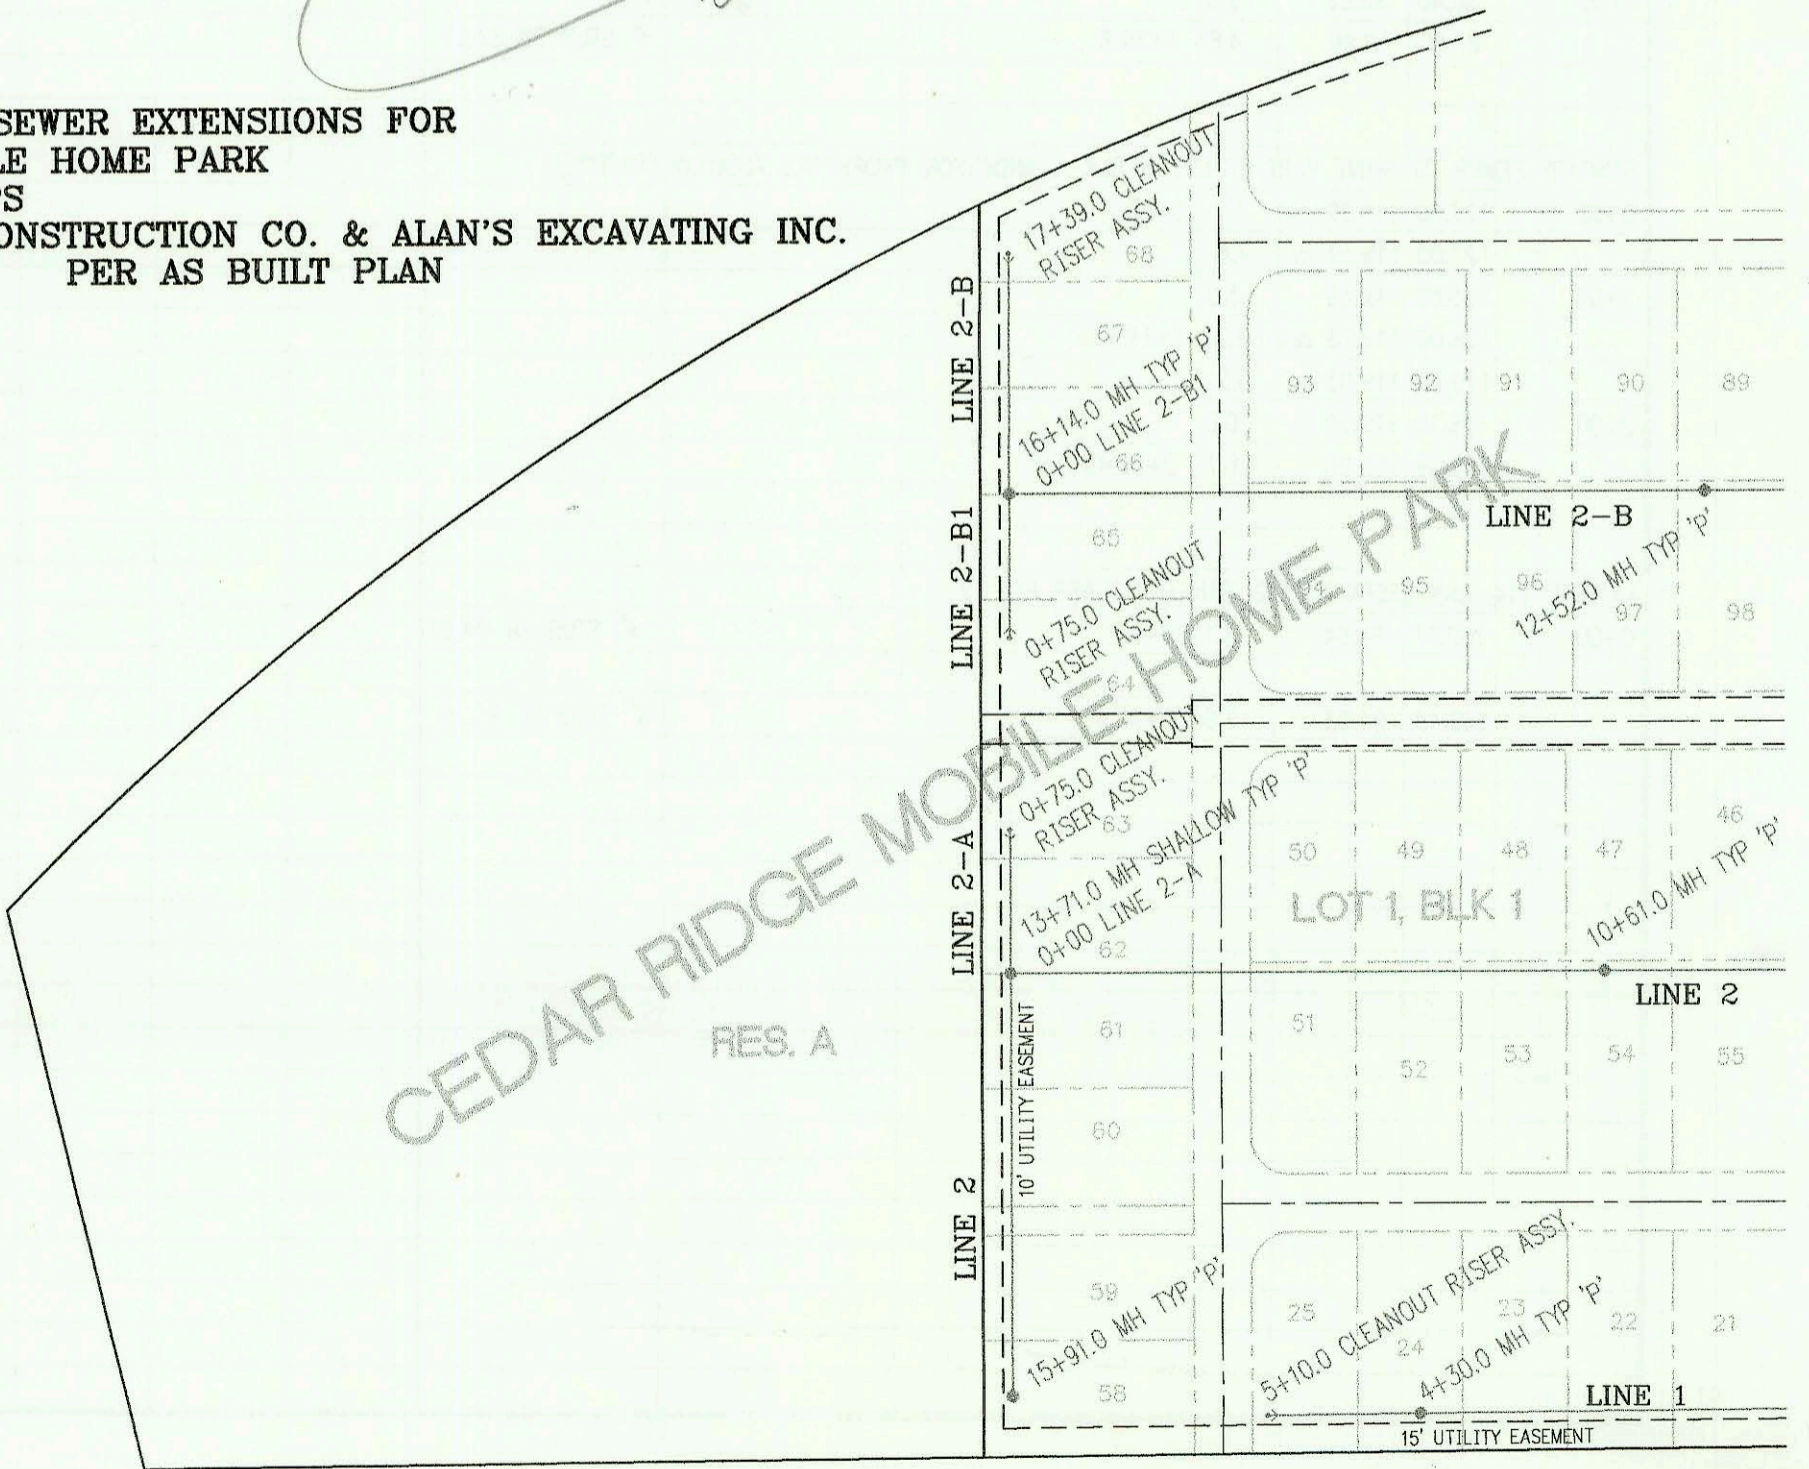

RES. A

CONSTRUCTION RECORD					SERVICE RECORD							
STATION	ELEVATION		DEPTH	MANHOLE	4-INCH "Y" BRANCHES		No. of Permit		House Number		DATE OF PERMITS	
	GROUND	GRADE			North West	South East	North West	South East	North West	South East	North West	South East
PRIV. SANITARY SEWER EXTENSIONS FOR CEDAR RIDGE MOBILE HOME PARK (762PPS)												
0+00 L-1	80.50	74.00 out	6.5	0+00 EXIST								
	80.80	74.20 in	6.6									
	79.50	74.35 out	5.2	0+30.0 = 0+00 L-1A								
	79.50	74.45 in	5.1									
1+00	80.00	74.66	5.3									
2+00	80.00	74.96	5.0									
3+00	80.20	75.26	4.9									
4+00	80.00	75.56	4.4									
	80.30	75.65	4.7	4+30.0								
5+00												
	80.00	75.89	4.1	5+10.0 CLEANOUT RISER								
0+00 L-1A	79.50	74.45	5.1	0+00 = 0+30.0 L-1								
1+00	78.90	74.75	4.2									
2+00	78.80	75.05	3.8									
3+00	78.70	75.35	3.3									
	79.00	75.47	3.5	3+40.0								
0+00 L-2	81.50	62.76 out	18.7	0+00 EXIST								
	81.50	66.78 in	14.7									
	80.00	67.10 out	12.9	0+80.0								
	80.00	67.45 in	12.6									
1+00	79.60	67.57	12.0									
	80.00	67.65 out	12.4	1+32.0								
	80.00	69.46 in	10.5									
2+00	79.80	69.73	10.1									
3+00	77.70	70.13	7.6									
4+00	80.50	70.53	10.0									
	80.50	70.70 out	9.8	4+41.0								
	80.50	70.80 in	9.7									
5+00	79.80	71.04	8.8									
6+00	78.80	71.44	7.4									
7+00	78.90	71.84	7.1									
	79.50	72.04	7.5	7+51.0								
8+00	79.10	72.24	6.9									
9+00	79.50	72.64	6.9									
10+00	80.00	73.40	6.6									
	80.20	73.24	7.0	10+61.0								
11+00	80.00	73.44	6.6									
12+00	79.50	73.84	5.7									
13+00	79.30	74.24	5.1									
	79.40	74.52 out	4.9	13+71.0								
	79.40	74.62 in	4.8									
14+00	79.40	74.74	4.7									
15+00	80.20	75.14	5.1									
	81.30	75.50	5.8	15+91.0								
0+00 L-2A	79.30	74.62	4.7	0+00 = 13+71.0 L-2								
	79.30	74.92	4.4	0+75.0 CLEANOUT RISER								
0+00 L-2B	80.00	67.75	12.3	0+00 = 1+32.0 L-2								
1+00	79.80	68.15	11.7									
2+00	80.60	68.55	12.0									
3+00	80.40	68.95	11.5									
	80.00	69.12 out	10.9	3+41.0 = 0+00 L-2C								
	80.00	69.22 in	10.8									