

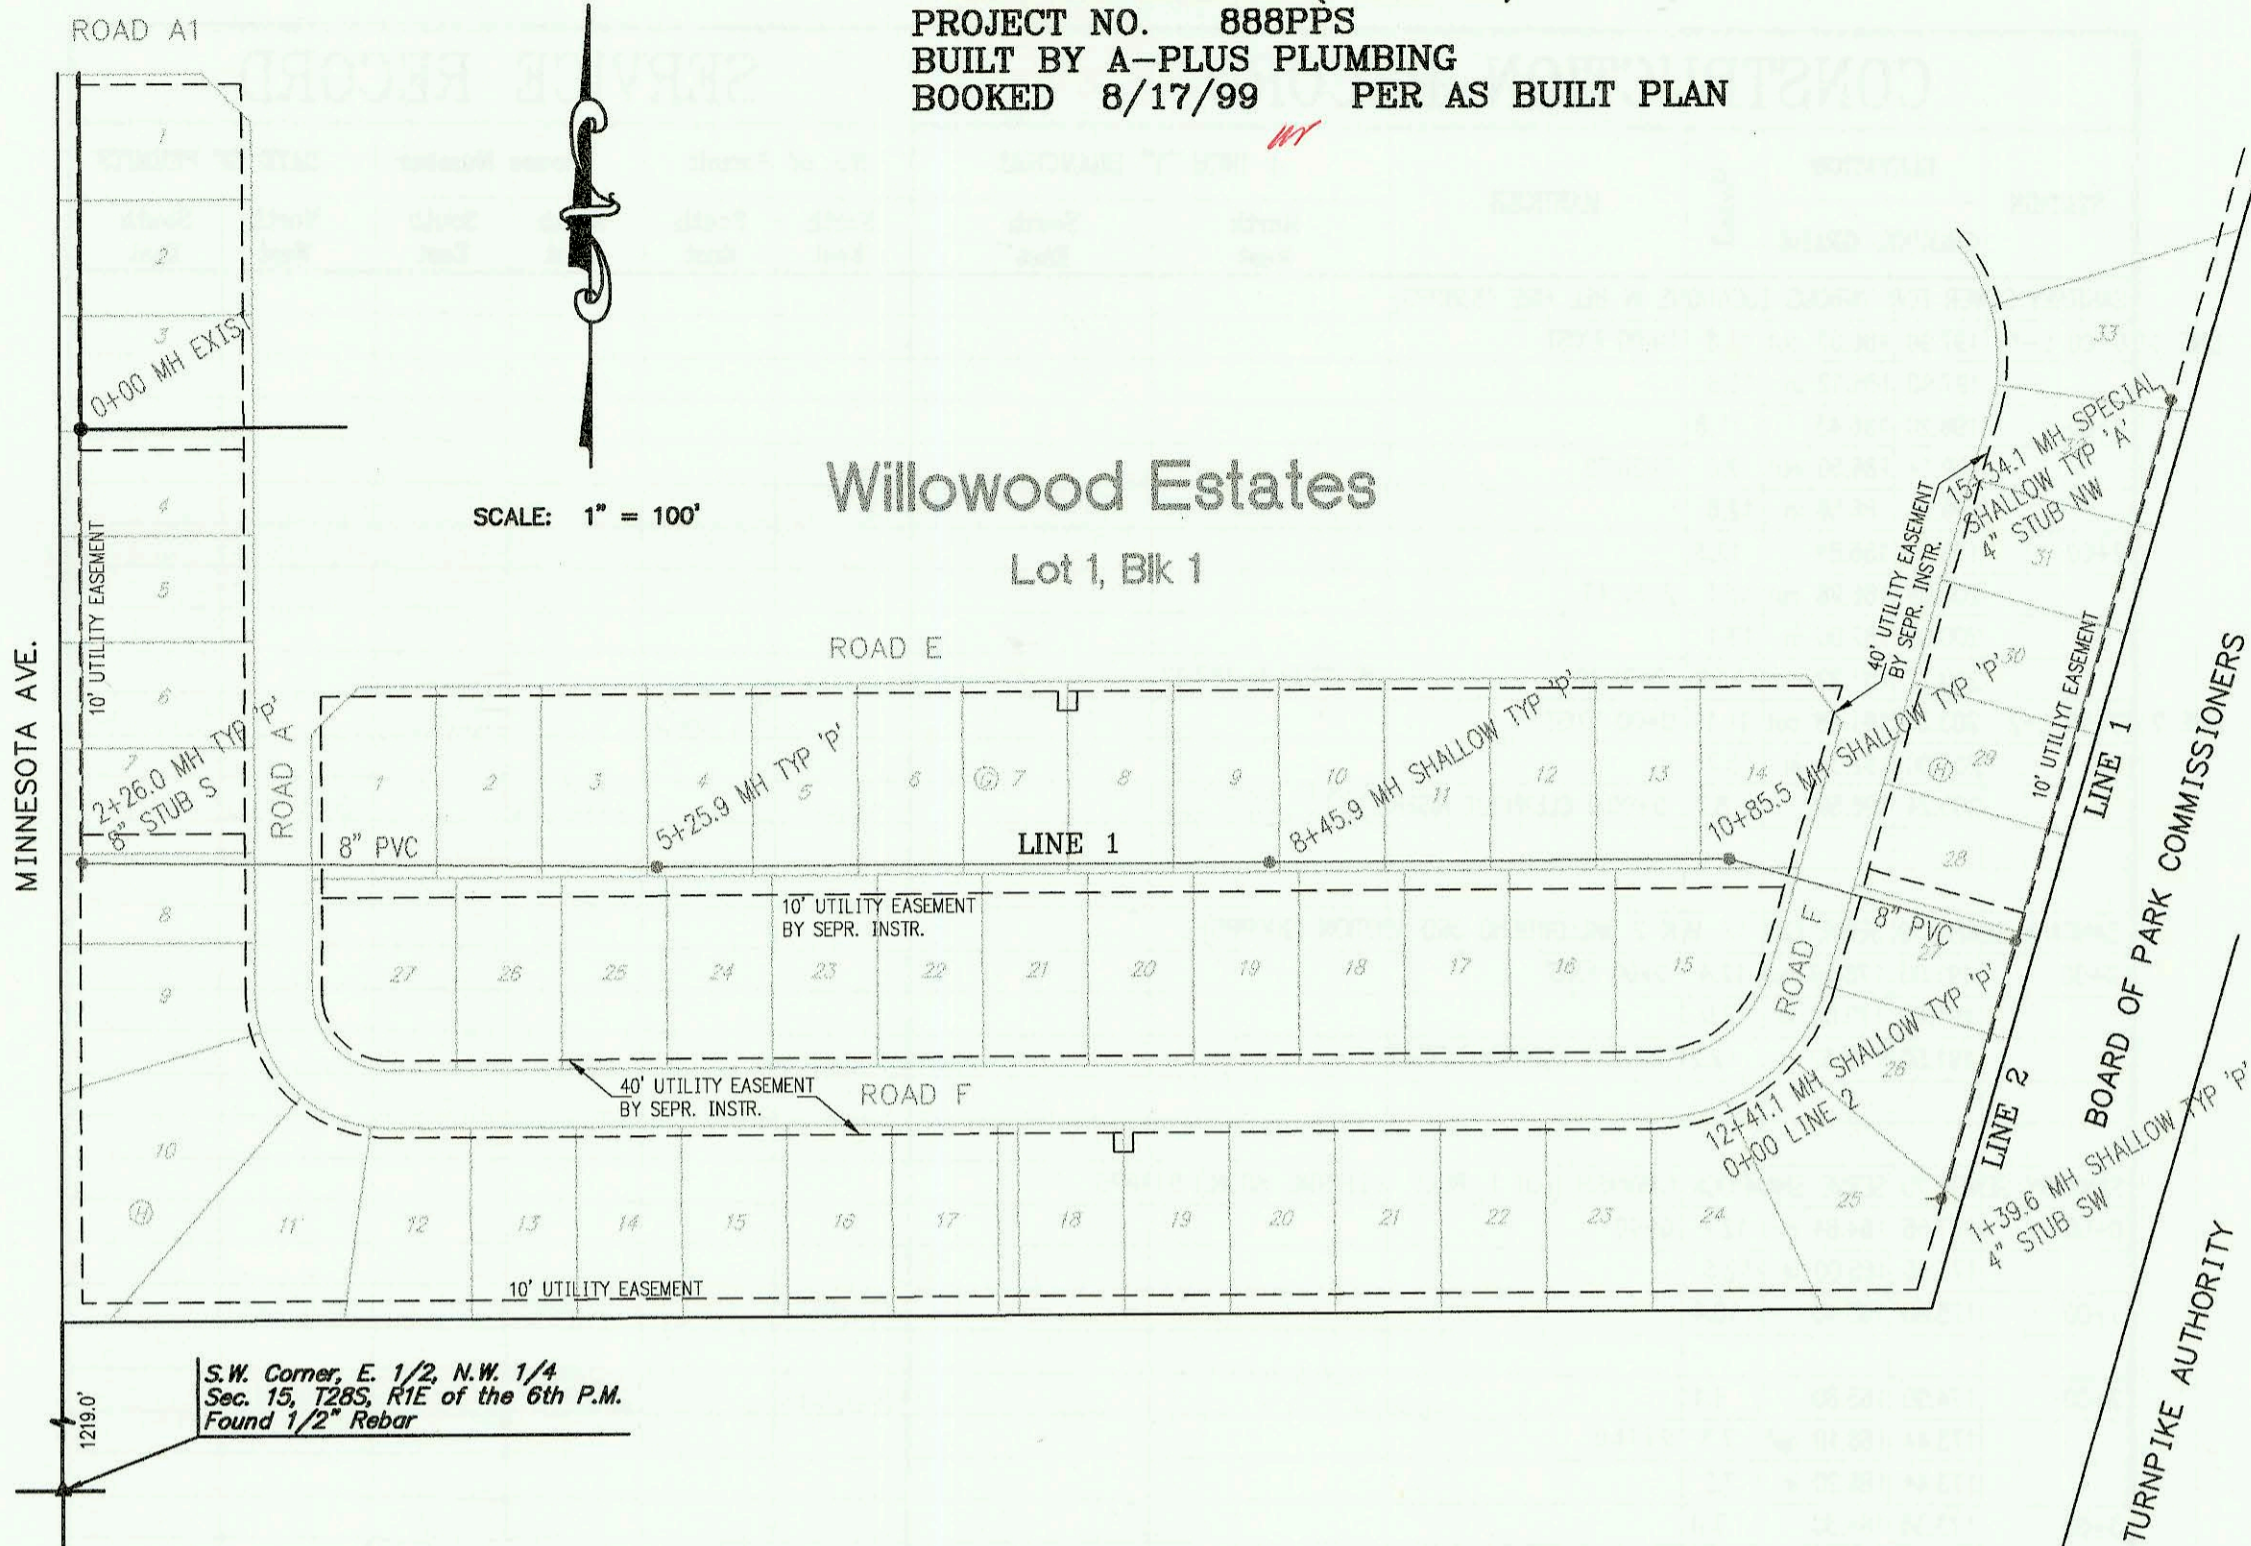


PRIVATE SANITARY SEWER TO SERVE
 WILLOWOOD ESTATES (PHASE III)
 PROJECT NO. 888PPS
 BUILT BY A-PLUS PLUMBING
 BOOKED 8/17/99 PER AS BUILT PLAN

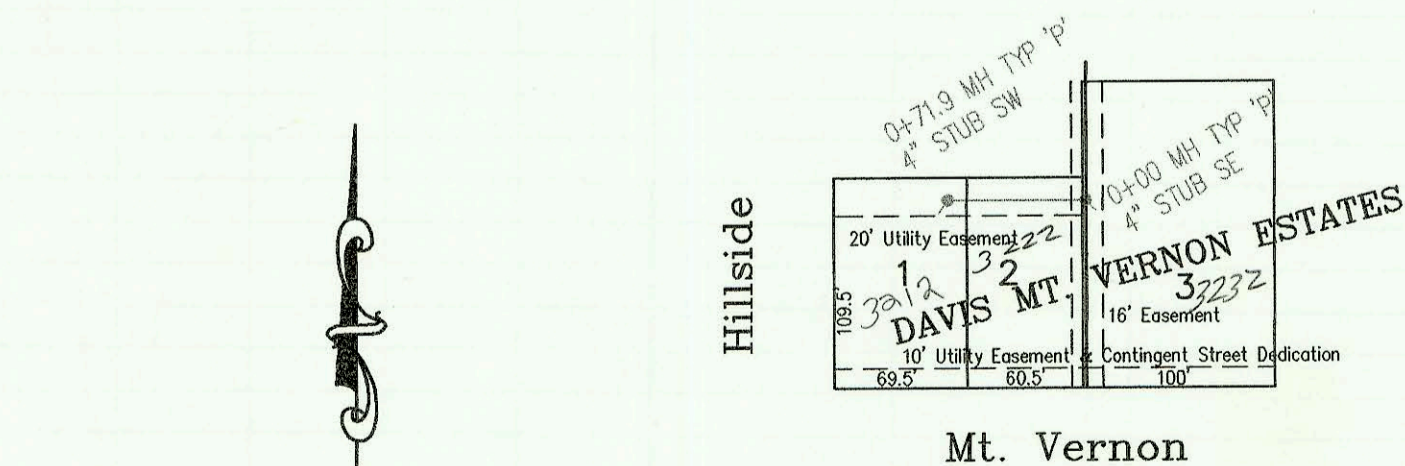

S.W. Corner, E. 1/2, N.W. 1/4
 Sec. 15, T28S, R1E of the 6th P.M.
 Found 1/2" Rebar

SANITARY SEWER TO SERVE PART OF LOT 1, BLK A,
 ANDERSON PROPERTIES ADDITION
 PROJECT NO. 867PPS
 BUILT BY McCULLOUGH EXCAVATION
 BOOKED 8/18/99 PER AS BUILT PLAN

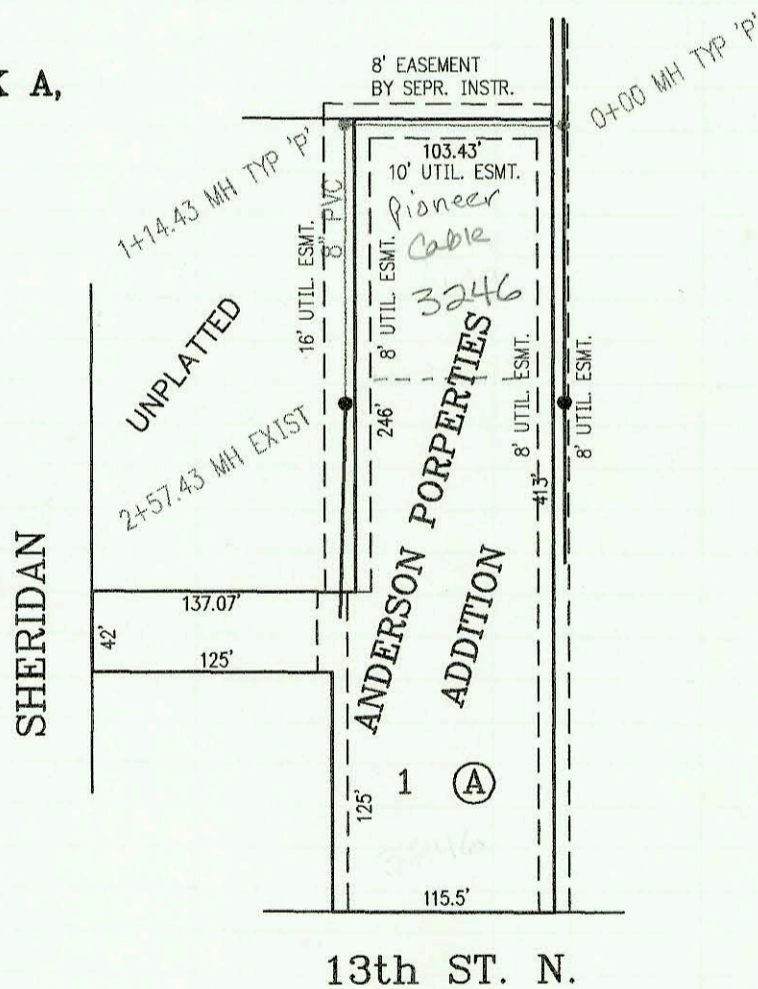

LATERAL 114, DRY CREEK MAIN 2, SANITARY SEWER NO. 12
 PROJECT NO. 468-82764 (743796)
 BUILT BY McCULLOUGH EXCAVATION
 BOOKED 8/23/99 PER PLAN

CONSTRUCTION RECORD						SERVICE RECORD						
STATION	ELEVATION		DEPTH	MANHOLE	4-INCH "Y" BRANCHES		No. of Permit		House Number		DATE OF PERMITS	
	GROUND	GRADE			North West	South East	North West	South East	North West	South East	North West	South East
Private Sanitary Sewer to serve Willowood Estates (phase III) 888PPS												
LINE 1	0+00 L-1	87.25	78.07	9.2	0+00 EXIST							
						0+37.3 4" E						
	1+00	87.10	78.40	8.7		0+88.2 4" E						
						1+44.6 4" E						
	2+00	87.40	78.73	8.7		2+00.0 4" E						
		88.03	78.82 out	9.2	2+26.0	8" STUB S 78.82						
		88.03	78.92 in	9.1								
	3+00	87.10	79.15	8.0								
						3+92.8 4" N	3+83.6 4" S					
	4+00	87.40	79.46	7.9		4+44.1 4" N	4+39.9 4" S					
						4+95.0 4" S						
	5+00	87.80	79.77	8.0		5+00.1 4" S						
		88.29	79.85	8.4	5+25.9	5+53.1 4" N	5+47.4 4" S					
	6+00	87.50	80.06	7.4		6+07.9 4" N	6+03.1 4" S					
						6+62.8 4" N	6+58.8 4" S					
	7+00	87.20	80.34	6.9		7+19.3 4" N	7+15.5 4" S					
						7+75.7 4" N	7+71.3 4" S					
	8+00	87.00	80.62	6.4		8+31.4 4" N	8+26.9 4" S					
		87.20	80.75	6.4	8+45.9							
	9+00	86.70	81.00	5.7		8+80.8 4" N	8+77.5 4" S					
						9+36.9 4" N	9+32.5 4" S					
	10+00	86.50	81.45	5.0								
		87.38	81.84	5.5	10+85.5							
	11+00	86.50	81.89	4.6								
	12+00	86.00	82.24	3.8								
		87.17	82.38 out	4.8	12+41.1 = 0+00 L-2							
		87.17	82.44 in	4.7								
	13+00	86.00	82.70	3.3								
	14+00	85.80	83.13	2.7								
	15+00	85.60	83.57	2.0								
		86.42	83.72	2.7	15+34.1	4" STUB NW 83.89						
LINE 2	0+00 L-2	87.17	82.38	4.8	0+00 = 12+41.1 L-1							
	1+00	86.40	82.82	3.6								
		87.60	82.99	4.6	1+39.6	4" STUB SW 83.20						
SANITARY SEWER TO SERVE PART OF LOT 1, BLK A, ANDERSON PROPERTIES ADDITION (867PPS)												
	0+00	127.00	119.29 out	7.7	0+00							
		127.00	119.39 in	7.6								
	1+00	125.60	119.69	5.9								
		126.00	119.73 out	6.3	1+14.43							
		126.00	119.83 in	6.2								
	2+00	126.10	120.09	6.0								
		126.39	120.26	6.1	2+57.43 EXIST	4" SCH 40 2+52.43	1999- 01103	3046 W 12th ST N (Rear Bldg)			11-3-99	
LATERAL 114, DRY CREEK MAIN 2, SANITARY SEWER NO. 12												
	0+00	102.77	94.64	8.1	0+00	4" STUB SW 94.87						
		102.49	94.93	7.6	0+71.9	4" SCH 40 4" STUB SE 95.26	99-00528	3812 MTV RND			8-27-99	