


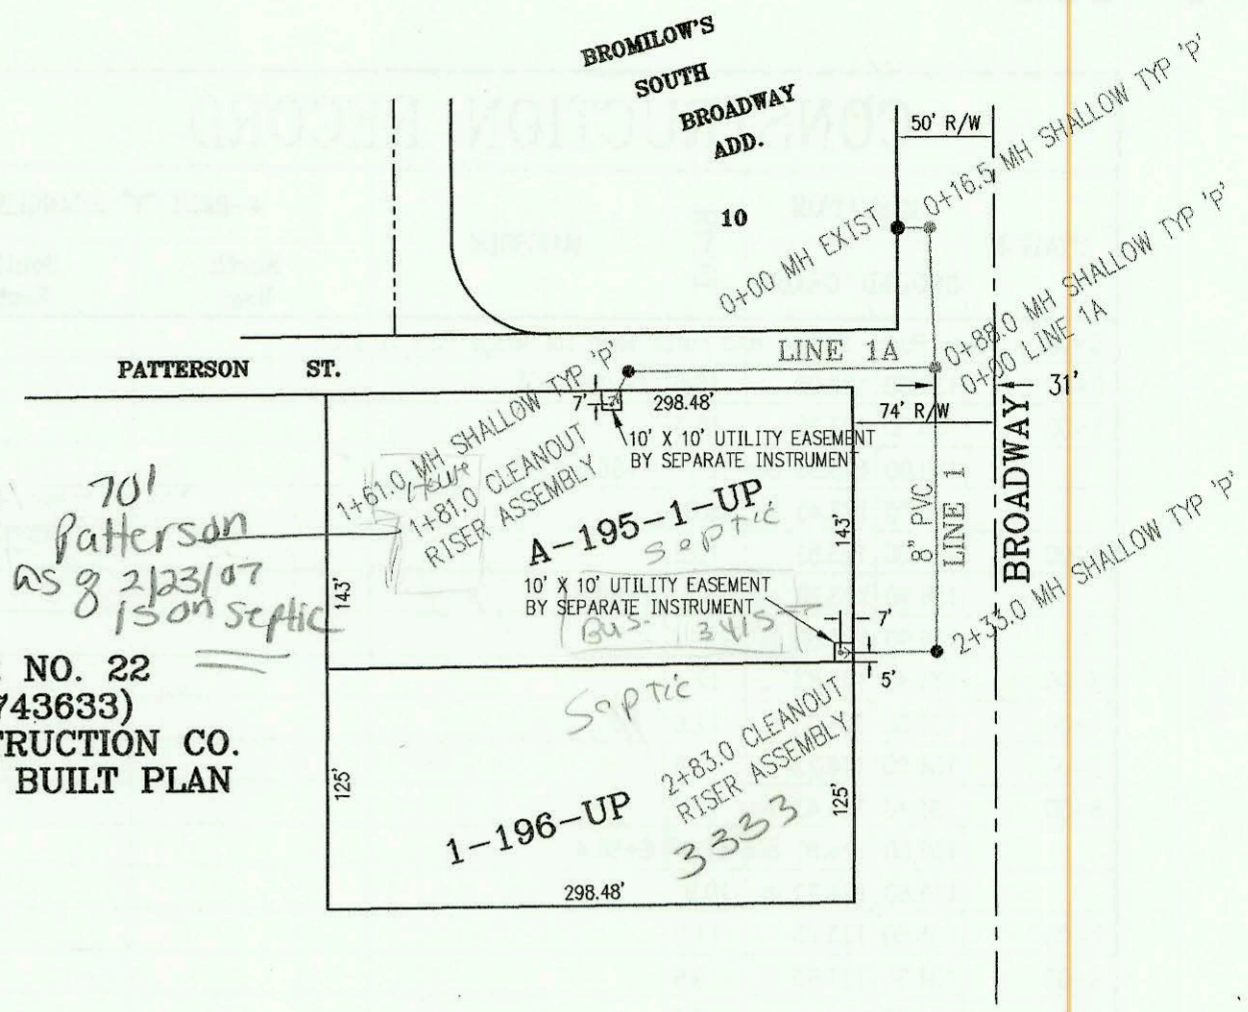

SCALE: 1" = 100'

LATERAL 159, SANITARY SEWER NO. 22
PROJECT NO. 468-82853 (743633)
BUILT BY W. B. CARTER CONSTRUCTION CO.
BOOKED 10/5/99 PER AS BUILT PLAN



CONSTRUCTION RECORD						SERVICE RECORD							
STATION	ELEVATION		DEPTH	MANHOLE	4-INCH "Y" BRANCHES		No. of Permit		House Number		DATE OF PERMITS		
	GROUND	GRADE			North West	South East	North West	South East	North West	South East	North West	South East	
LATERAL 400, SOUTHWEST INTERCEPTOR SEWER (CONT. FROM P-100)													
LINE 7B	0+00 L-7B	142.50	132.25	10.3	0+00 = 6+48.9 L-7								
	1+00	143.20	134.47 out	8.7	1+00.0	4" STUB S 134.80		2004 01793	3305 North Star		6-24-04		
		143.20	134.57 in	8.6									
	2+00												
		143.70	135.00	8.7	2+10.9 CLEANOUT RISER			2004 01434	2003 02055	3313 Northwind	3307 Northwind	5-20-04	1-22-03
LINE 8	0+00 L-8	140.00	131.20	8.8	0+00 = 55+20.0 L-3								
	1+00												
		141.70	131.52 out	10.2	1+05.0								
		141.70	131.62 in	10.1									
		141.90	131.90 out	10.0	1+96.0								
		141.90	132.00 in	9.9									
	2+00												
	3+00												
		142.40	132.33 out	10.1	3+05.9 = 0+00 L-8A								
		142.40	132.43 in	10.0									
	4+00	141.50	132.94	8.6				2004 01246	6005 Northwind		12-12-04		
	5+00	141.60	133.49	8.1									
		141.90	133.83 out	8.1	5+63.4								
		141.90	133.93 in	8.0									
	6+00	142.10	134.08	8.0									
	7+00												
		142.90	134.50	8.4	7+05.4	4" STUB W 134.85 4" STUB S 134.85		2004 01435	2003 02972	6017 Northwind	6013 Northwind	5-20-04	11-13-03
LINE 8A	0+00 L-8A	142.40	132.43	10.0	0+00 = 3+05.9 L-8								
	1+00	142.50	132.73	9.8									
	2+00	141.60	133.04	8.6									
		141.10	133.11 out	8.0	2+23.4	4" STUB S							
		141.10	133.21 in	7.9									
	3+00	140.20	133.45	6.8									
		140.90	133.51	7.4	3+26.0 CLEANOUT RISER								
LATERAL 159, SANITARY SEWER NO. 22													
	0+00 L-1	95.30	88.30	7.0	0+00 EXIST								
		95.30	88.40 out	6.9	0+16.5								
		96.30	88.50 in	7.8									
		94.50	88.75 out	5.8	0+88.0 = 0+00 L-1A								
		94.50	88.88 in	5.6									
	1+00	94.60	88.94	5.7									
	2+00	95.40	89.34	6.1									
		96.00	89.47 out	6.5	2+33.0								
		96.00	91.47 in	4.5									
		97.00	91.52	5.5	2+83.0 CLEANOUT RISER								
	0+00 L-1A	94.50	89.55	4.9	0+00 = 0+88.0 L-1			2001 00211	3415 Broadway	11-13-01			
	1+00	94.40	89.65	4.8									
		92.57	89.71 out	2.9	1+61.0								
		92.57	89.81 in	2.8									
		93.70	89.83	3.9	1+81.0 CLEANOUT RISER								