



LATERAL 32, MAIN 9, SANITARY SEWER NO. 23
PROJECT NO. 468-81835 (743816)
BUILT BY W. C. CARTER CONSTRUCTION CO.
BOOKED 2/17/00 PER PLAN

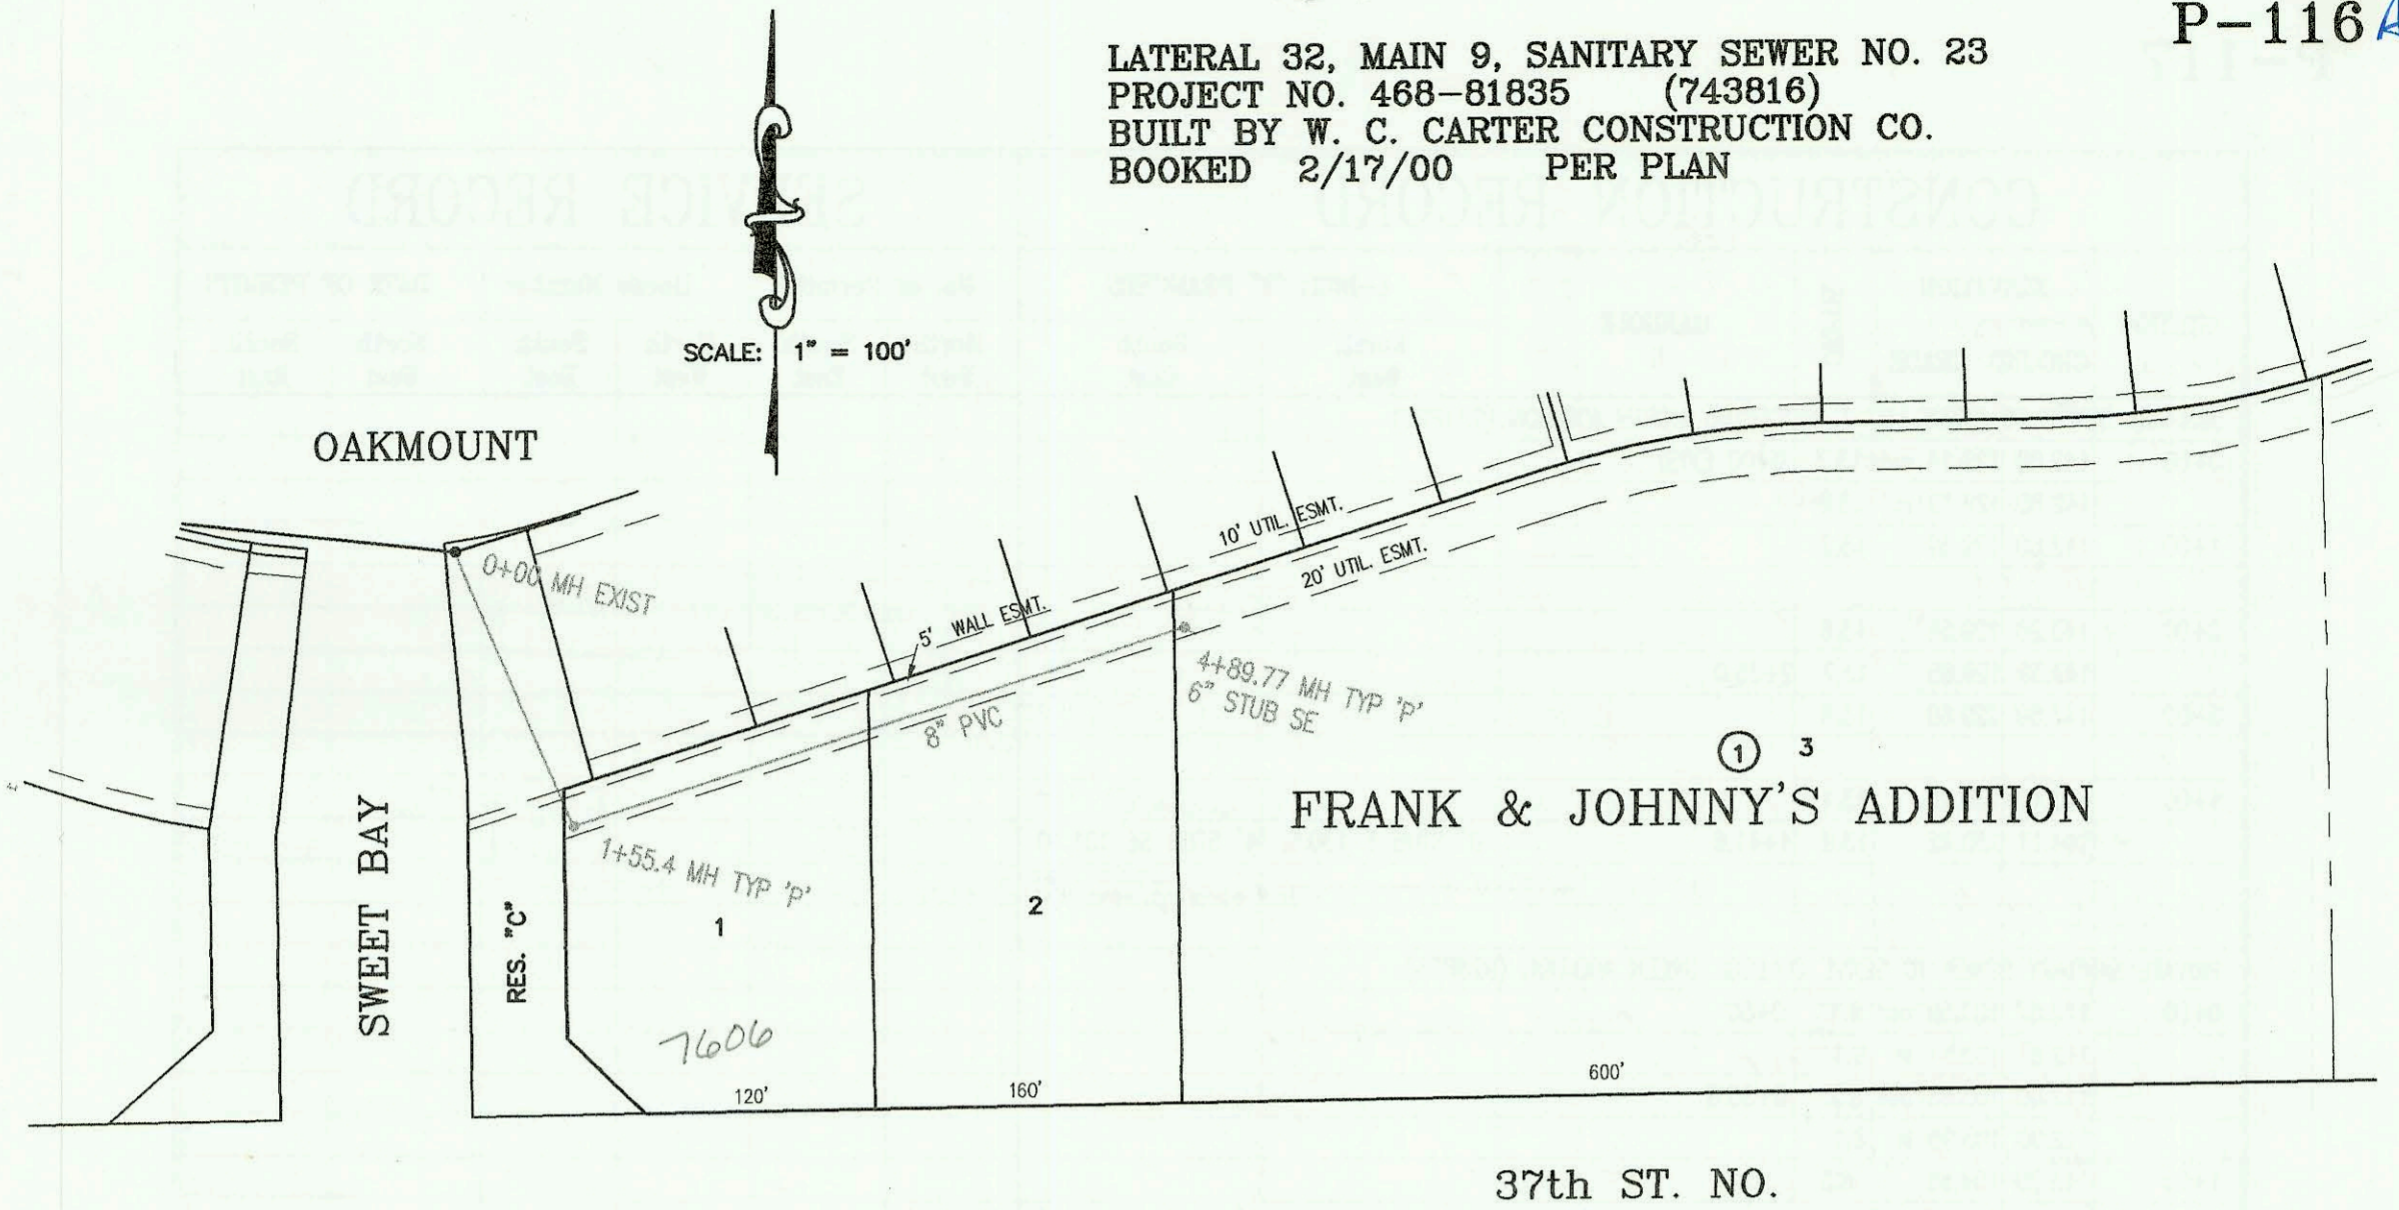

SANITARY SEWER RELOCATION TO SERVE
WEBB ROAD COMMERCIAL ADDITION
PROJECT NO. 940PPS
BUILT BY MIES CONSTRUCTION CO.
BOOKED 3/2/00 PER AS BUILT PLAN

21ST STREET NORTH

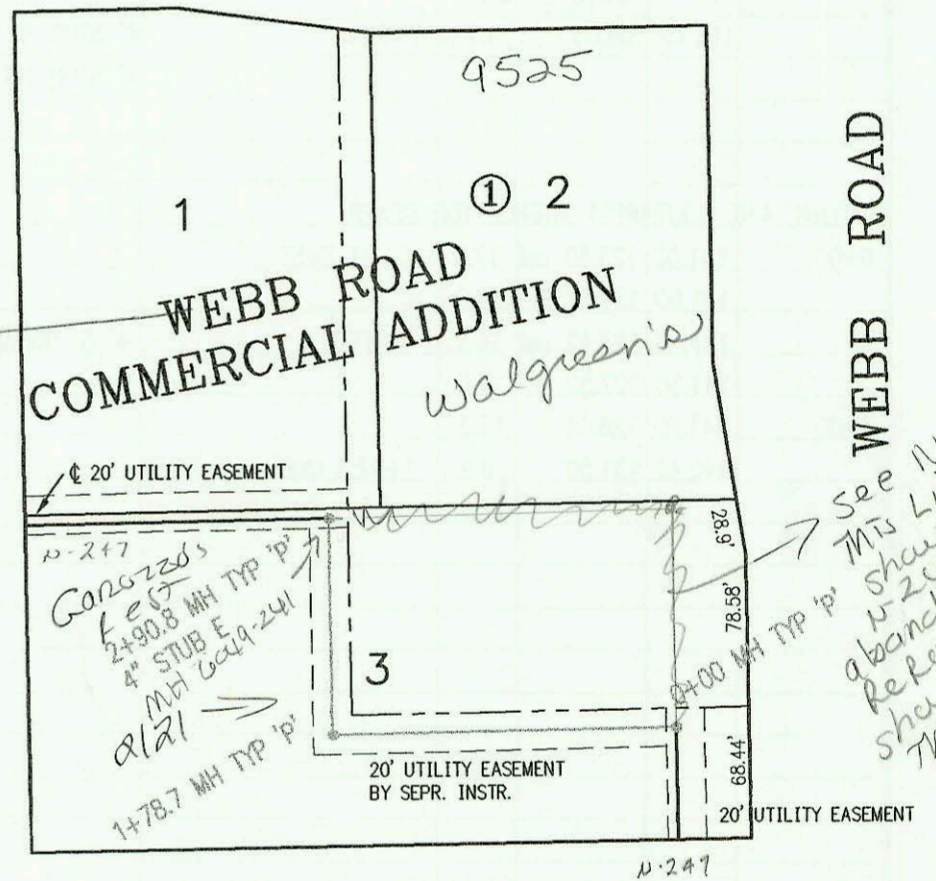


Replatted to Legacy Parc - within states

See U-247 MTS LHM P as abandoned related as shown on this drawing BK

SANITARY SEWER TO SERVE FIRST
UNITED PENTECOSTAL CHURCH
PROJECT NO. 878PPS
BUILT BY A. E. HENNING SEWER SERVICE
BOOKED 3/10/00 PER AS BUILT PLAN

MacARTHUR

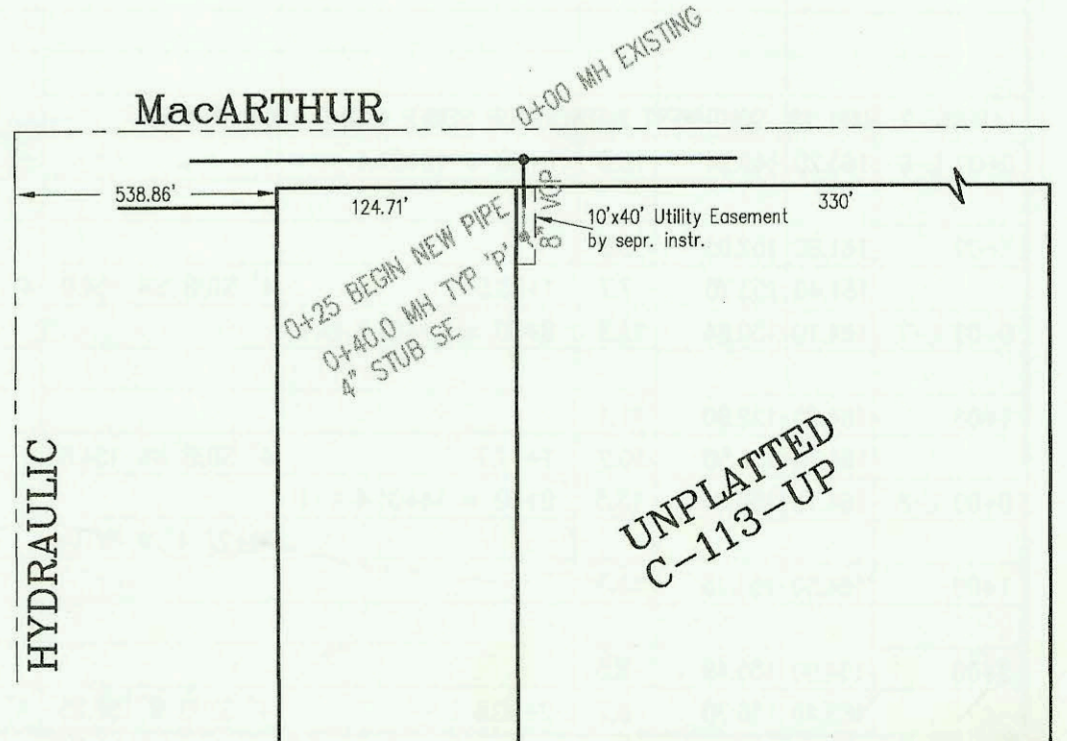

UNPLATTED
C-113-UP

CONSTRUCTION RECORD						SERVICE RECORD						
STATION	ELEVATION		DEPTH	MANHOLE	4-INCH "Y" BRANCHES		No. of Permit		House Number		DATE OF PERMITS	
	GROUND	GRADE			North West	South East	North West	South East	North West	South East	North West	South East
LATERAL 32,	MAIN 9,	SANITARY	SEWER	NO. 23								
0+00	192.73	182.95	9.8	0+00 EXIST								
1+00	193.40	183.35	10.1									
	193.35	183.57 out	9.8	1+55.4	4" STUB E 1+38		1999- 01152		7600 E 2717 N		11-9-99	
	193.35	183.67 in	9.7									
2+00	193.20	183.85	9.3									
3+00	193.90	184.25	9.7									
4+00	194.80	184.65	10.2									
	196.30	185.01	11.3	4+89.77	6" STUB SE 185.18							
SANITARY SEWER RELOCATION TO SERVE WEBB ROAD COMMERCIAL ADDITION (940PPS)												
0+00	201.51	187.98 out	13.5	0+00								
	201.51	187.95 in	13.6									
1+00	201.60	188.19	13.4									
	202.04	188.37 out	13.7	1+78.7								
	202.04	188.44 in	13.6									
2+00	202.40	188.50	13.9									
	204.30	188.77 out	15.5	2+90.8	4" STUB E 4" SCH 40		2000- 00454		9525 E 2151 N		2-17-00	
	204.30	188.94 in	15.4									
SANITARY SEWER TO SERVE FIRST UNITED PENTECOSTAL CHURCH (878PPS)												
0+00	85.20	72.99 out	12.2	0+00 EXIST								
	85.20	75.83 in	9.4									
	86.30	76.20	10.1	0+40.0	4" STUB SE 76.48							