



LATERAL 2, MIAN 18, SOUTHWEST INTERCEPTOR SEWER
 PROJECT NO. 468-82563 (743812)
 BUILT BY K.C. EXCAVATING, INC..
 BOOKED 3/22/00 PER PLAN

P-118A

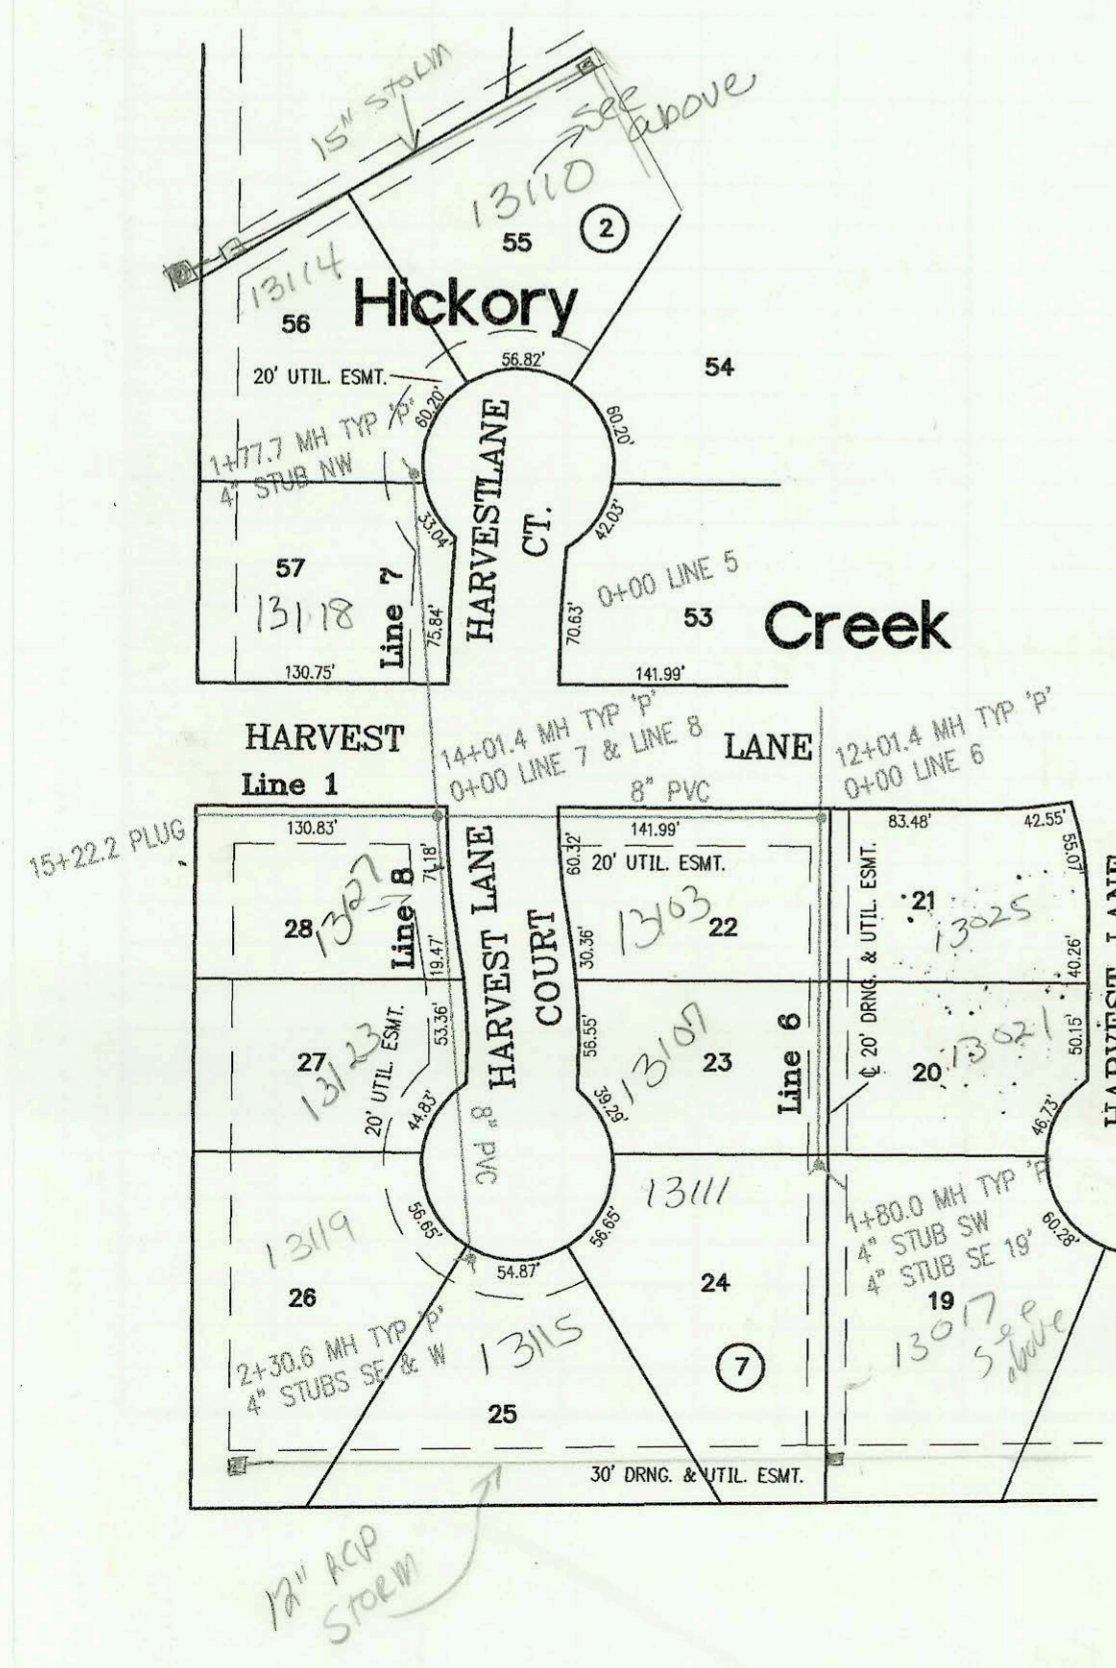

Refer to
 STORM BOOK
 D-478 ON
 THIS AREA
 BSK
 3/16/01

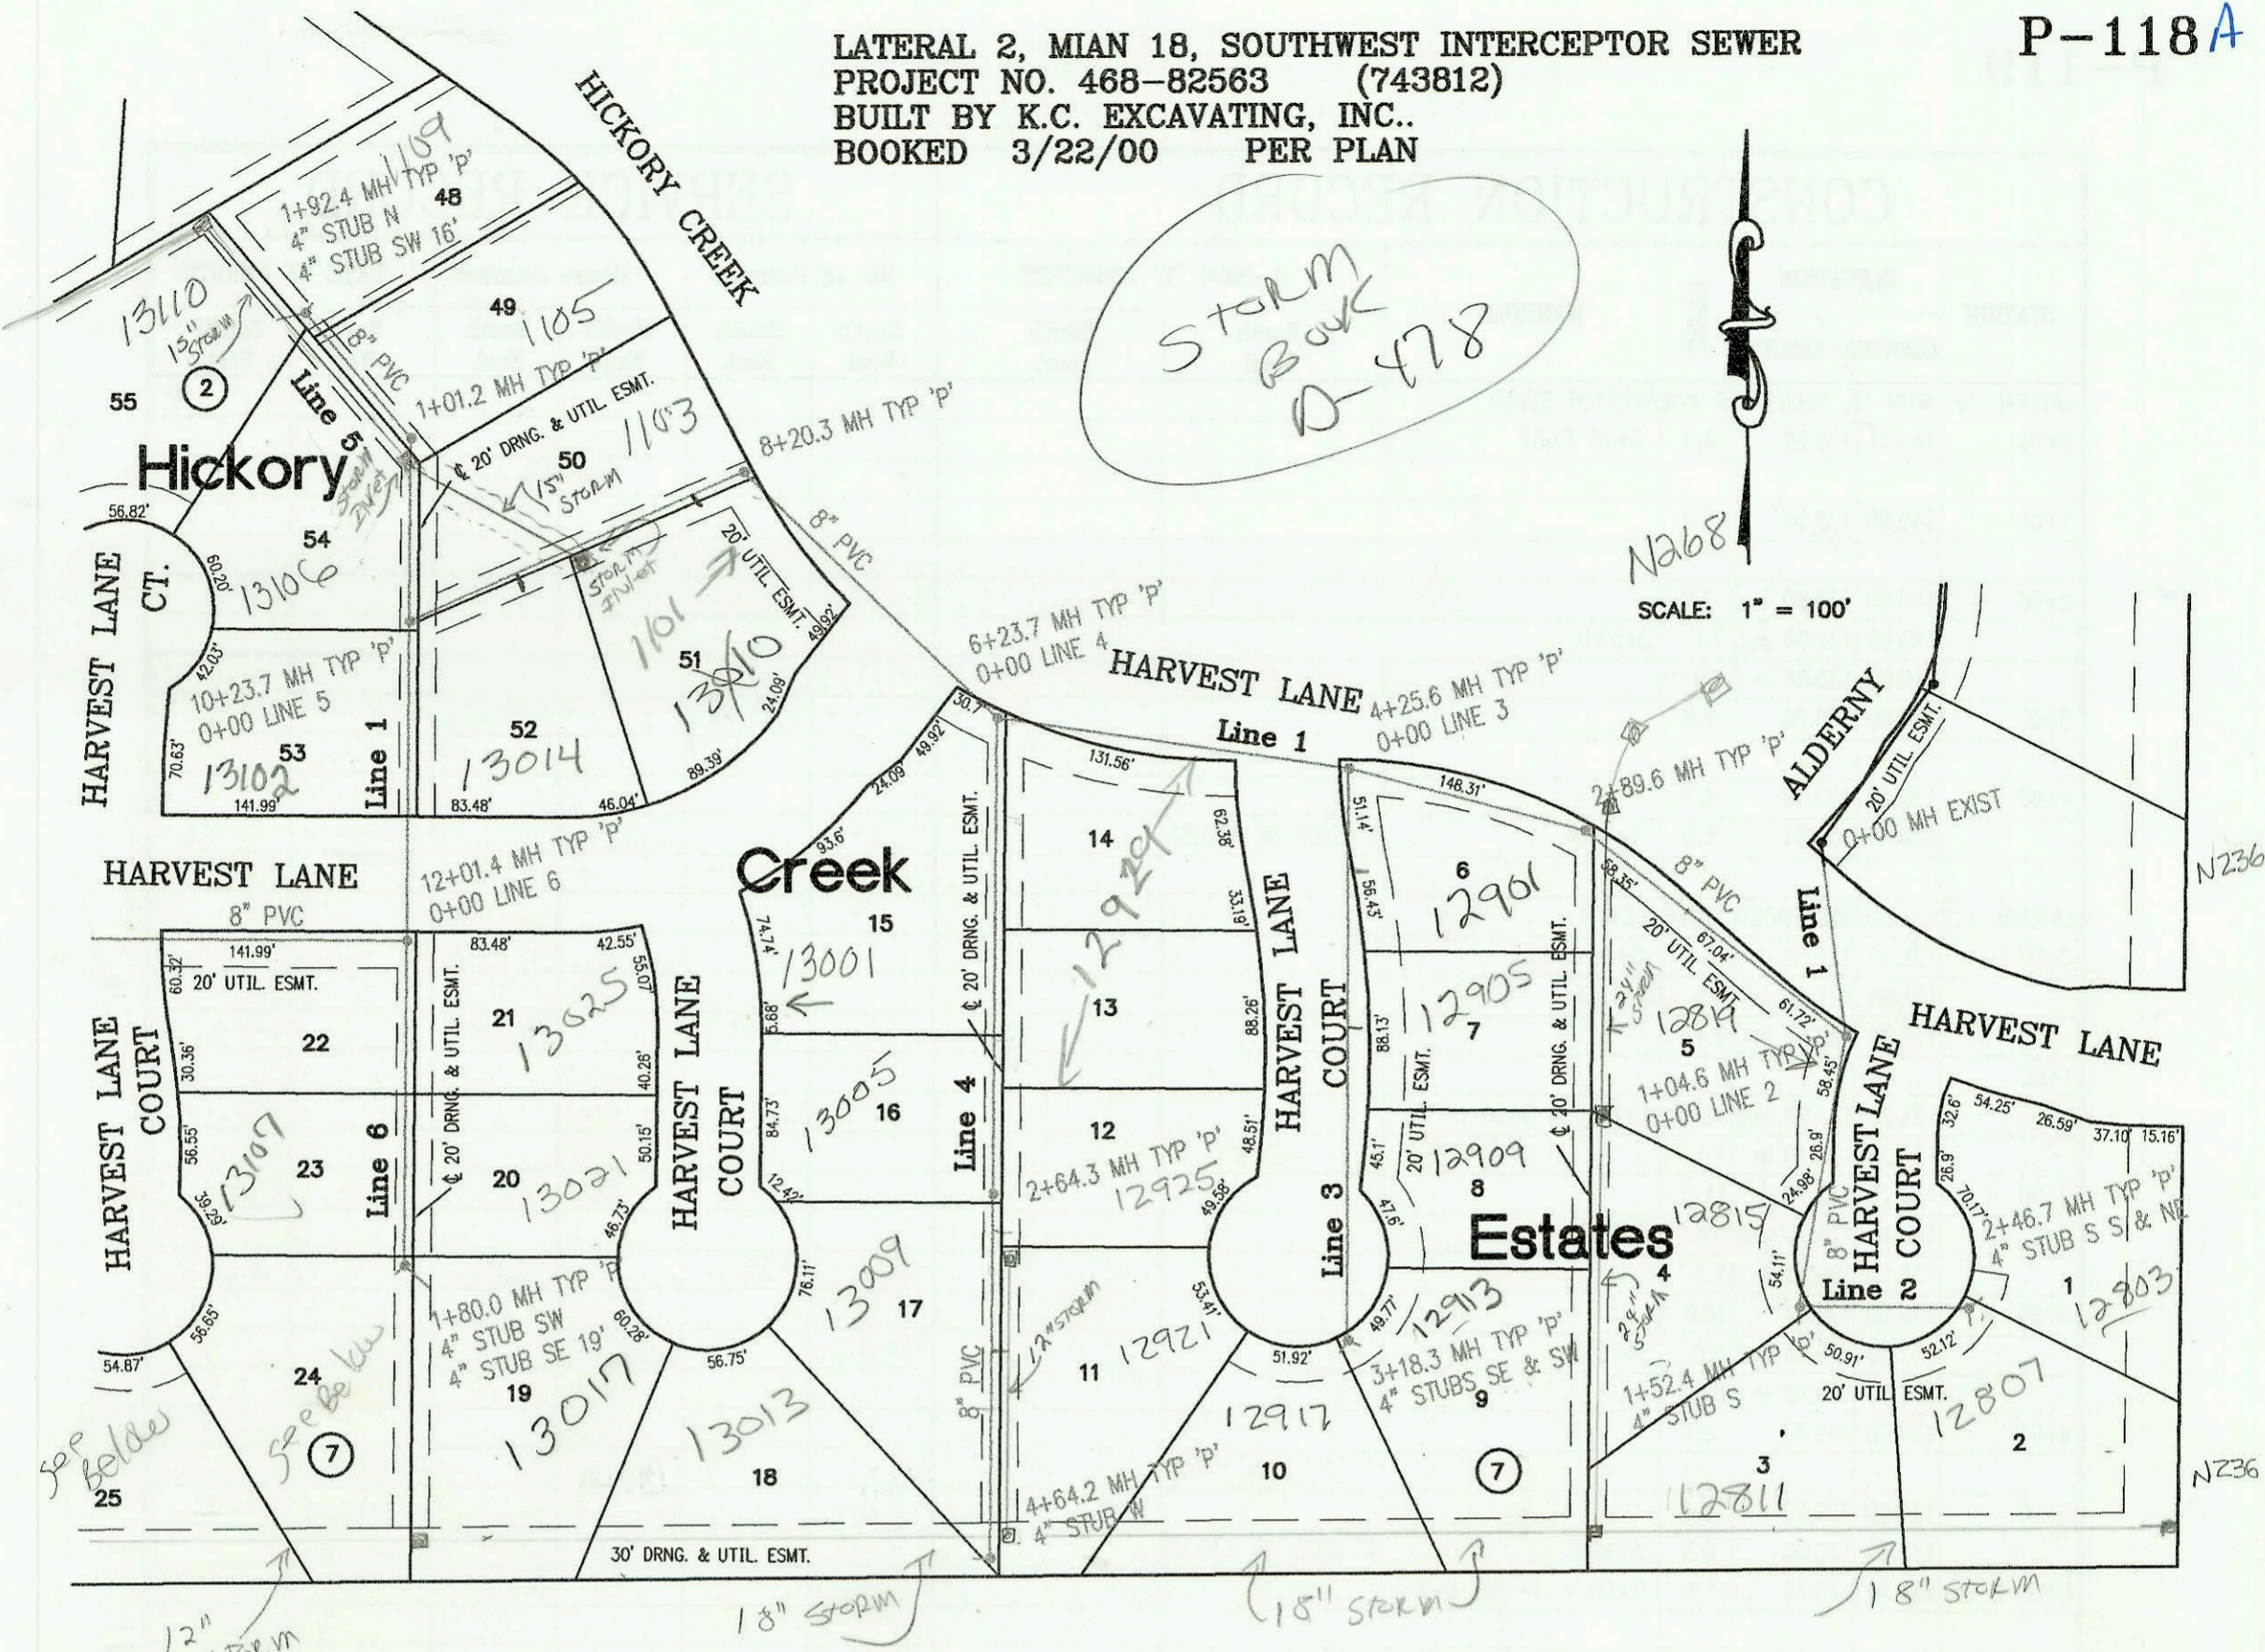