

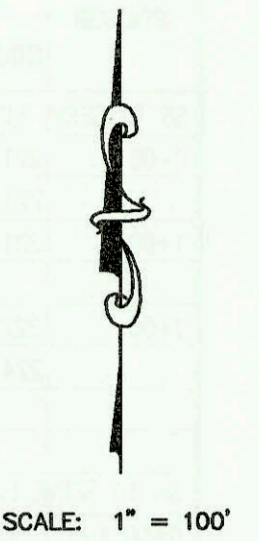
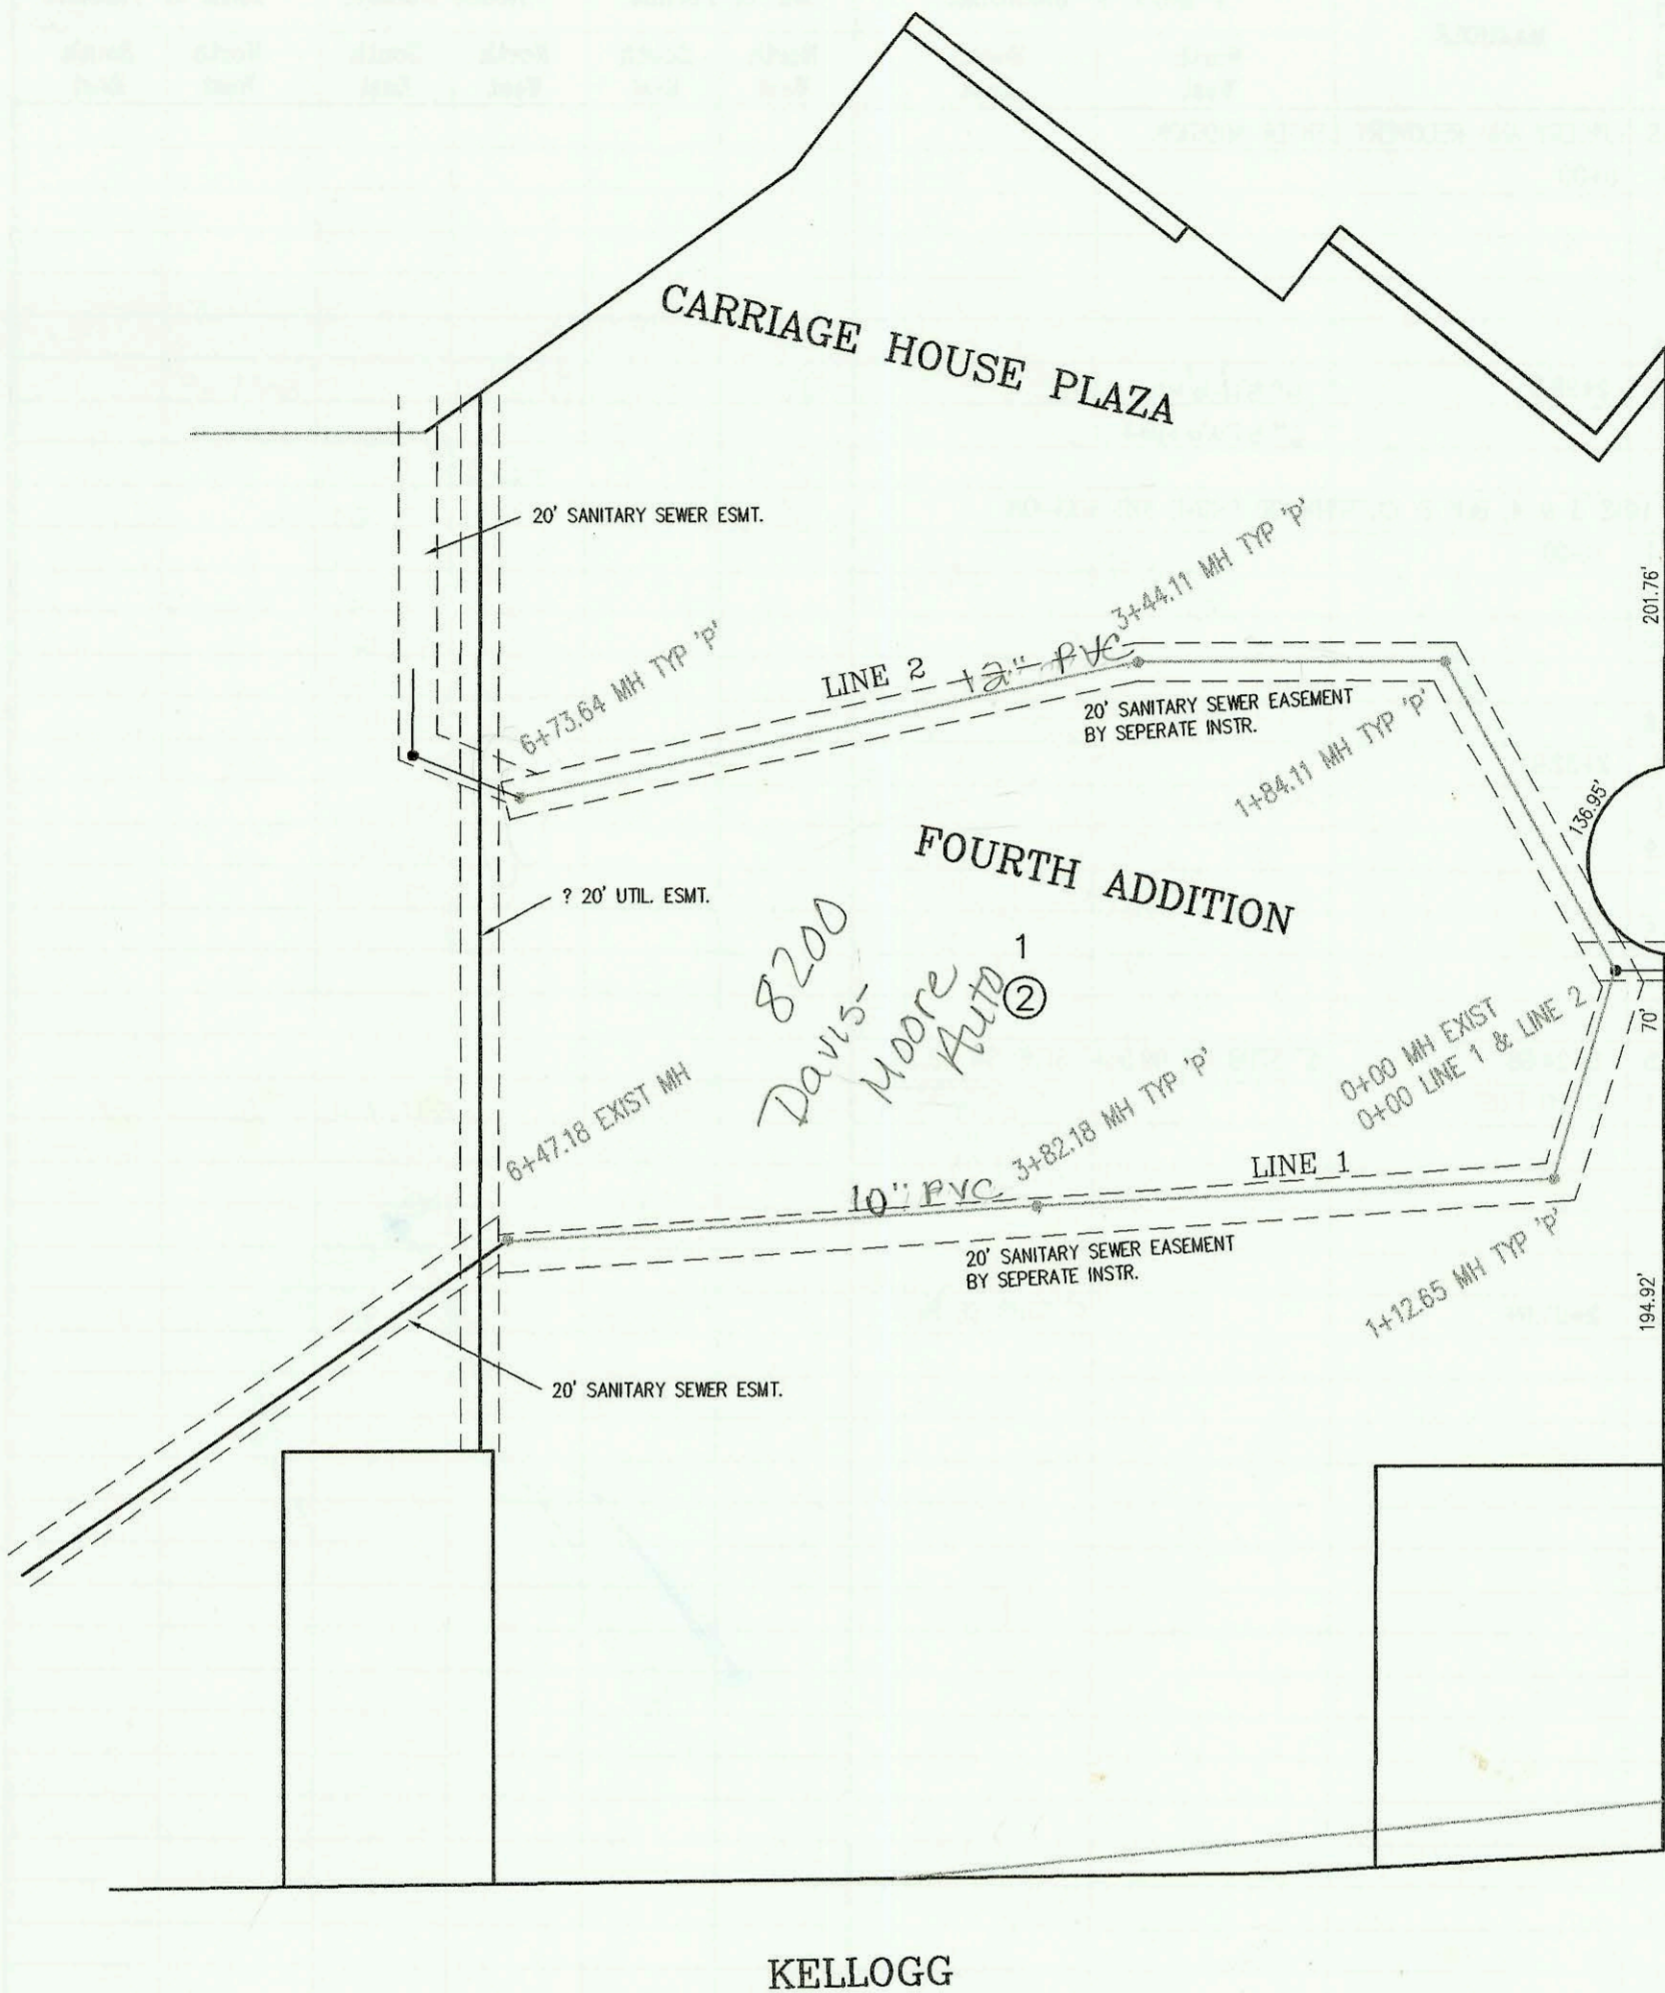


SANITARY SEWER TO SERVE LOT 2, BLK. 1,
CARRIAGE HOUSE PLAZA FOURTH ADDITION
PROJECT NO. 949PPS
BUILT BY UTILITY CONTRACTORS INC.
BOOKED 04/06/00 PER AS BUILT PLAN

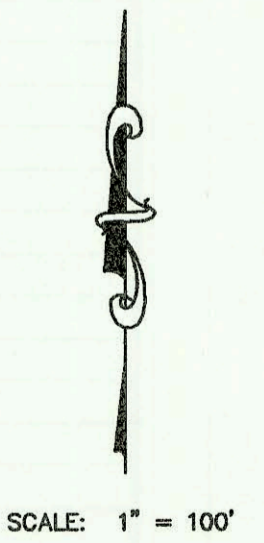

KELLOGG

PRIV. SANITARY SEWER TO SERVE LOT 1, BLK 1,
WILLOWOOD ESTATES (PHASE 2)
PROJECT NO. 829PPS
BUILT BY A-PLUS PLUMBING
BOOKED 4/12/00 PER AS BUILT PLAN

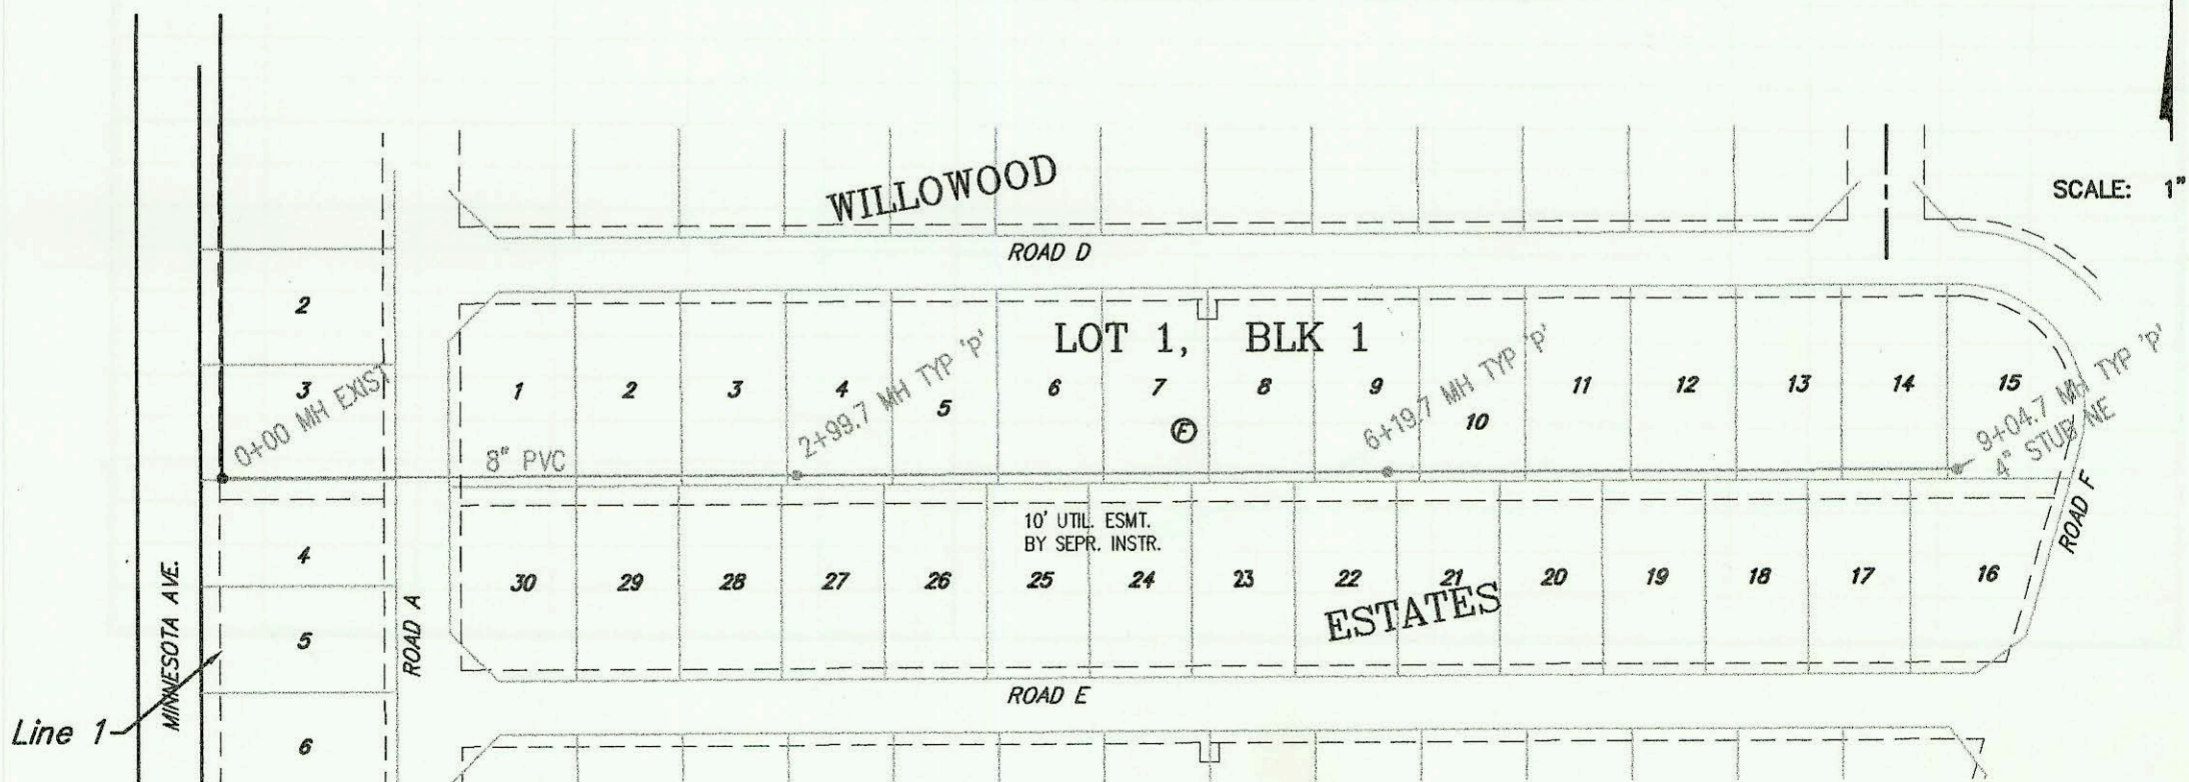

CONSTRUCTION RECORD						SERVICE RECORD						
STATION	ELEVATION		DEPTH	MANHOLE	4-INCH "Y" BRANCHES		No. of Permit		House Number		DATE OF PERMITS	
	GROUND	GRADE			North West	South East	North West	South East	North West	South East	North West	South East
SANITARY SEWER TO SERVE LOT 2, BLK 1, CARRIAGE HOUSE PLAZA 4TH ADDITION												
0+00 L-1	141.00	130.67	10.3	0+00 EXIST = 0+00 L-1								
1+00	142.70	130.91	11.8									
	142.73	130.94	11.8	1+12.65								
2+00	142.80	131.15	11.7									
3+00	142.20	131.39	10.8									
	141.60	131.61	10.0	3+82.18								
4+00	139.70	131.64	8.1									
5+00	139.30	131.80	7.5									
6+00	139.80	131.99	7.8		4" CAST IRON 6+27.18	Hub + Spigot TAP	2000-00693	8200 W Kellogg	See Below	3-15-00		
	140.20	132.17	8.0	6+47.18								
0+00 L-2	141.00	130.53	10.5	0+00 EXIST = 0+00 L-1								
1+00	142.60	130.72	11.9									
	142.30	130.89	11.4	1+84.11								
2+00	142.70	130.92	11.8									
3+00	142.90	131.11	11.8									
	142.30	131.20	11.1	3+44.11								
4+00	138.70	131.29	7.4									
5+00	138.30	131.45	6.9									
6+00	138.80	131.60	7.2									
	144.10	131.70	12.4	6+73.64	4" CAST IRON 6+52.64	Hub + Spigot TAP	2000-00689	8200 W Kellogg		3-15-00		
PRIV. SANITARY SEWER TO SERVE LOT 1, BLK 1, WILLOWOOD ESTATES (PHASE 2)												
0+00	86.80	78.07	8.7	0+00 EXIST								
1+00	86.20	78.42	7.8									
2+00	87.60	78.77	8.8									
	88.07	79.12	8.9	2+99.7								
3+00												
4+00	87.80	79.43	8.4									
5+00	87.30	79.73	7.6									
6+00	86.70	80.04	6.7									
	86.74	80.10	6.6	6+19.7								
7+00	86.60	80.33	6.3									
8+00	86.50	80.63	5.9									
9+00												
	86.06	80.93	5.1	9+04.7	4" STUB NE 81.07							
NOTE:	SWR 2000-00693-8200 W Kellogg- 3/15/00- Prof. Mech. Cont- + used 4" Precho + 4" Saddle - South Sewer						Hub + Spigot 20' E Cast Iron - DL tapped into PVC Main					